


03-00-095-116-015

03-00-095-13
Scan # 45338

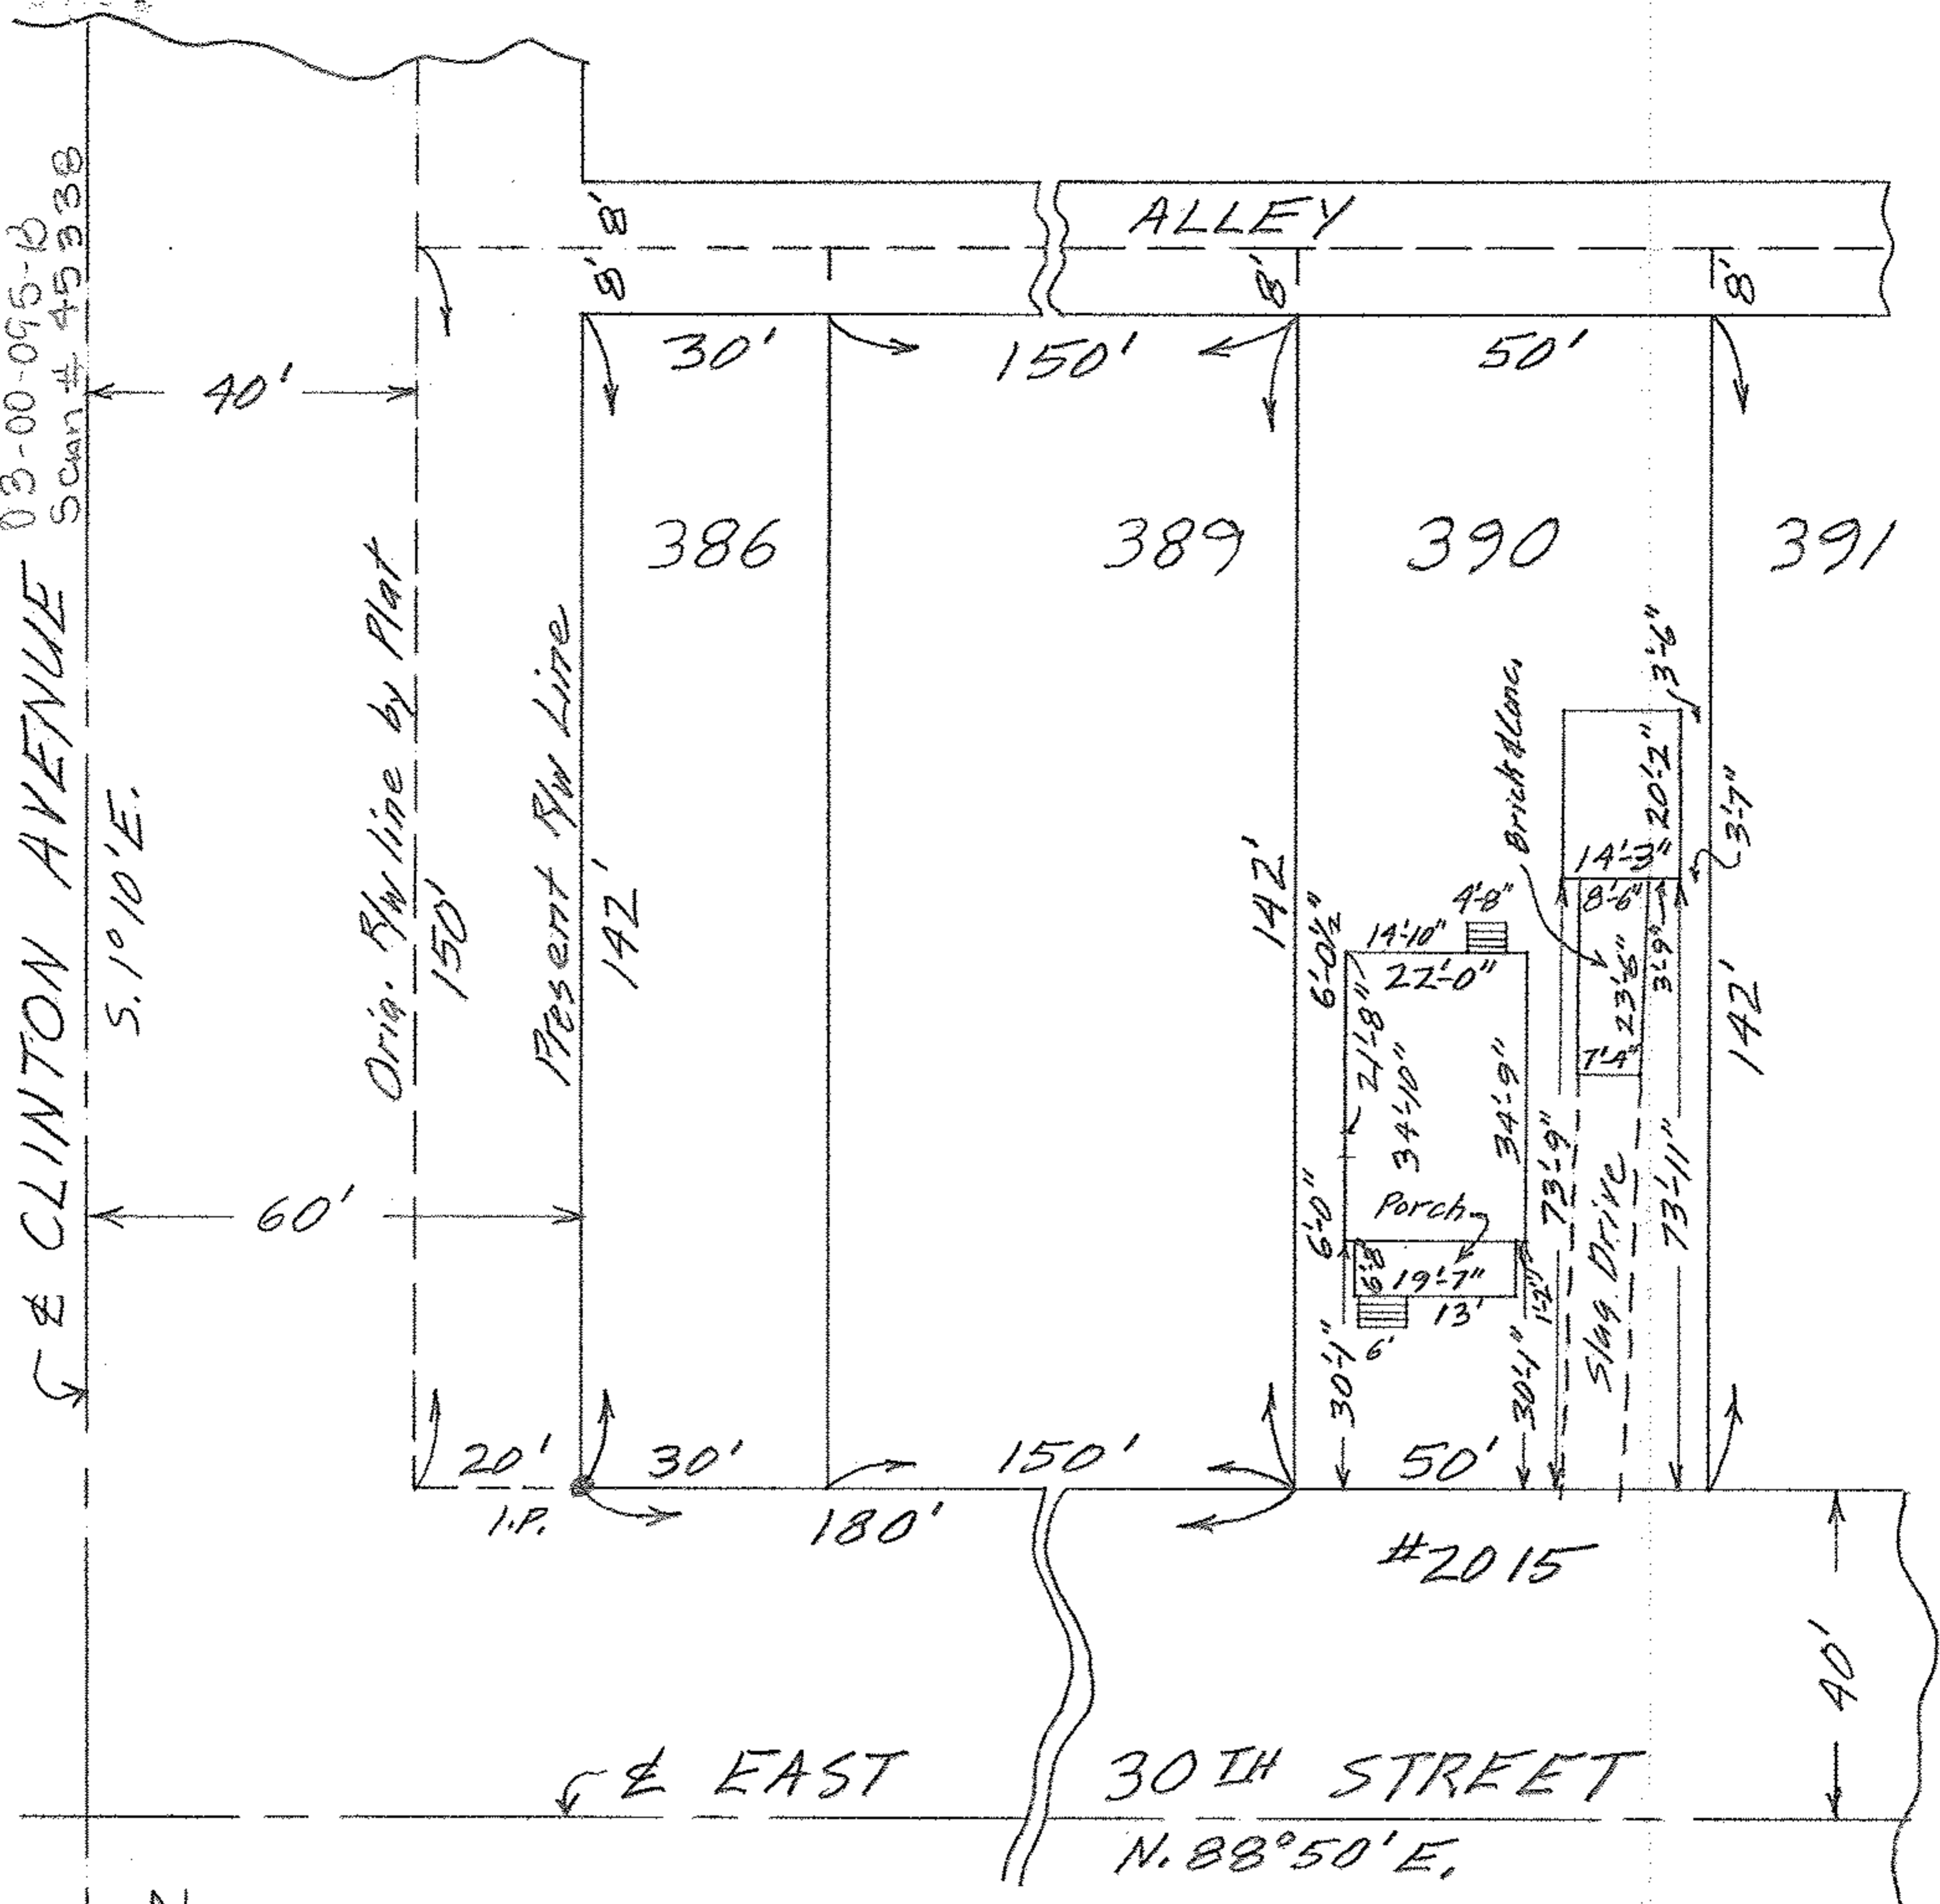

MAP OF SOUTHERLY 142 FEET OF
 SUB-LOT NO. 390 OF THE SHEFFIELD
 LAND CO.'S SUB'N. NO. 1 - Vol. A Pgs. 23 & 24
 ORIG. LOT 95 SHEFFIELD TWP.
 LORAIN CITY - LORAIN CO. - OHIO
 SCALE: 1" = 30' AUG. 11-1964 5:45 P.M.
 Gary E. Penfound REG. SURVEYOR
 Santos & Julia C. Romero

03-00-095 WW