


03-00-098-124-016
03-00-098-B
Scan # 45343

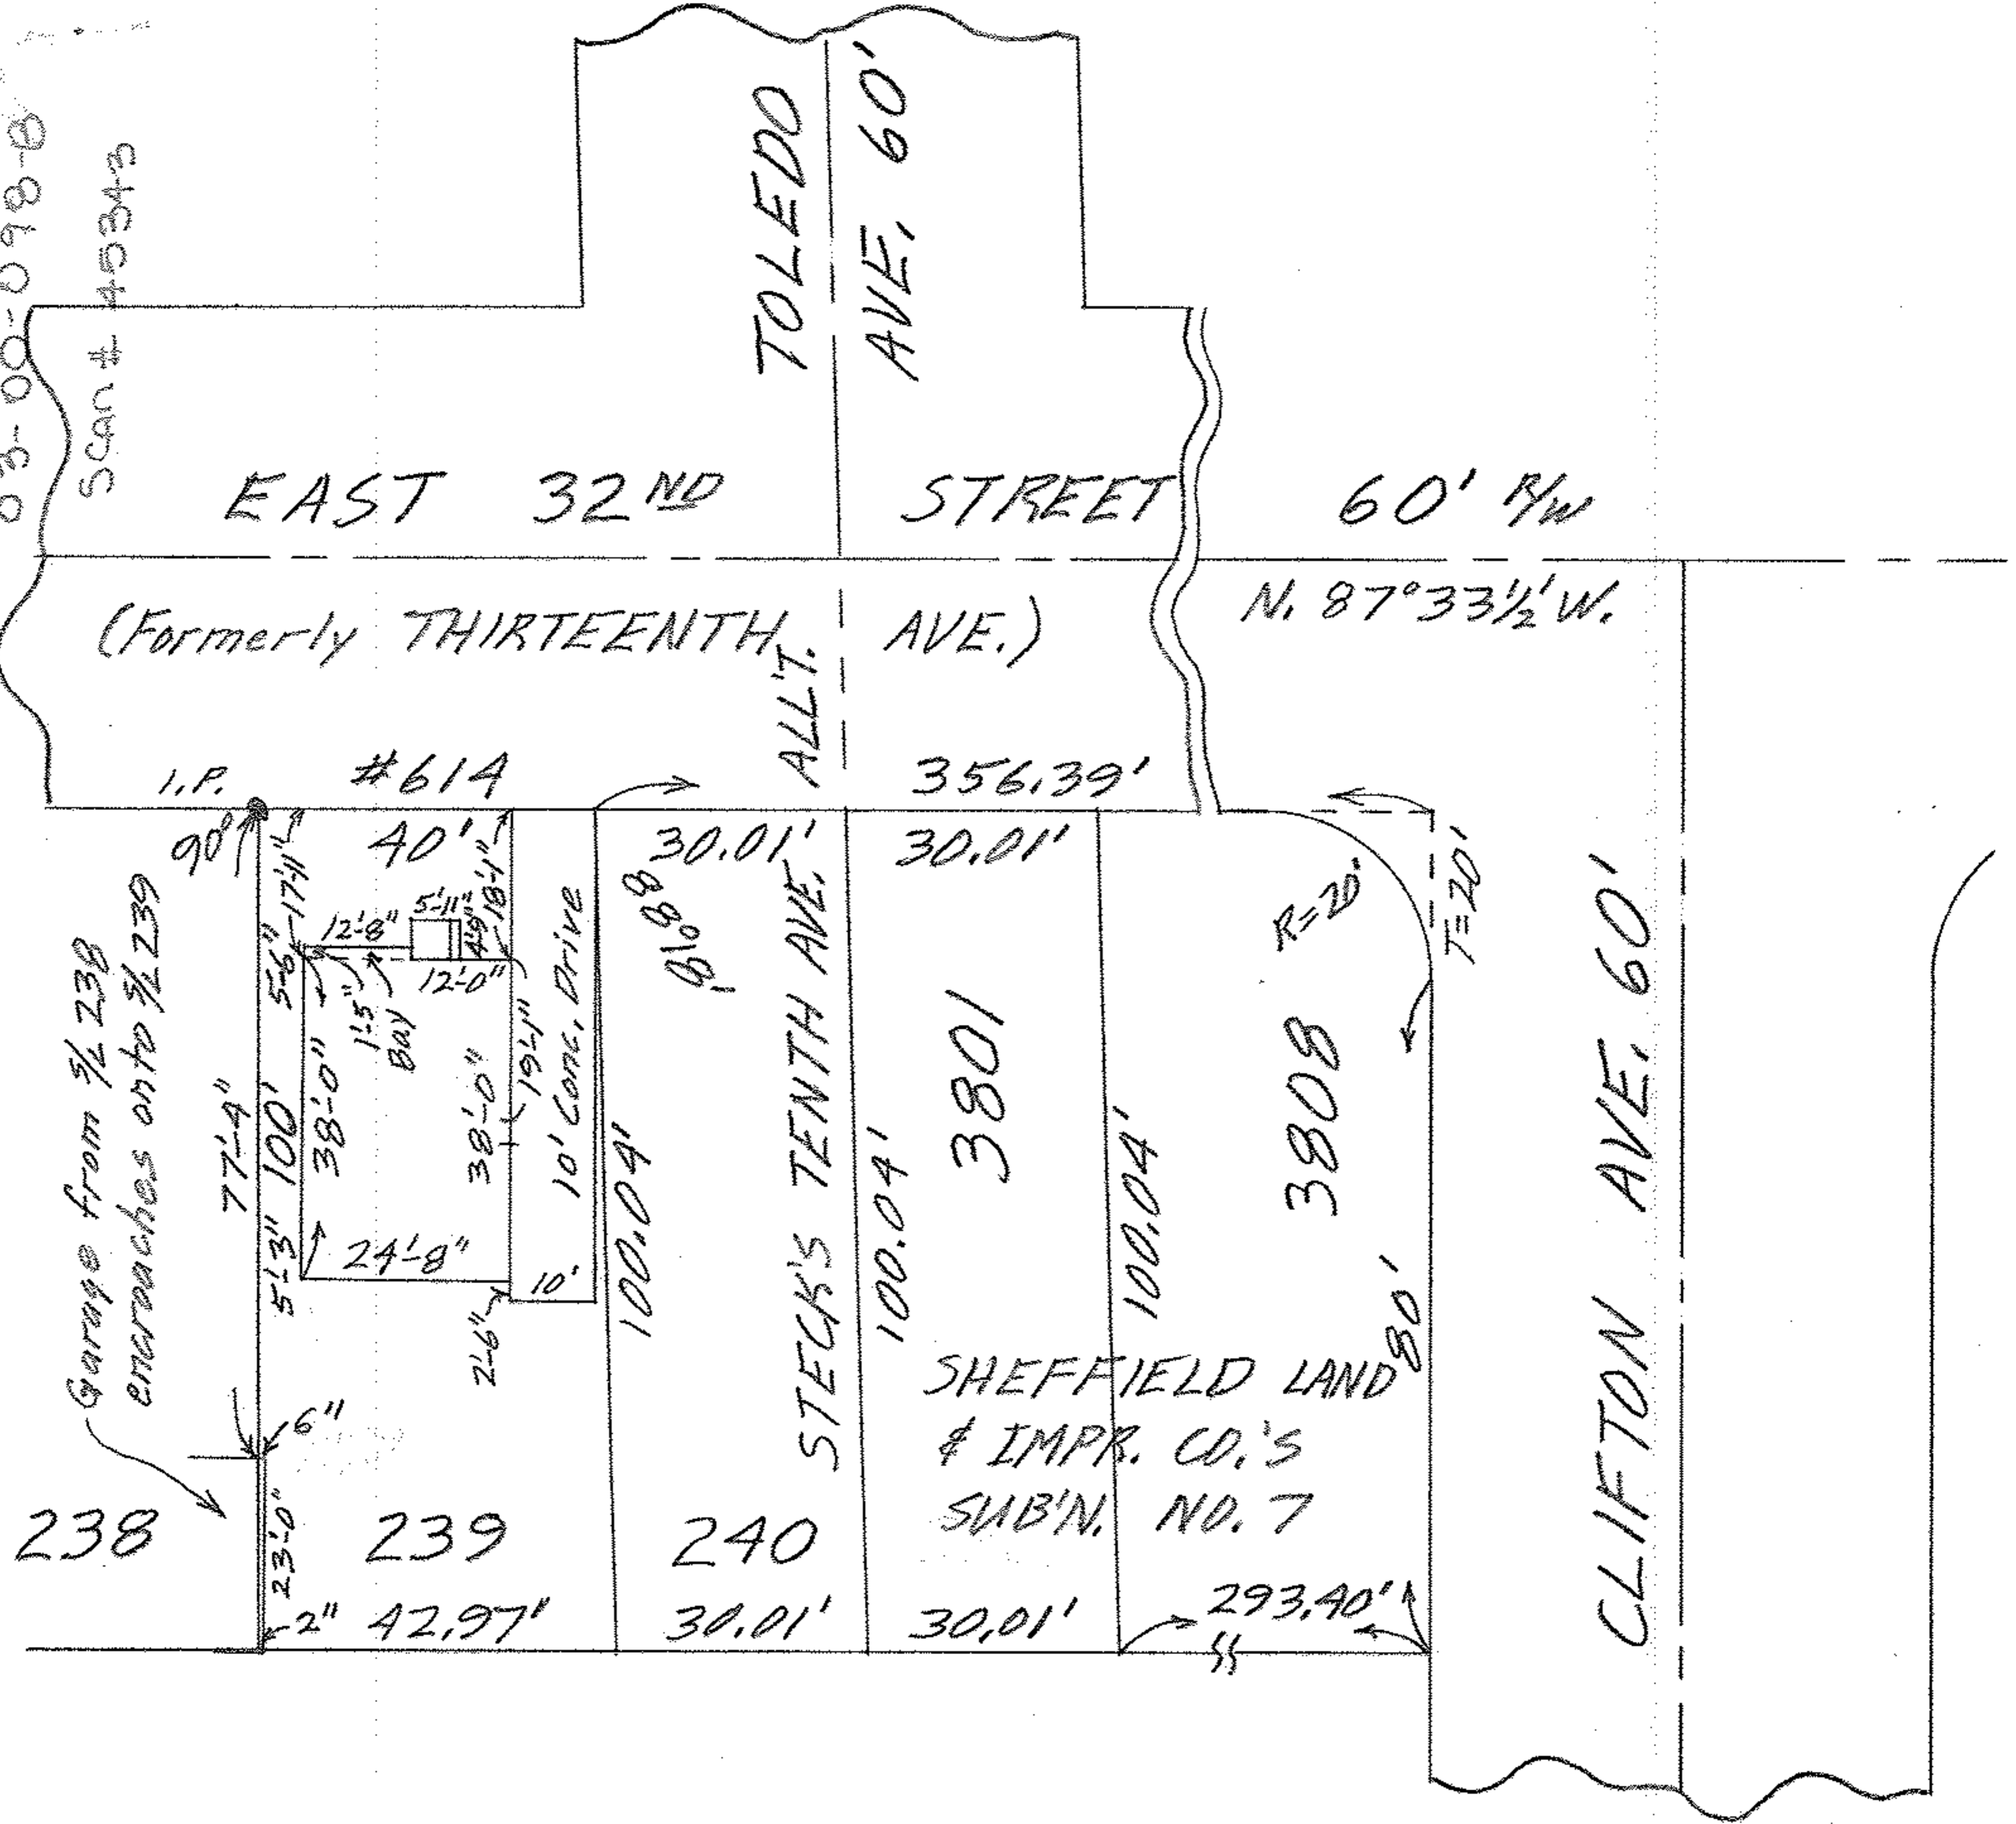

MAP OF SUB-LOT NO. 239

STECK'S TENTH AVE. ALL'T. Vol. 6 Pg. 17

ORIG. LOT 98 SHEFFIELD TWP.

LORAIN CITY - LORAIN COUNTY - OHIO

SCALE: 1" = 30' OCT. 31-1964 5:00 P.M.

Mary E. Penfound REG. SURVEYOR

Jesus M. & Fermina Lopez

