


03-00-099-114-003
 03-00-099-B
 Scan # 45349

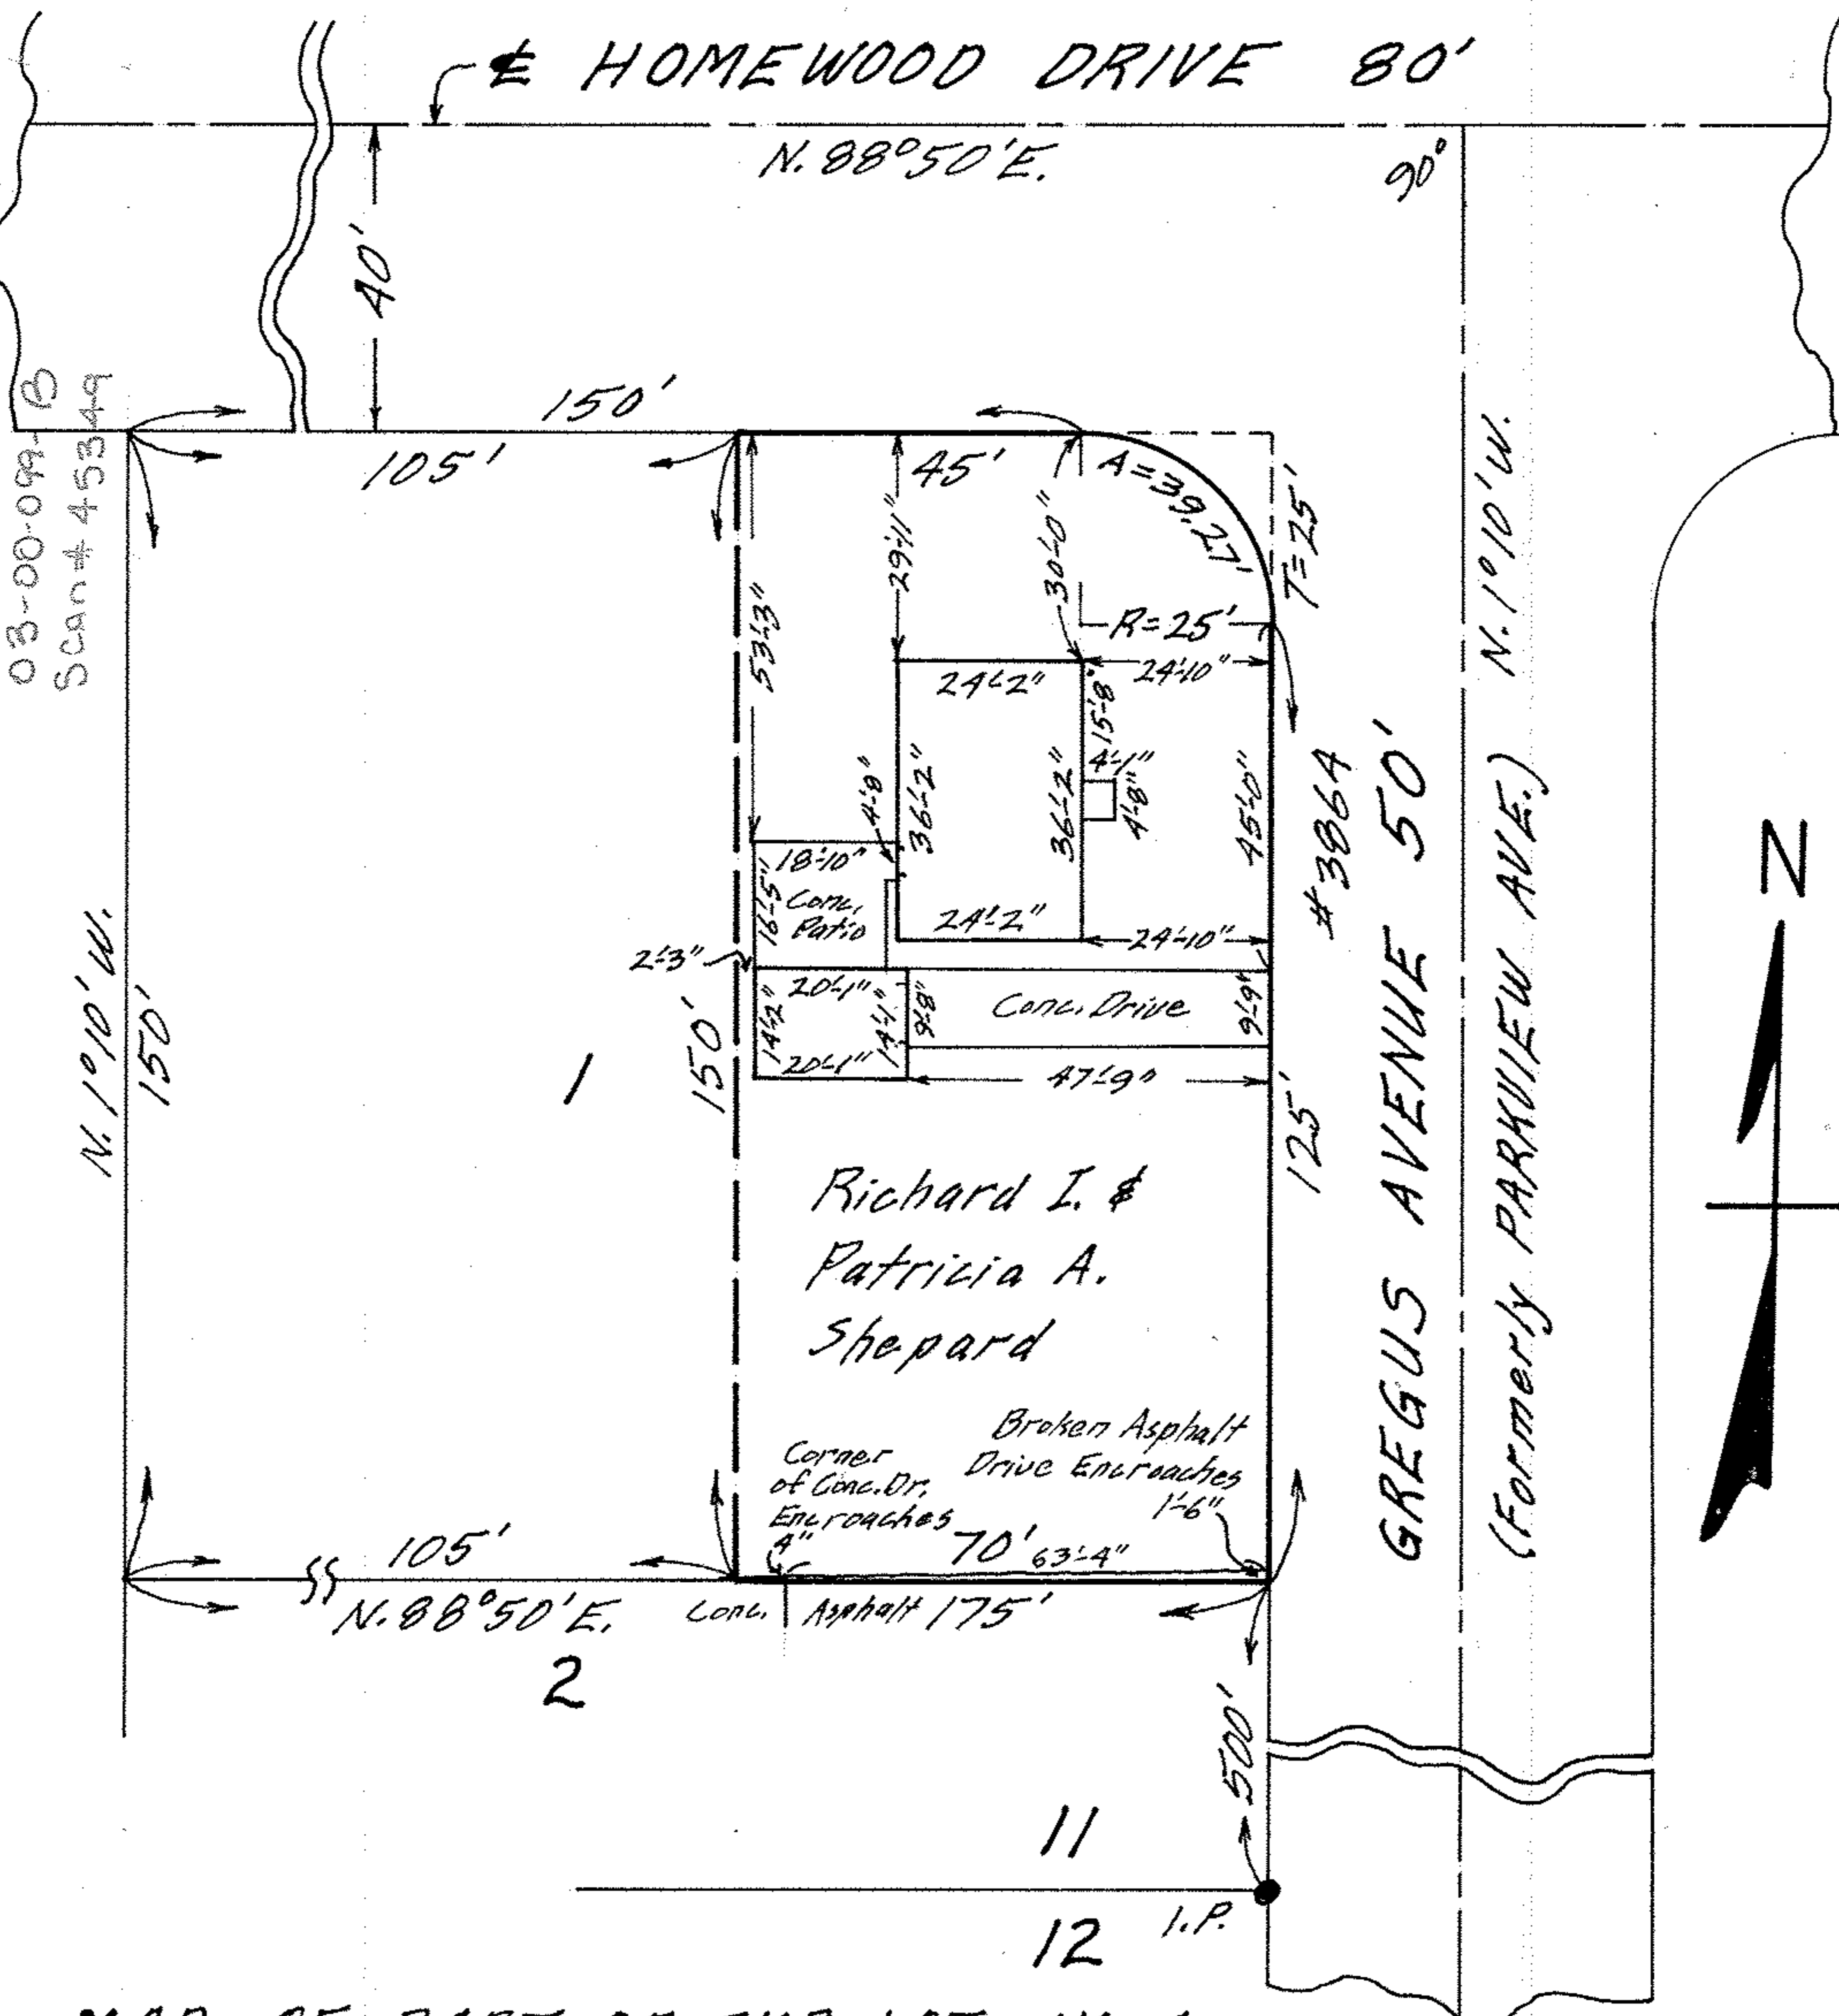

MAP OF PART OF SUB-LOT NO. 1
 HOMEWOOD ADD'N. VOL. 14 Pgs. 22 & 23
 ORIG. LOT 99 SHEFFIELD TWP.
 LORAIN CITY - LORAIN COUNTY - OHIO
 SCALE: 1" = 30' AUG. 15 - 1968 4:00 P.M.
 Gary E. Penfound REG. SURVEYOR