


D3-00-100-107-001  
 03-00-100-B  
 SCAN # 45355

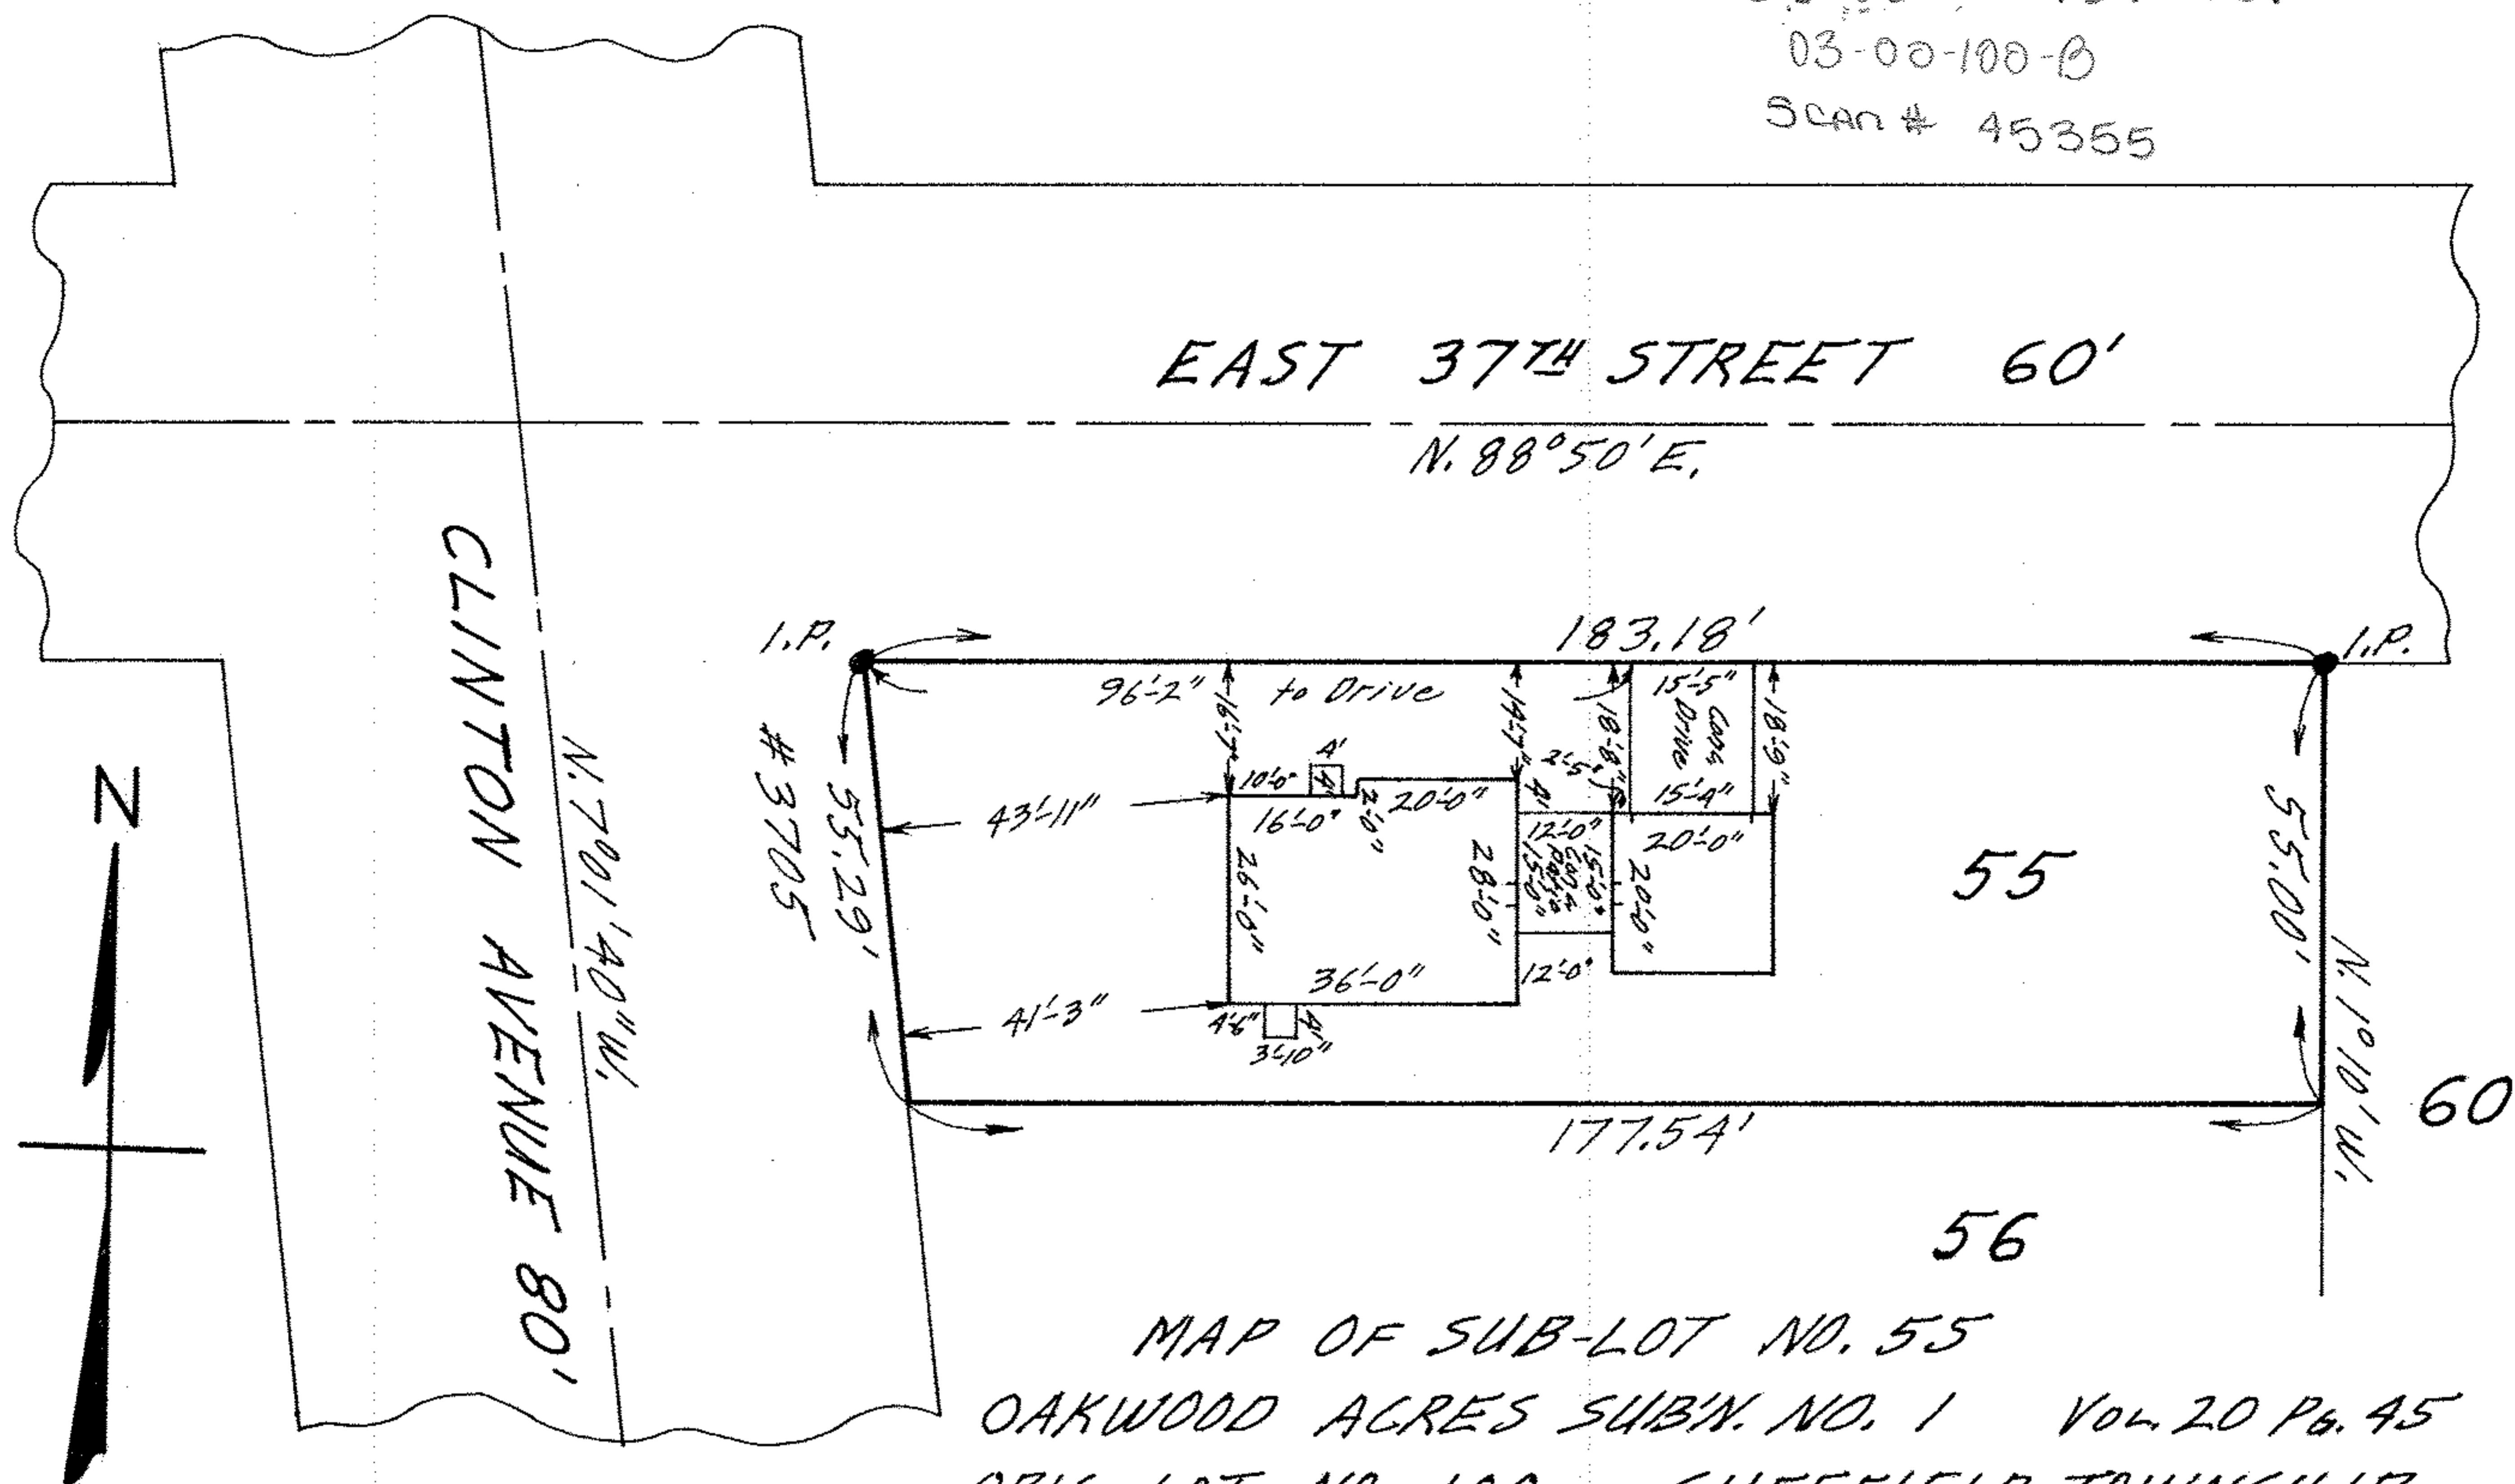

MAP OF SUB-LOT NO. 55  
 OAKWOOD ACRES SUB'D. NO. 1 Vol. 20 Pg. 45  
 ORIG. LOT NO. 100 SHEFFIELD TOWNSHIP  
 LORAIN CITY - LORAIN COUNTY - OHIO  
 SCALE: 1" = 30' SEPT. 15-1970 4:00 P.M.  
 NOTE: There are no encroachments on this property.  
 Gary E. Penfound REG. SURVEYOR NO. 4457  
 CITY TITLE Co. Order No. E-1304-5 Pope to Cruz  
 03-00-100