


03-00-103-124-015-9017
03-00 103-B
SCAN # 45361

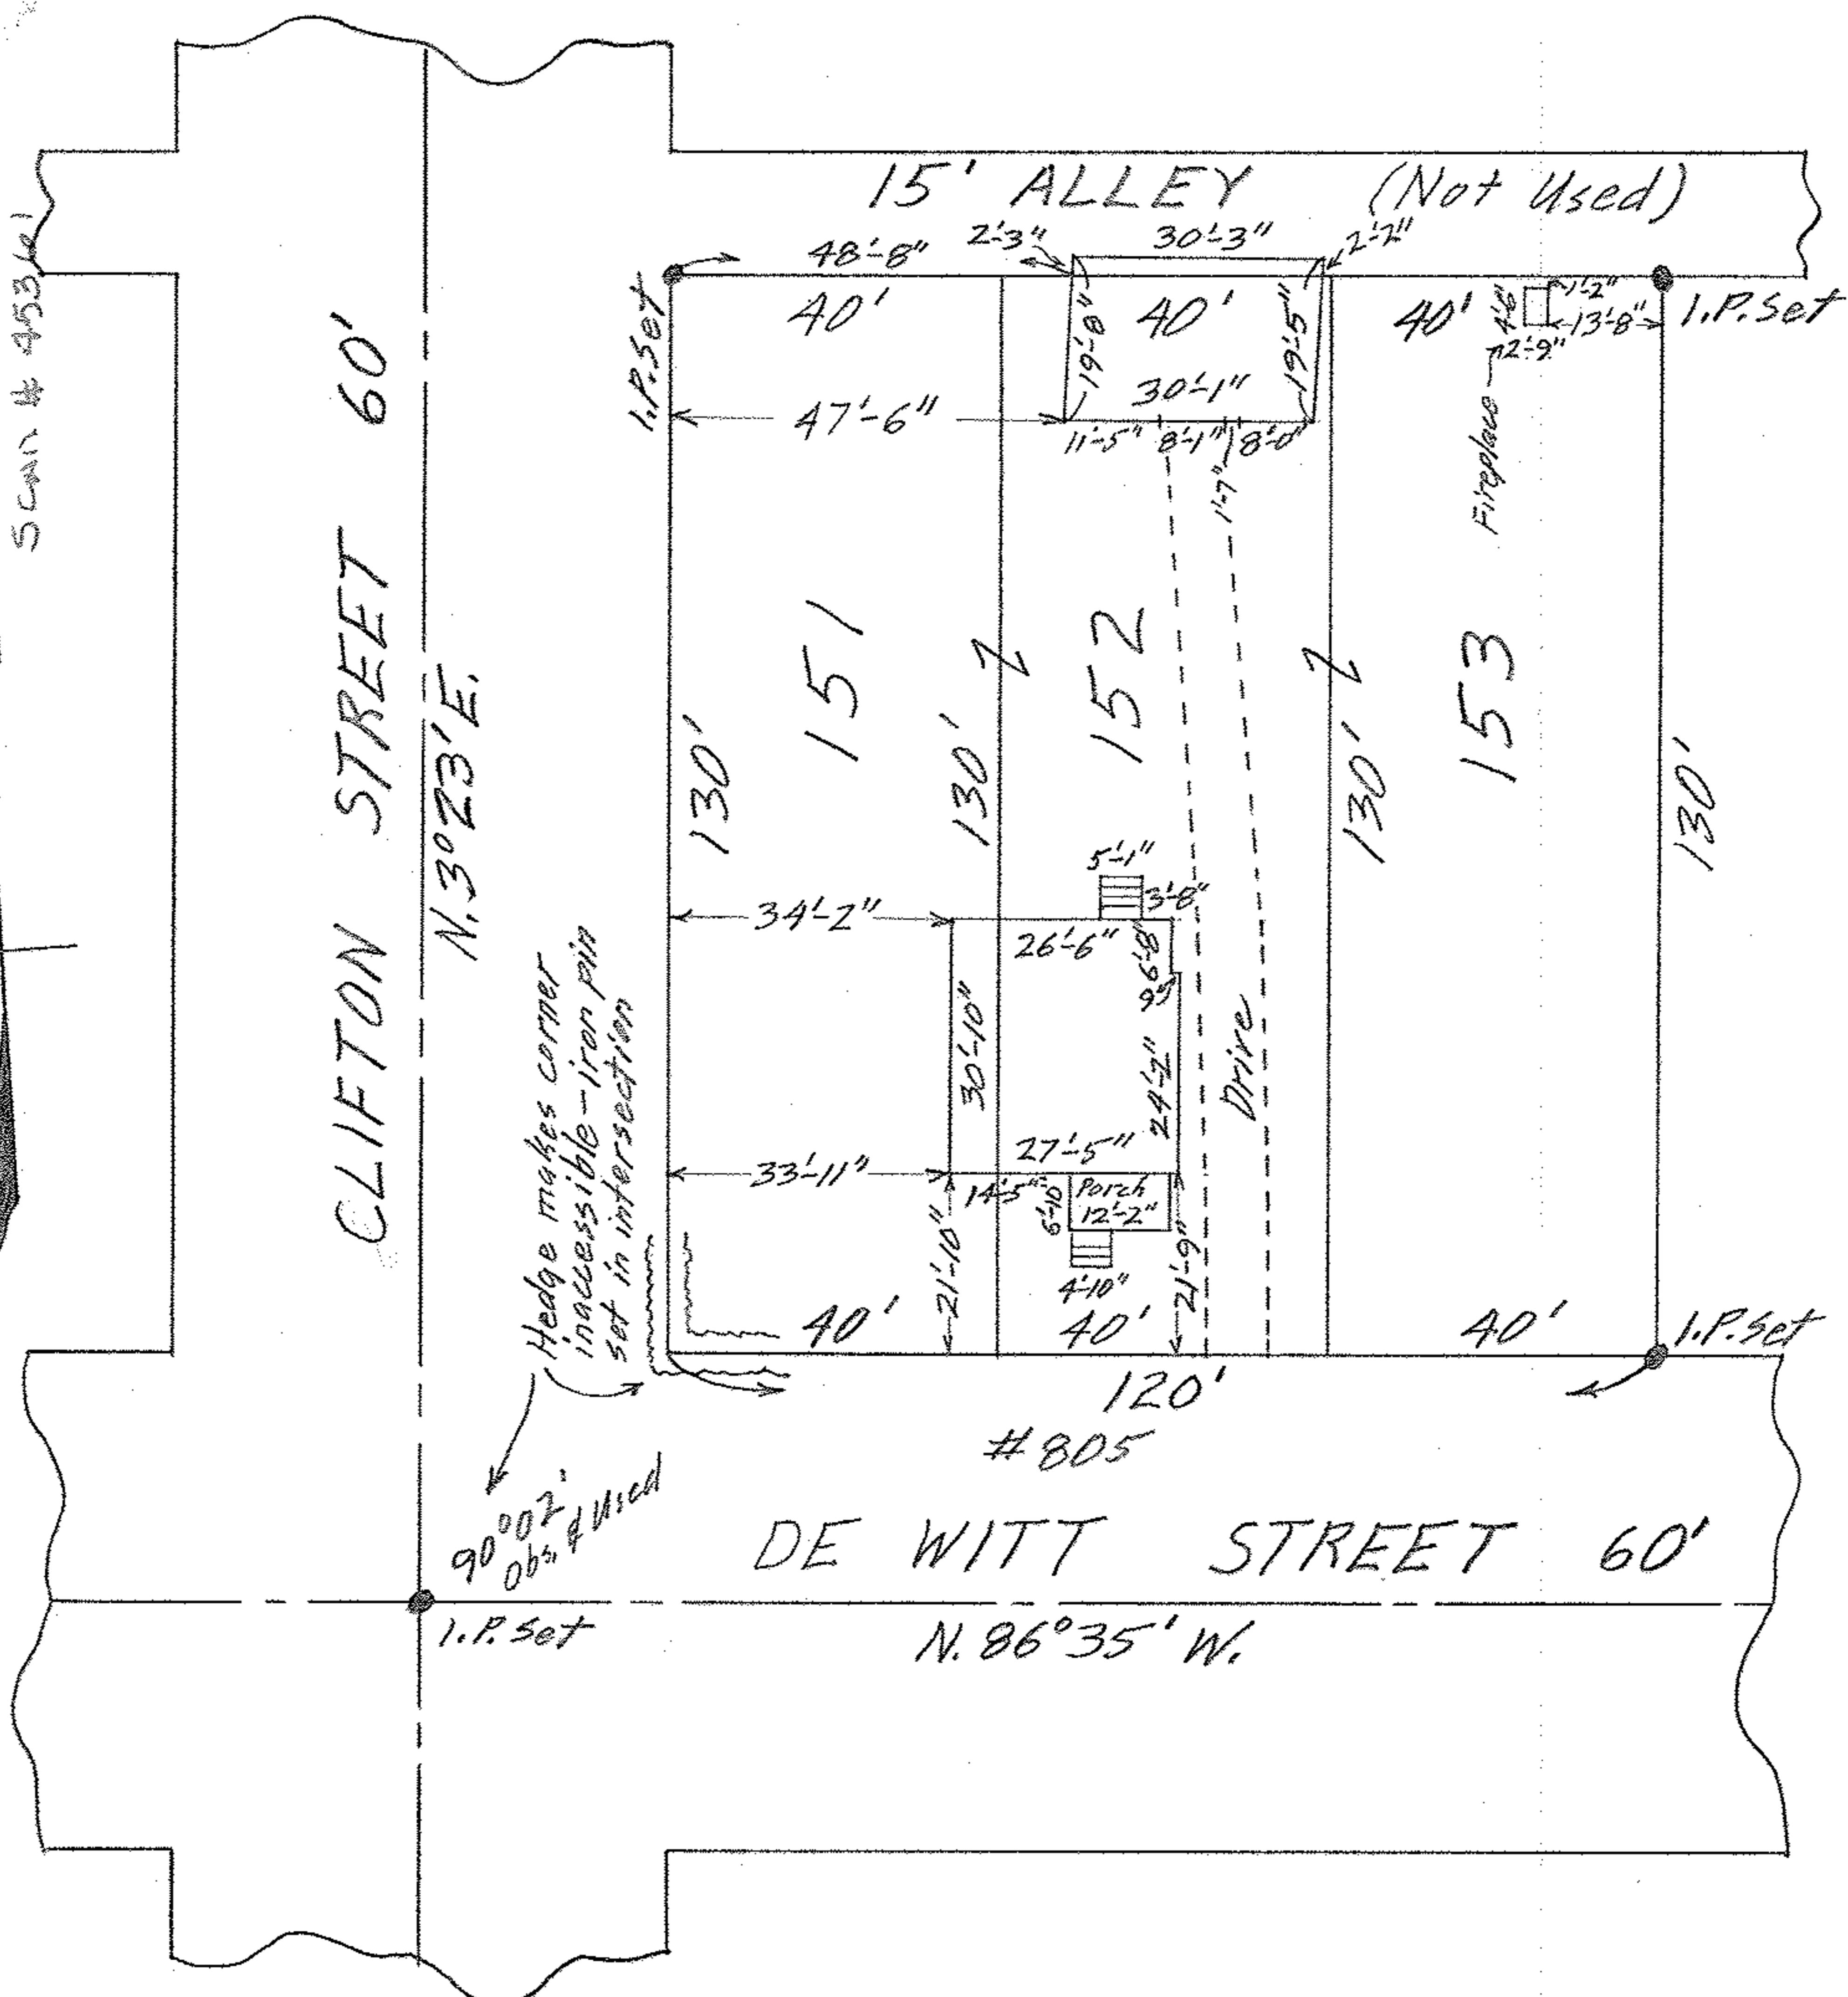

SURVEY MAP OF SUB-LOTS 151-152 & 153
 GAYLORD'S SUB'N. Vol. 5 Pg. 18 PLATS
 ORIG. LOT NO. 103 SHEFFIELD TWP.
 LORAIN COUNTY - OHIO
 SCALE: 1" = 30' JUNE 5-1963 3:30 P.M.
 Mary E. Penfound REG. SURVEYOR

William & Vada Green

W W