

03-00-109-104-079

03-00-109-11


37365

[Handwritten scribbles]

CLINTON AVE. - (FRM LAFAYETTE AVE.)

HARRISON AVE. - 50'

DRILL HOLE & CROSS fd.
IN CONC. AROUND FENCE POST

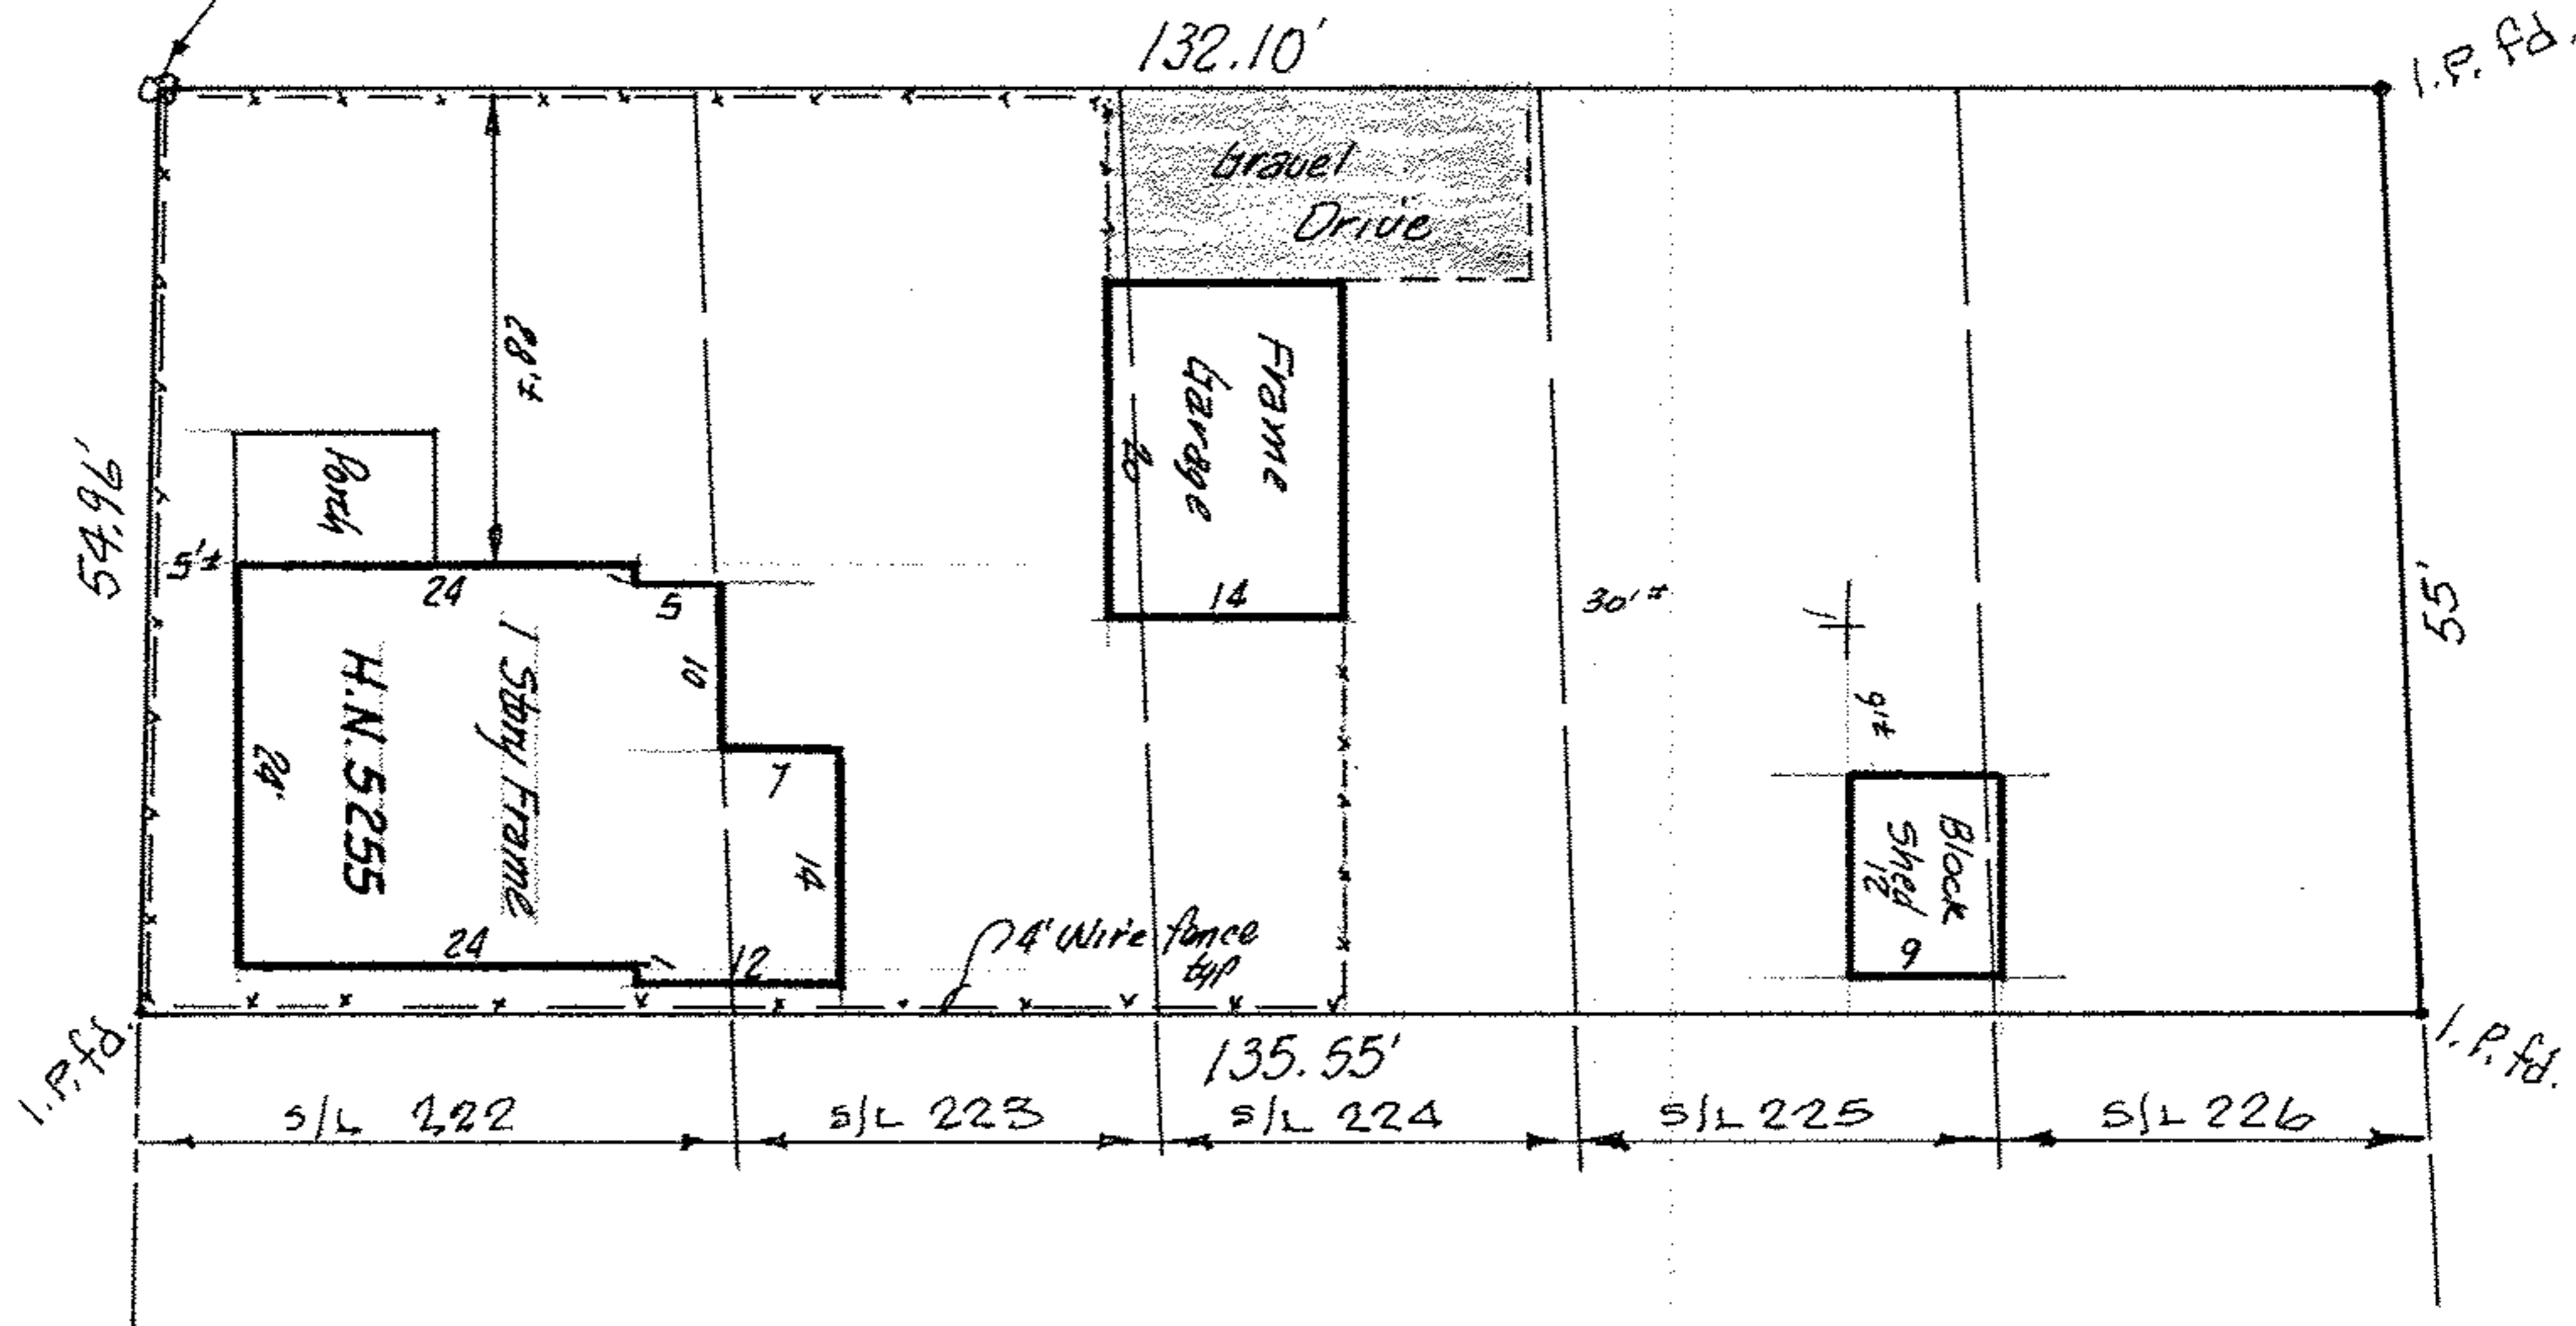

PARTS of
 SUBLOTS 222 thru 226 incl. in LORAIN LAND & IMPROVEMENT
 Co's. RIDGEVUE HEIGHTS ADDITION
 PLAT VOL. 8 PAGE 21
 PART of ORIG. SHEFFIELD TWP. LOT 109
 TOWNSHIP of SHEFFIELD , OHIO

THIS IS NOT A PLAT OF SURVEY:
 FOR MORTGAGE LOAN PURPOSES ONLY

McGLINCHY & ASSOCIATES

SEPT. 18, 1978

#784254

CTIC# E-176,416