


03-00-113-105-001, 002
 03-00-113-13-13
 Scan # 45376

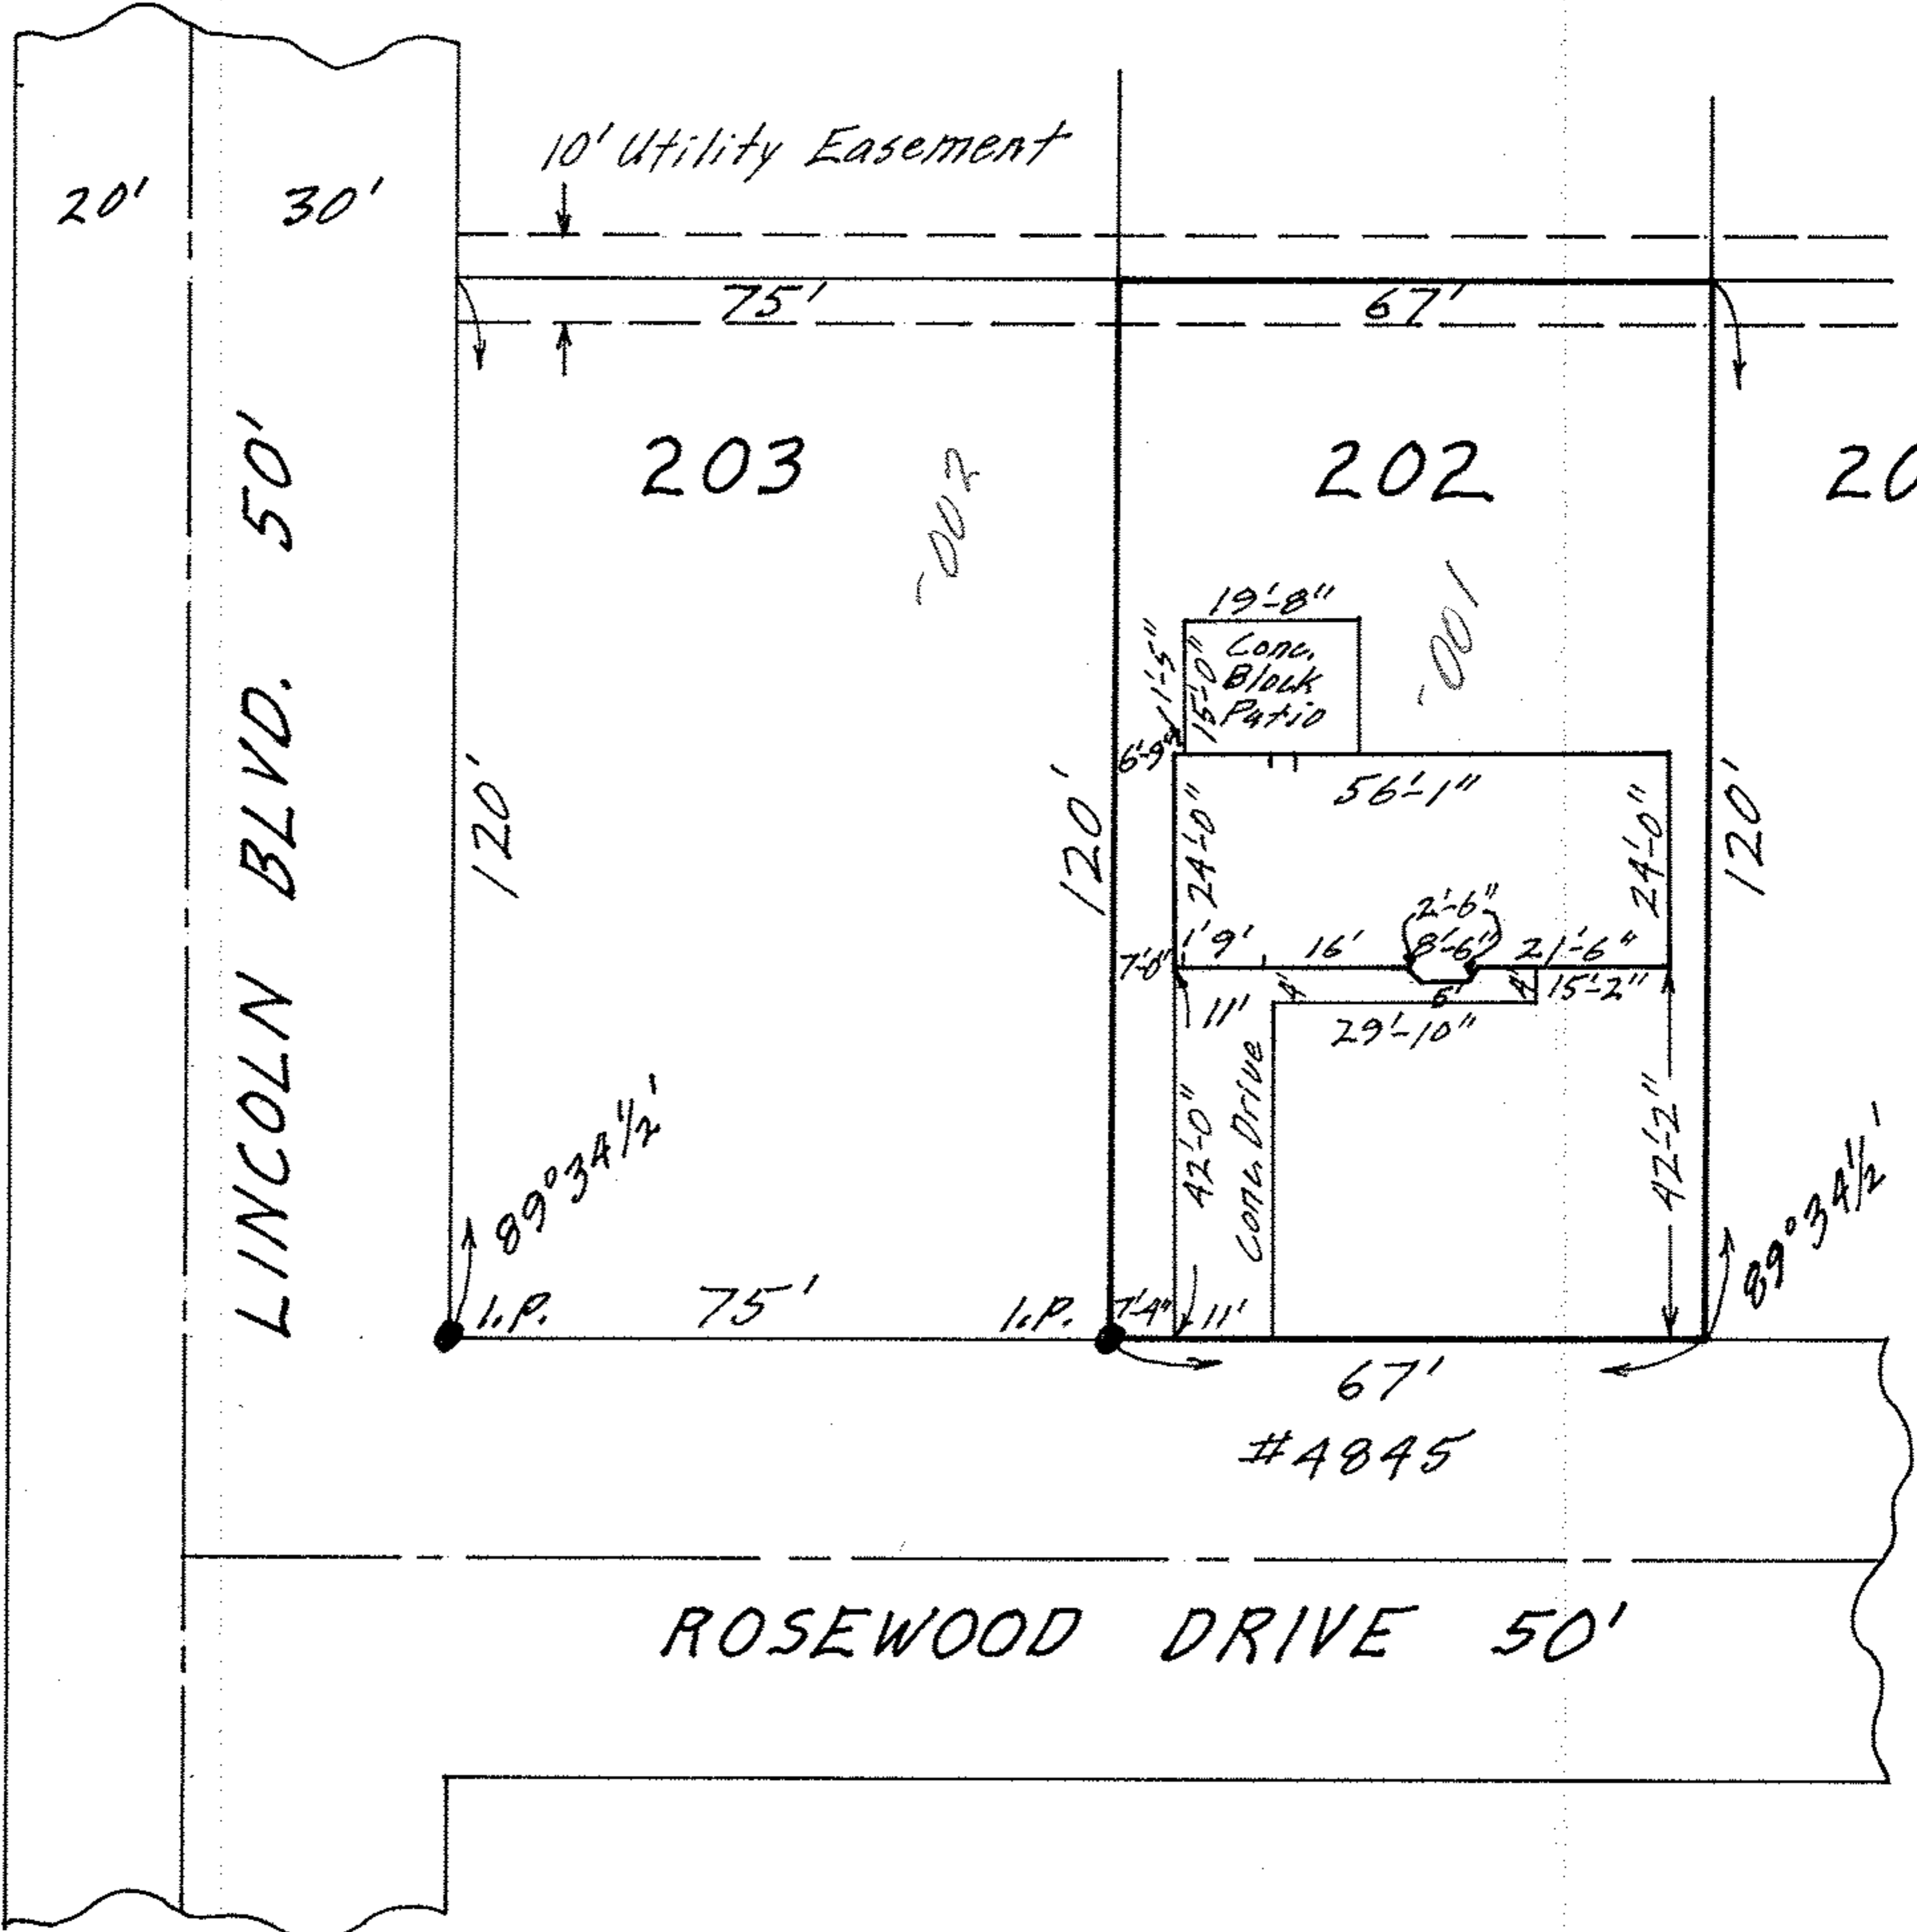

MAP OF SUB-LOT NO. 202
 PADWAY ALL'T., THIRD ADD'N. VOL. 17 PG. 31
 SHEFFIELD TWP. SHEFFIELD LAKE CITY
 LORAIN COUNTY OHIO
 SCALE: 1" = 30' APRIL 13-1967 11:30 A.M.
 Gary E. Penfound REG. SURVEYOR

Larry H. & Linda L. Marshall

03-00-113-105-001, 002
 03-00-113-13-13
 Scan # 45376