

04-00-006-108-055, 034, 033

04-00-004-B
SCAN #45385

MILLER ROAD
ORIG. R/W 50'

Man. Box

LAKE ROAD 60'

#33703 N. 74° 07' E.
163.95'

700'
I.P. 90° 79'-8" 11'-6" 63.95'

28 95'-3" 50' 50' 10'-11" 10'-1'
29 95'-1" 130' 128'-11" 10'-1'
30 130' 136.89'
261.77' 14'-1" 22'-9" 20'-11" 19'-9" 34'-0" 34'-4" 50' 21.08'


Concrete Drive

MAP OF SUB-LOTS NOS. 28-29-30-31 & 32
AVON LAKE HARBOR ESTATES SUB'D.

VOL. 12 PG. 24 PLATS
SECTION NO. 6 - AVON TWP. - AVON LAKE CITY
LORAIN COUNTY - OHIO

SCALE: 1" = 40' OCT. 17-1971 5:15 P.M.

NOTE: There are no encroachments on this property.
Gary E. Renfound REG. SURVEYOR NO. 4457

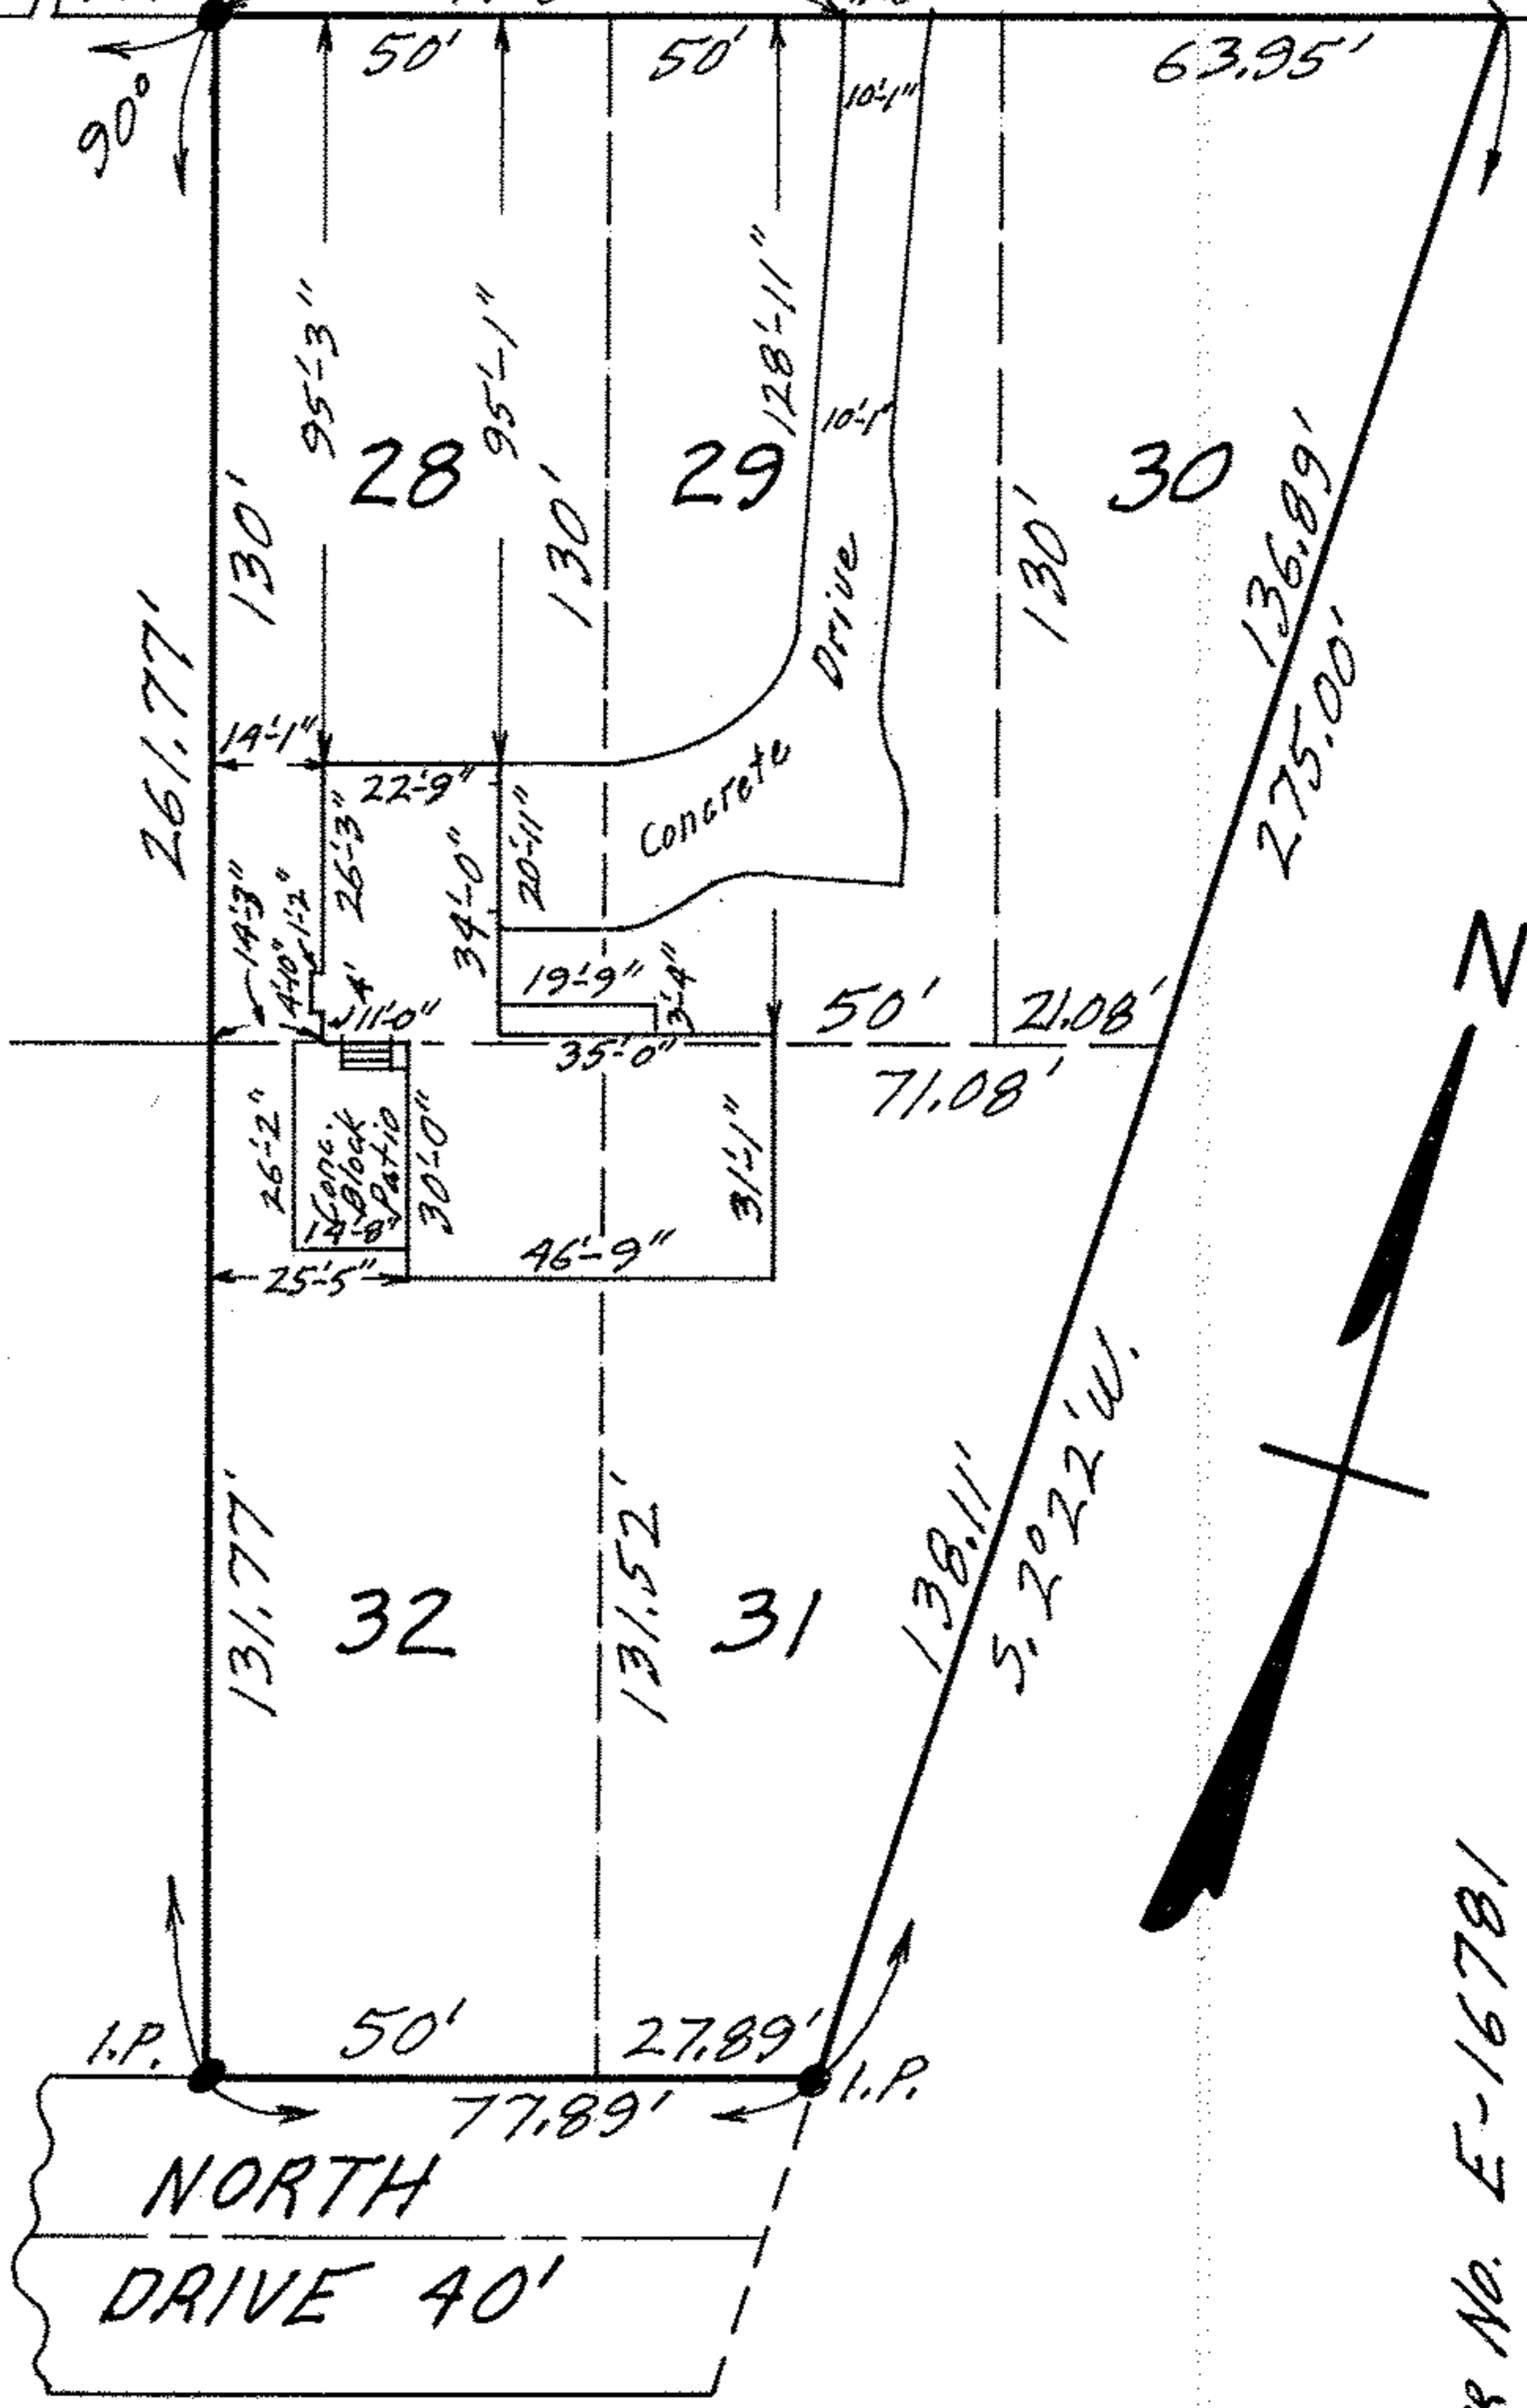

ORDER No. E-16781
O'Melia to Gaborick