


04-00-18-15-03, 032

West Line SUB'N. NO. 2

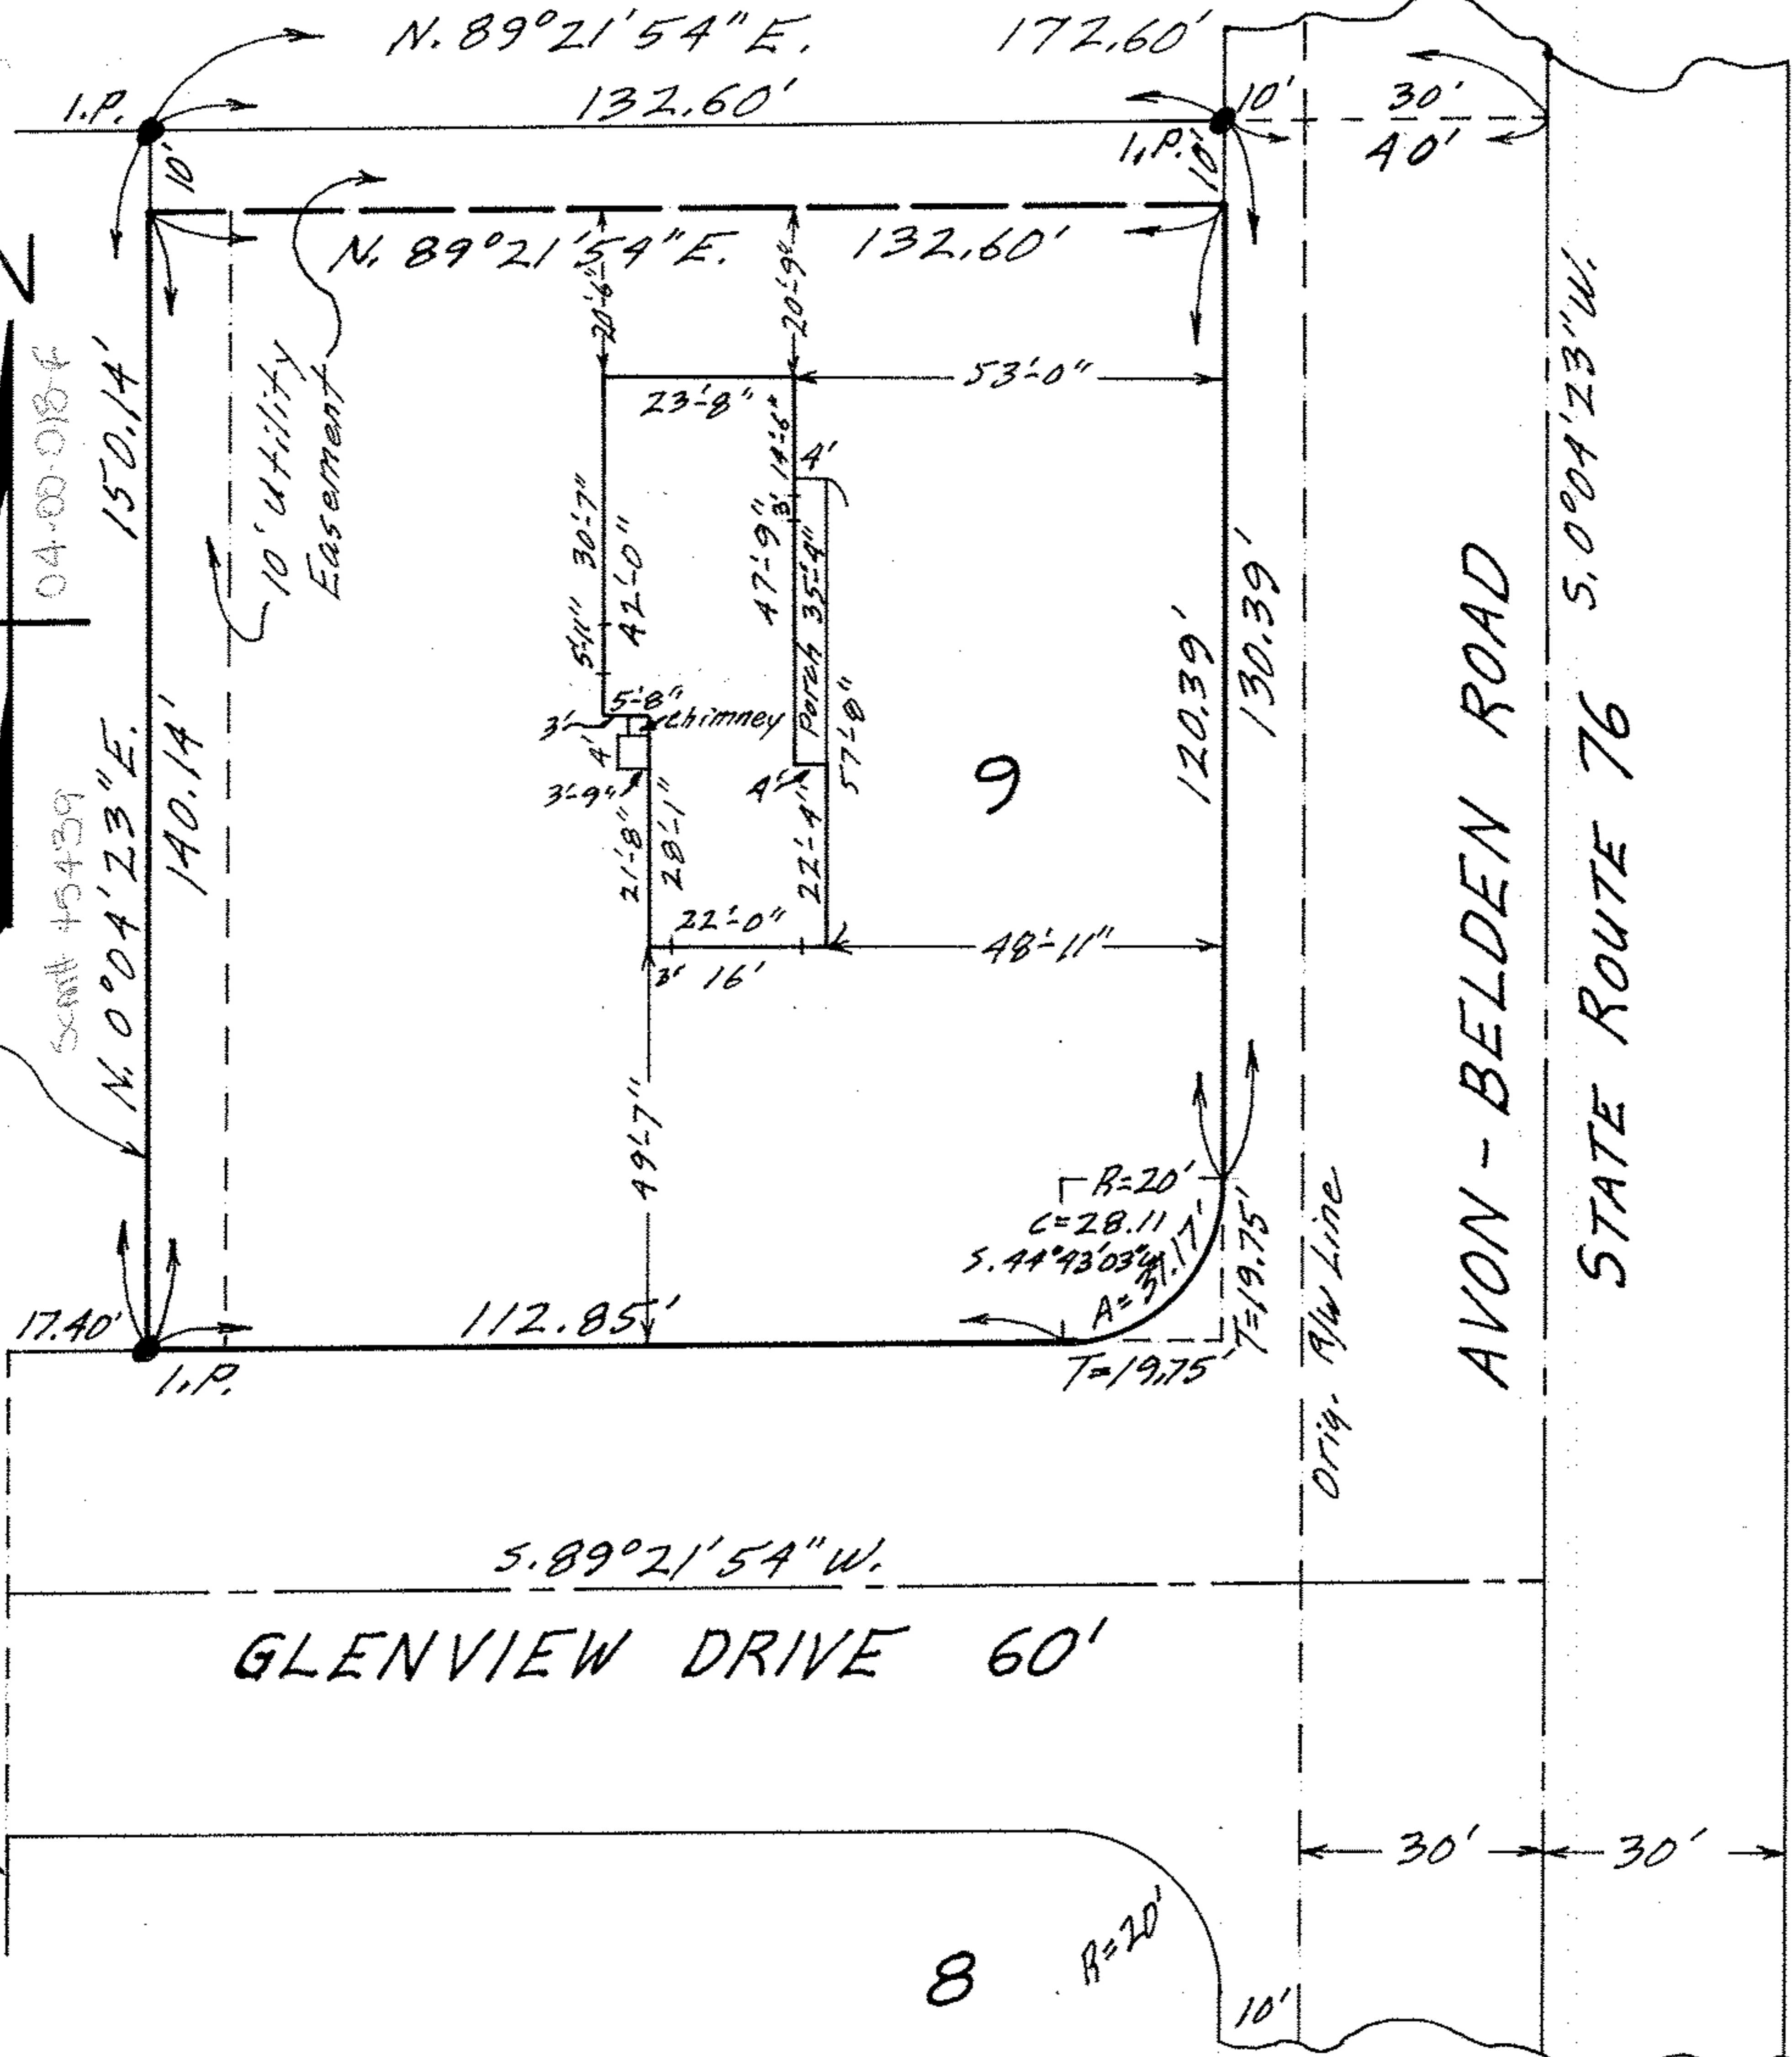

MAP OF PART OF SUB-LOT NO. 9  
 GAMA HOMES, INC. SUB'N. NO. 2 Vol. 24 Pg. 11  
 SECTION NO. 18 AVON TOWNSHIP  
 AVON LAKE CITY - LORAIN COUNTY - OHIO  
 SCALE: 1" = 30' SEPT. 17-1967 2:30 P.M.  
 Gary E. Penfound REG. SURVEYOR

Glenn J. & Anne Snyder