


04-00-018-121-0017003

04-00-018-I  
4544

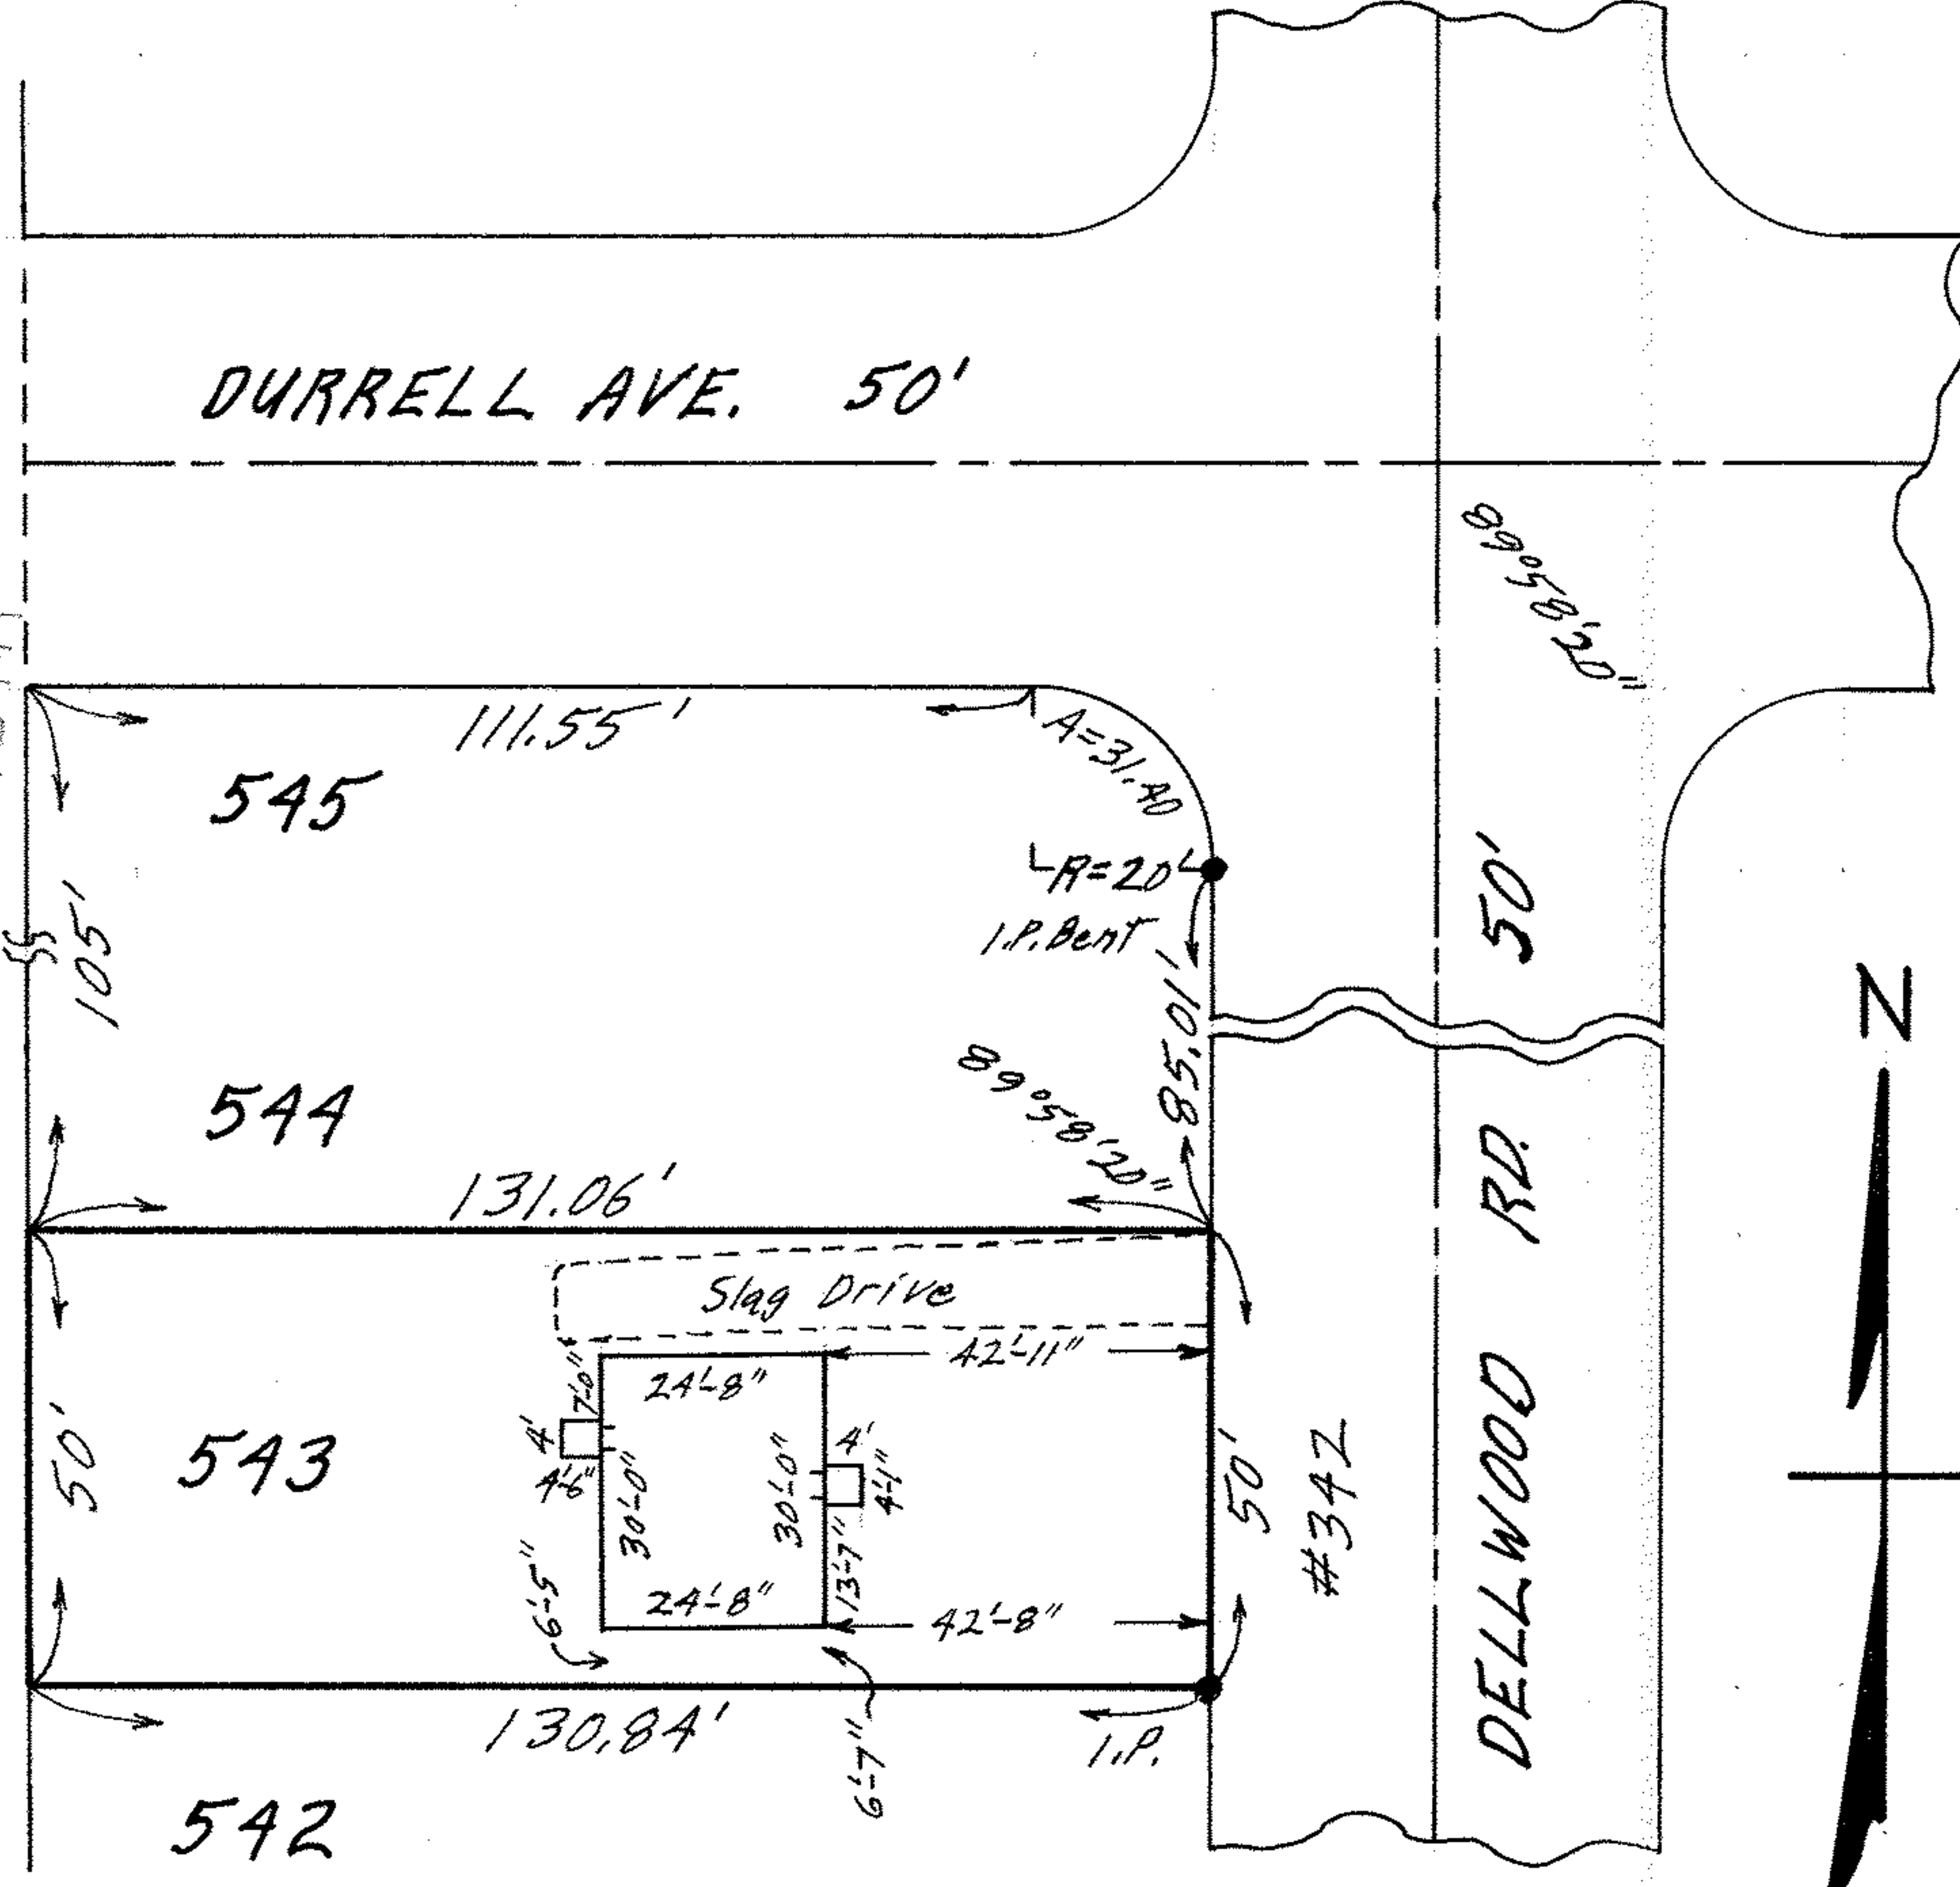

MAP OF SUB-LOT NO. 543

INWOOD BEACH SUB'N. NO. 2 VOL. 13 Pg. 10  
ORIGINAL SECTION NO. 18 - AVON TOWNSHIP  
AVON LAKE CITY - LORAIN COUNTY - OHIO  
SCALE: 1"=30' NOV. 5-1969 2:30 P.M.

NOTE: There are no encroachments on this property.  
Gary E. Penfound REG. SURVEYOR NO. 4957

CITY TITLE Co. Order No. E-934-5  
James C. & Mary Ann Hathaway to  
Robert L. & Sandra Vander Sluis