


04-00-018-158-007.008  
04-00-018-9  
SCAN # 45446

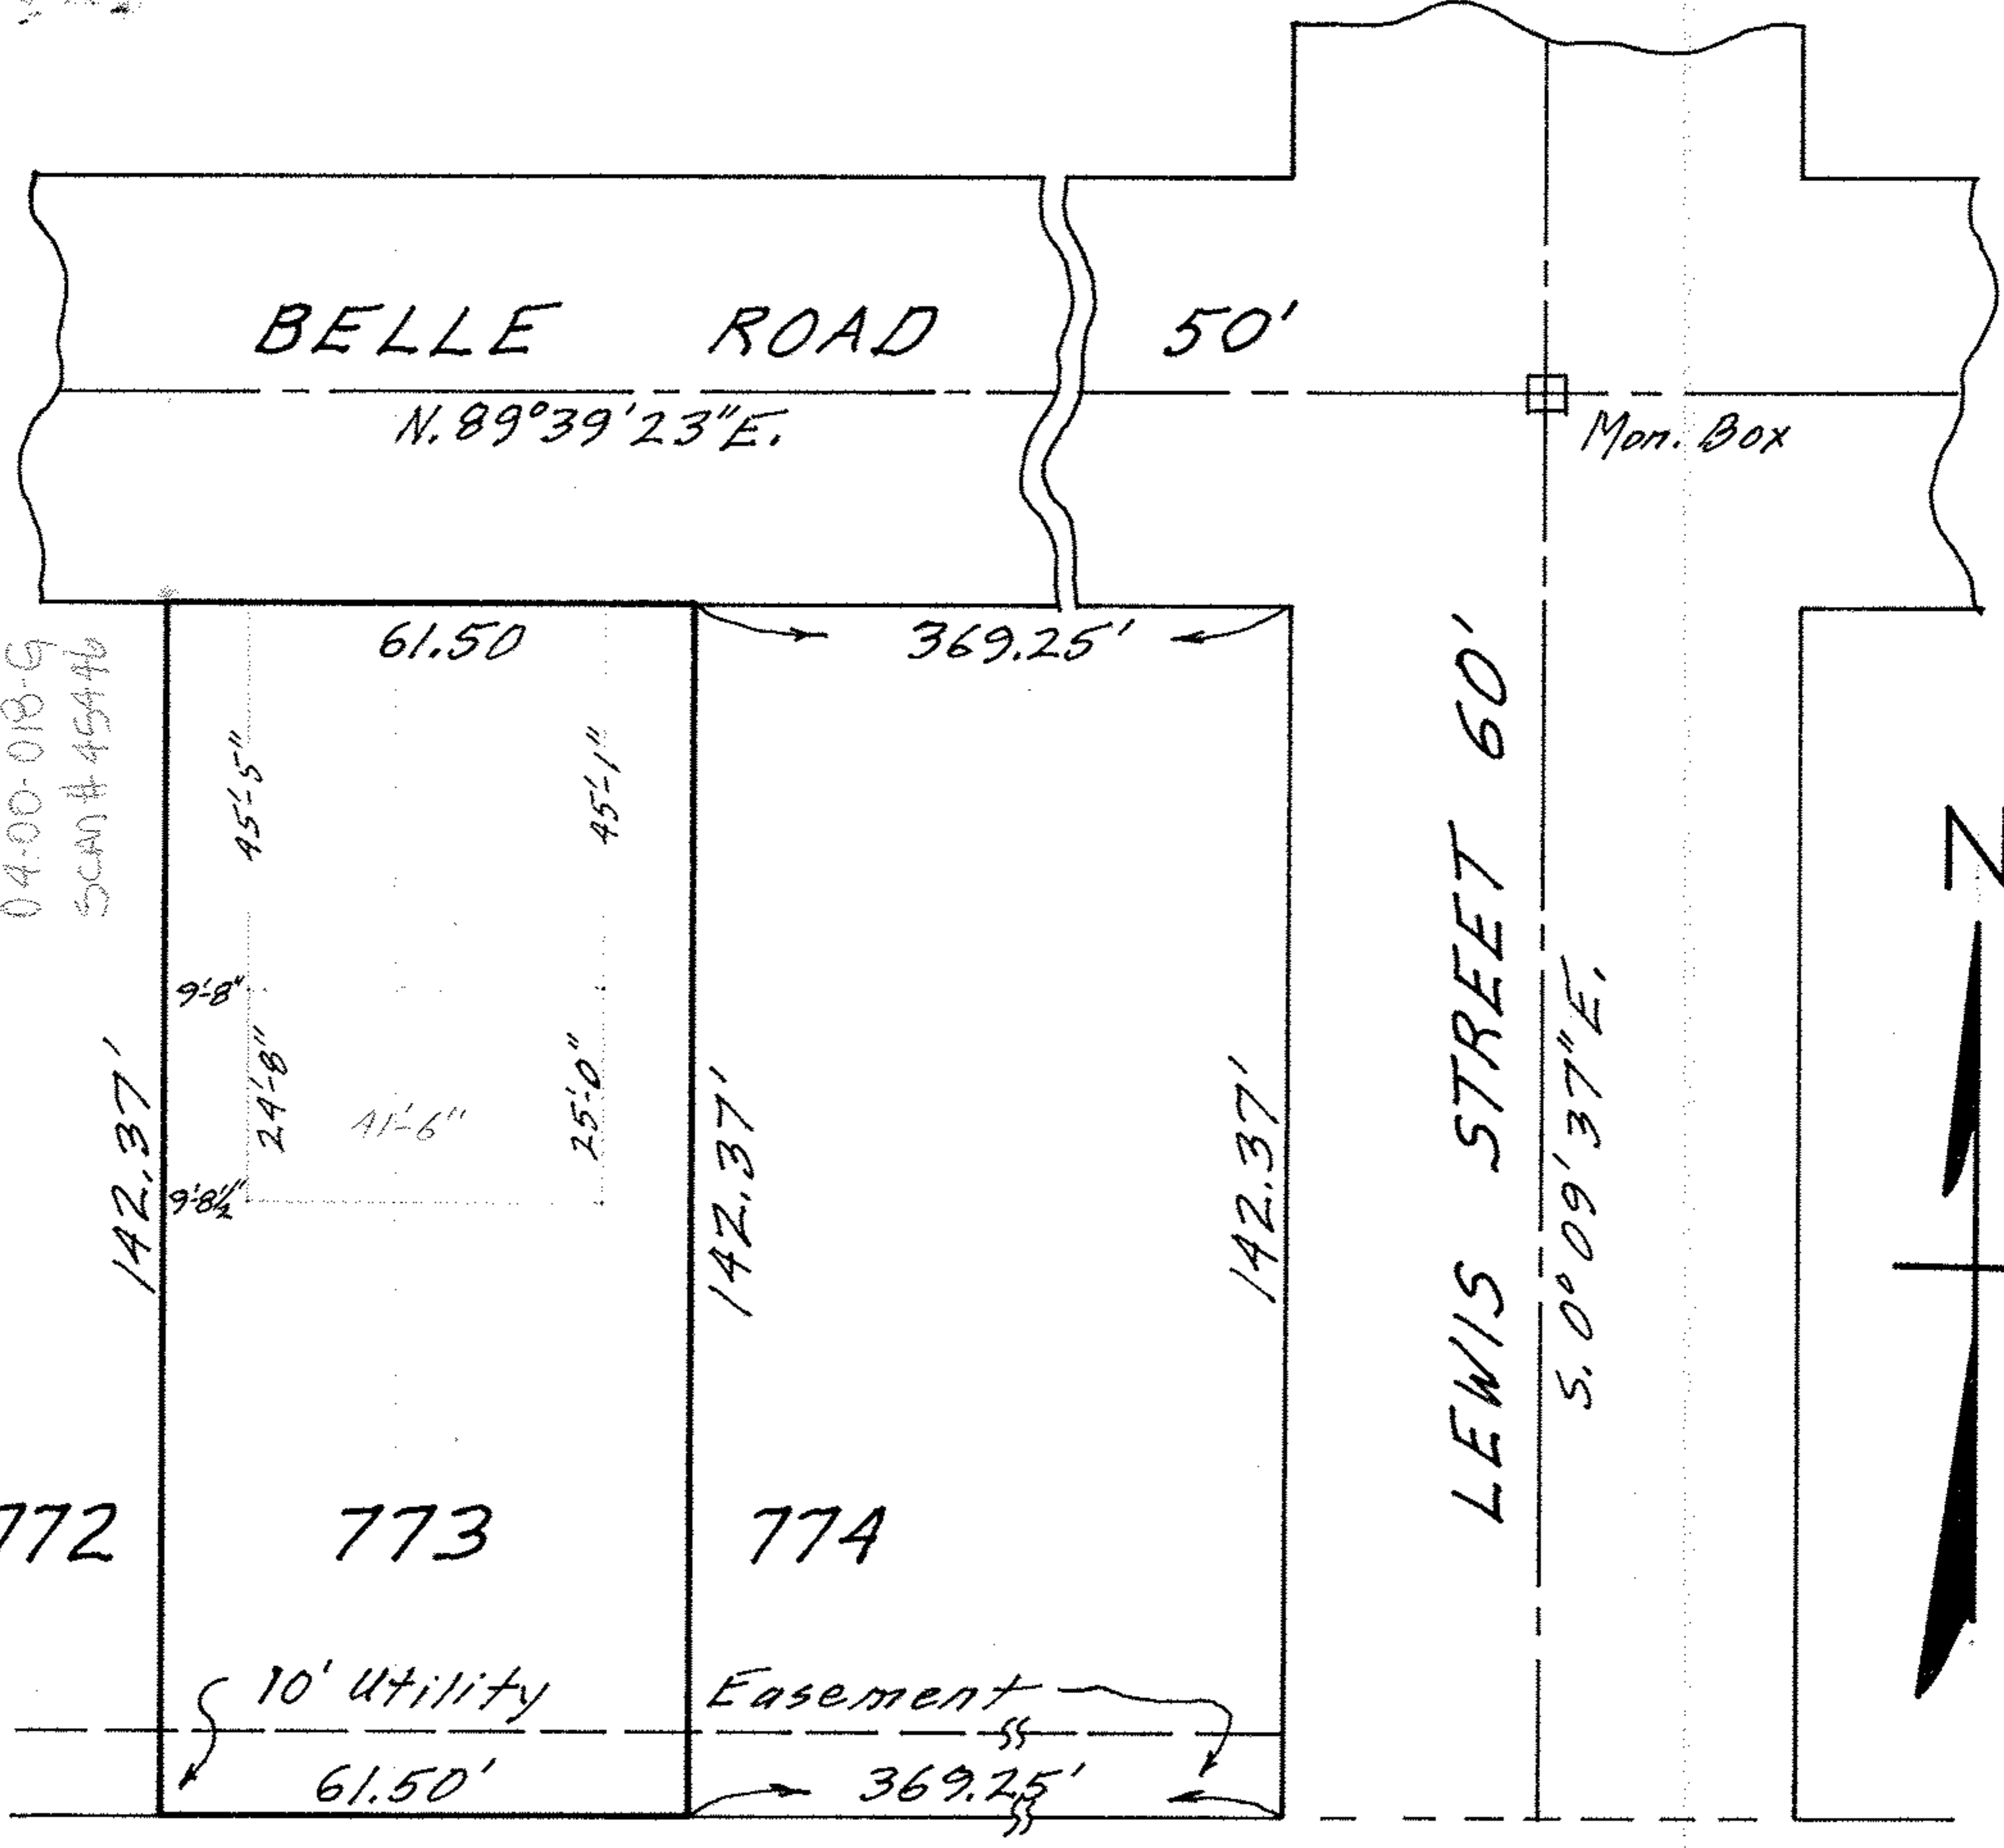

MAP OF SUB-LOT NO. 773 OF RESUBDIVISION  
OF PART OF BELDEN PARK SUB'N. NO. 2  
VOL. 18 PG. 24 PLATS SECTION 18 - AVON TWP.  
AVON LAKE CITY - LORAIN COUNTY - OHIO  
SCALE: 1" = 30' MAY 23 - 1966 7:00 P.M.  
Gary E. Penfound      REG. SURVEYORS  
for G. E. Penfound  
E-14513 Kopf Construction