


04-00-018-158-012
 04-00-018-6
 SCAM-45447

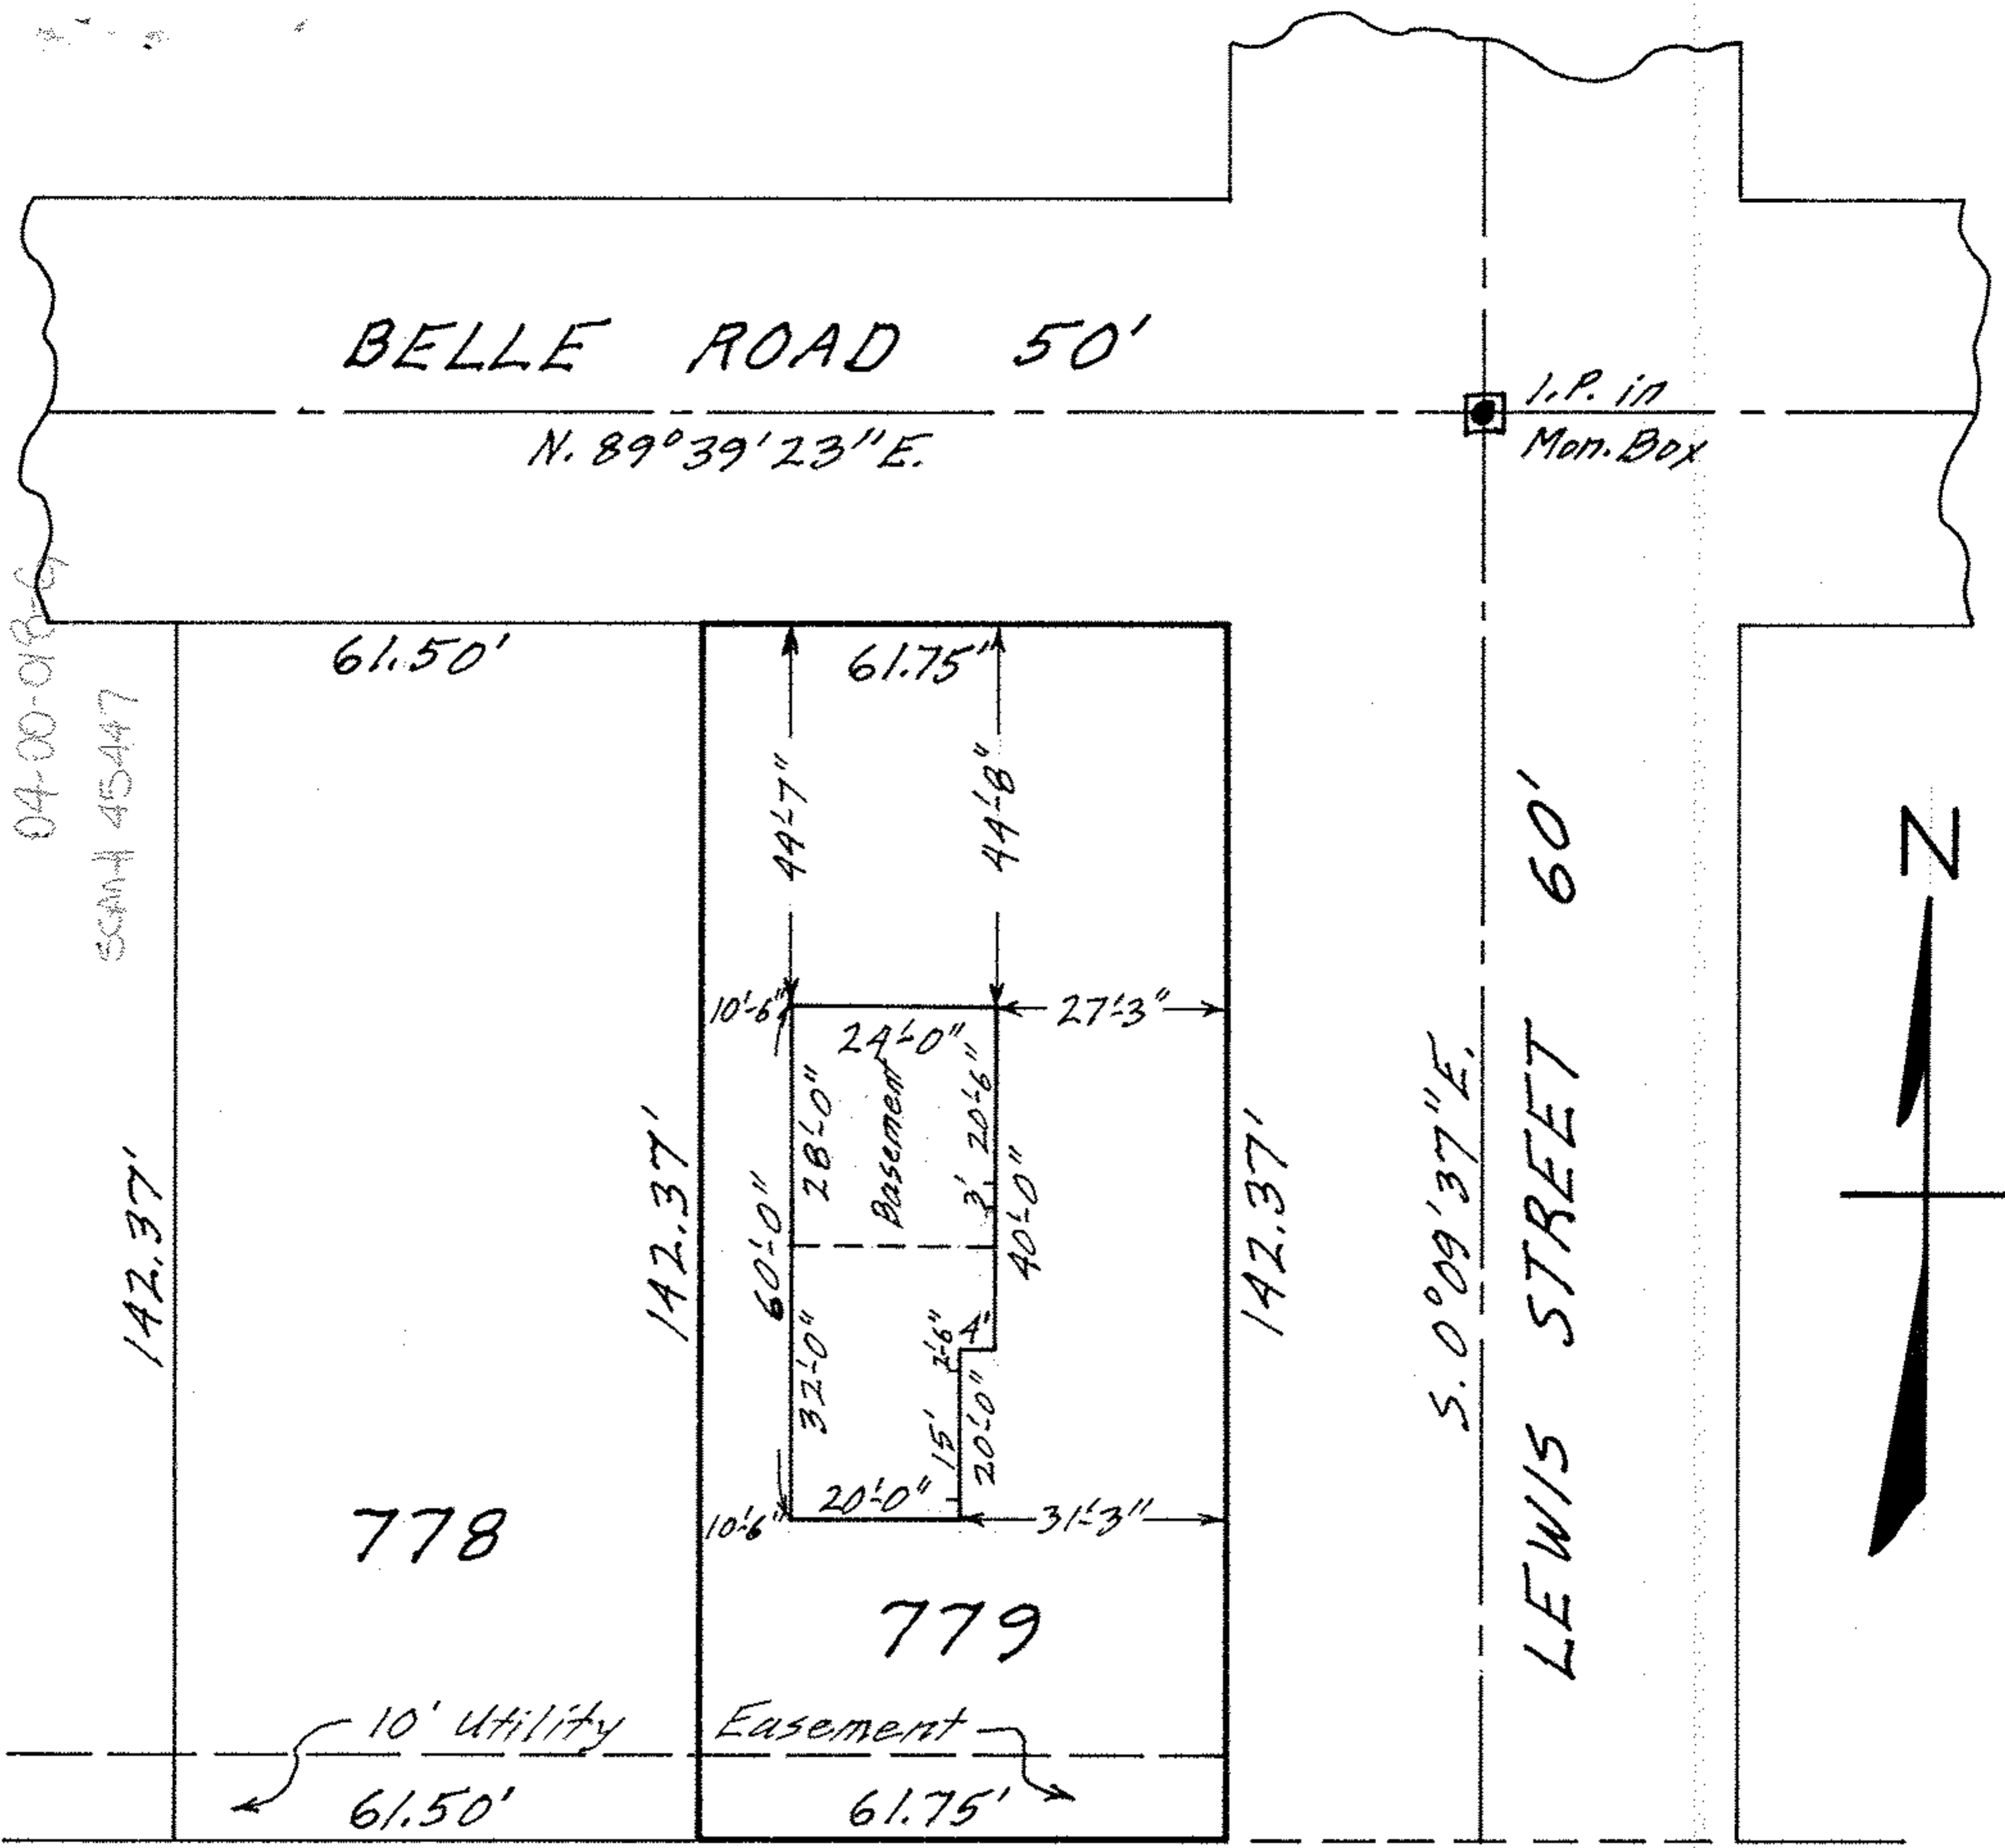

MAP OF SUB-LOT NO. 779 OF RESUBDIVISION OF PART
 OF BELDEN PARK SUB'N. NO. 2 VOL. 18 PG. 24 PLATS
 SECTION NO. 18 - AVON TWP. - AVON LAKE CITY
 LORAIN COUNTY OHIO
 SCALE: 1" = 30' APR. 13 - 1967 12:30 P.M.
 Gary E. Penfound REG. SURVEYORS
 for C. E. Penfound
 E-15025 Kopf Construction Corp.