


04-00-019-101-004  
04-00-019-B

SCAN # 45448

294.0'

N. 4°16'10"E.

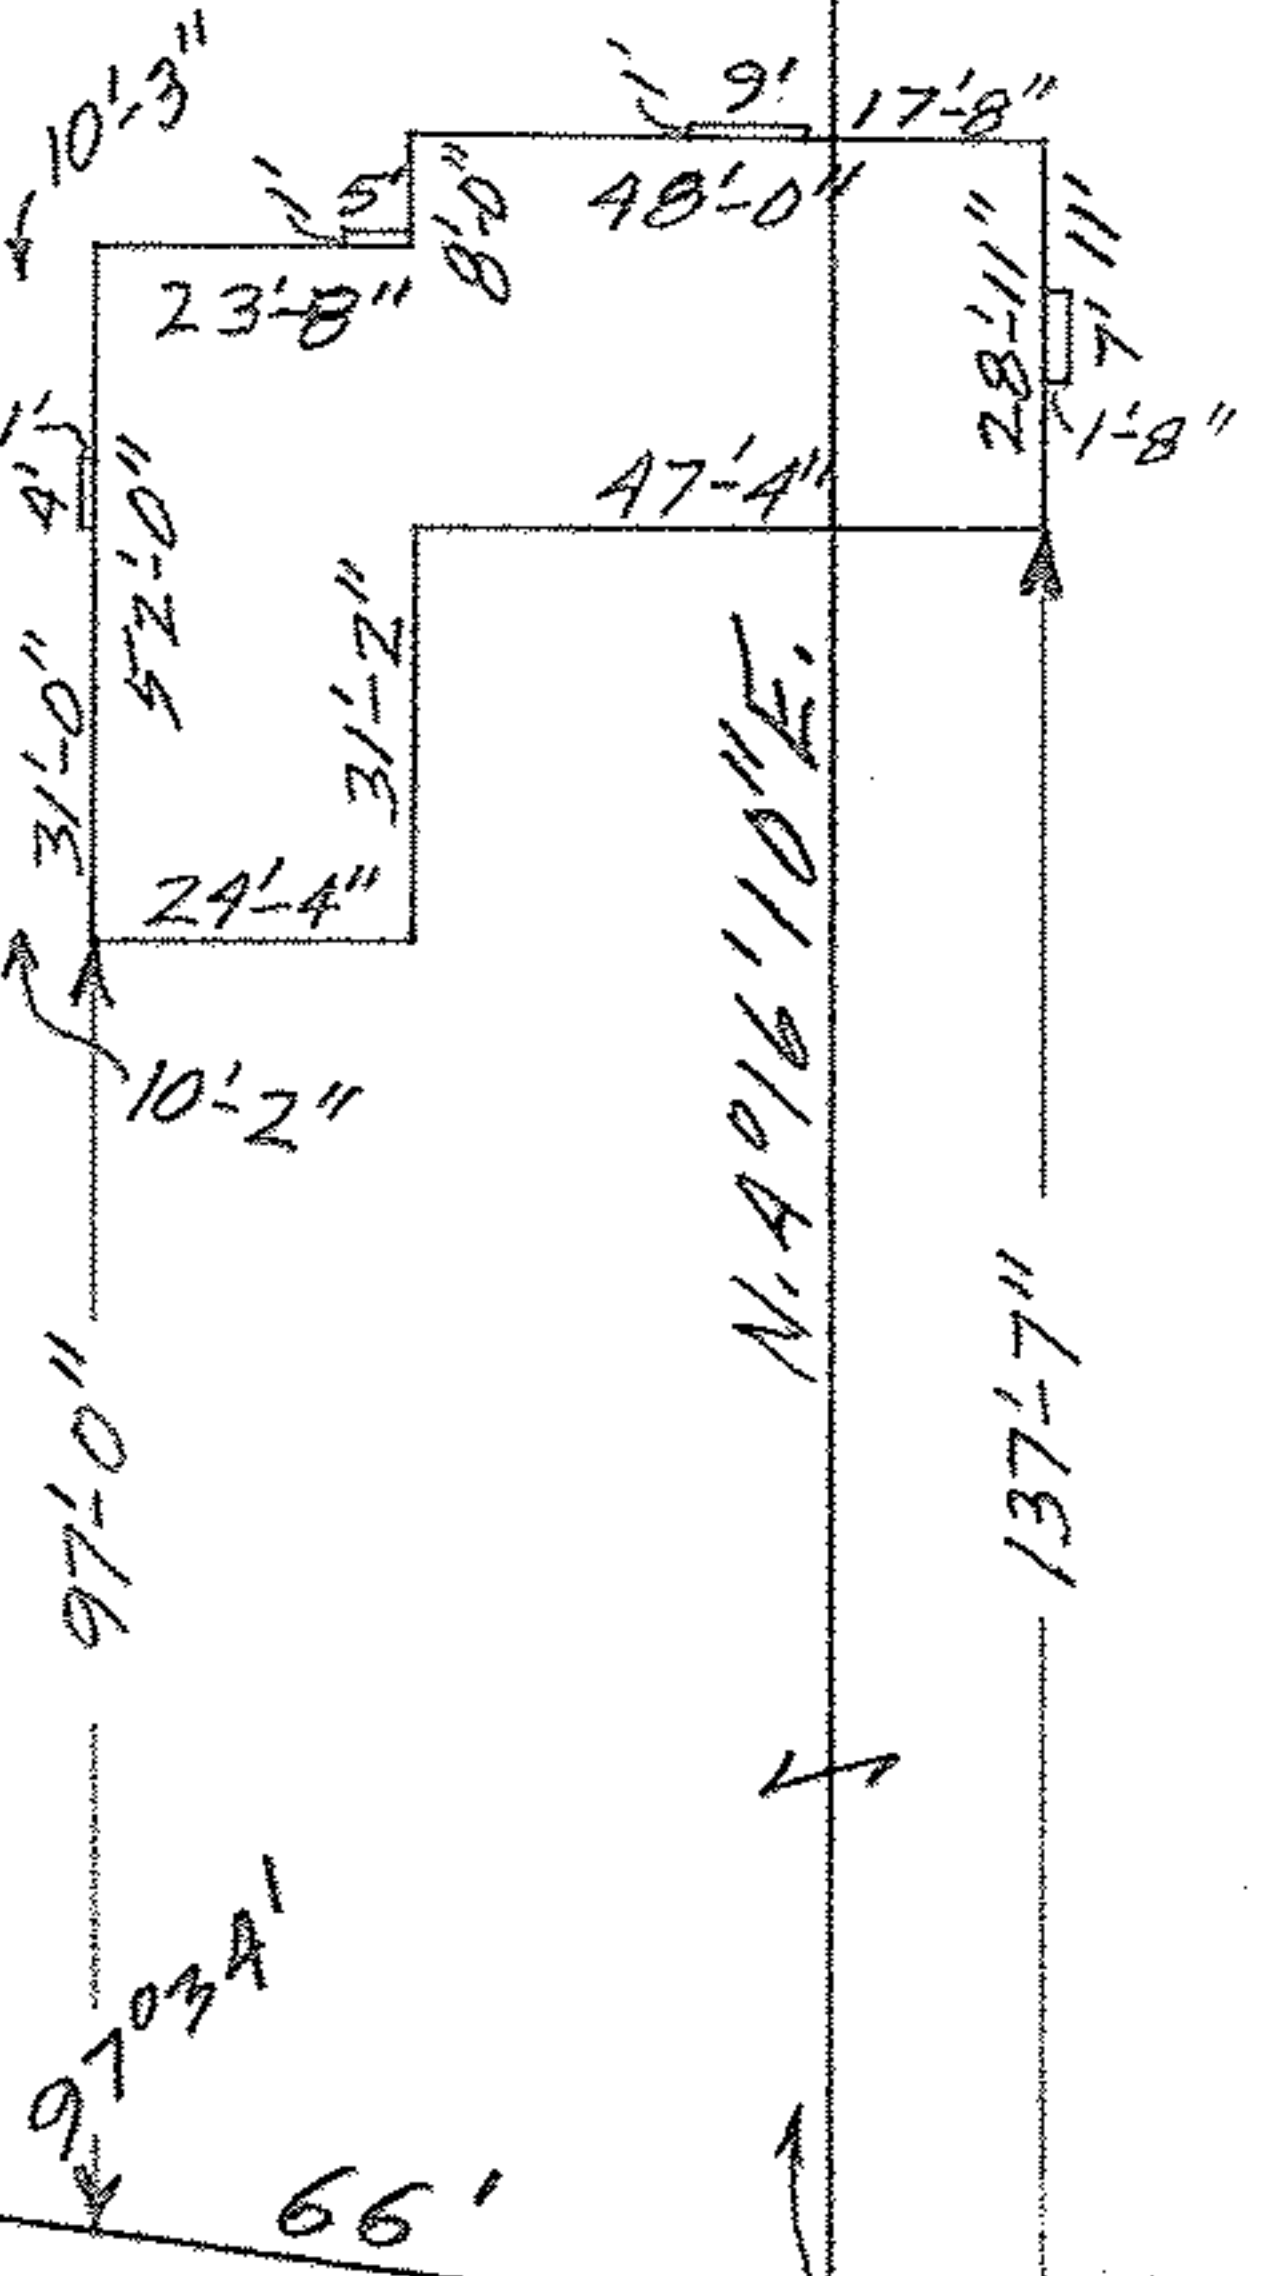

15

14

BEACH  
BLOCK "A"

173°11' N. 4°16'10"E.

75.0

R=140'

COVELAND DRIVE 40'

N. 11°05'10"E.

146.89'



LAKE ROAD 60'  
N. 78°09'50"W.

R=10.11'  
I.P.  
15.11'  
I.P.  
T=10.13'

10'-  
90°45'

JAYCOX  
ROAD

MAP OF SUB-LOTS NOS. 14 & 15

SUNSET PARK Vol. 13 Pg. 13 FLATS

SECTION NO. 19 AVON TOWNSHIP

AVON LAKE CITY - LORAIN COUNTY - OHIO

SCALE: 1" = 40' MAY 7 - 1965 2:15 P.M.

Gary E. Penfound REG. SURVEYOR

G. Del Bates & Eileen D. Bates

BH