
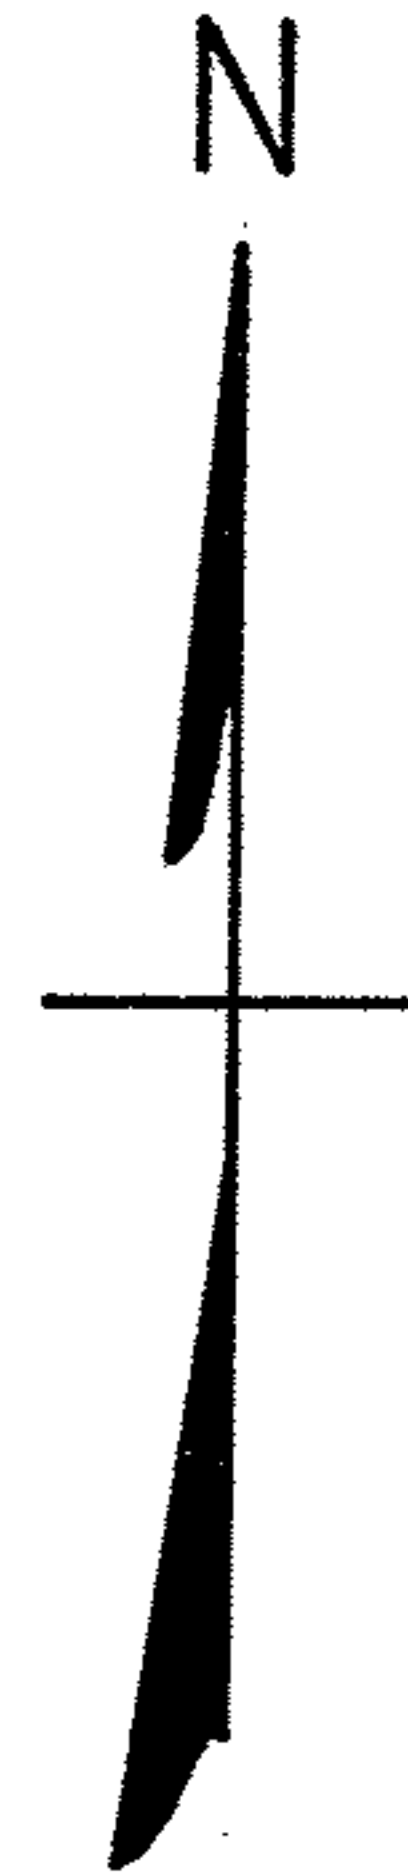


04-00-019-123-030

04-00-019-B
SCAN # 45452

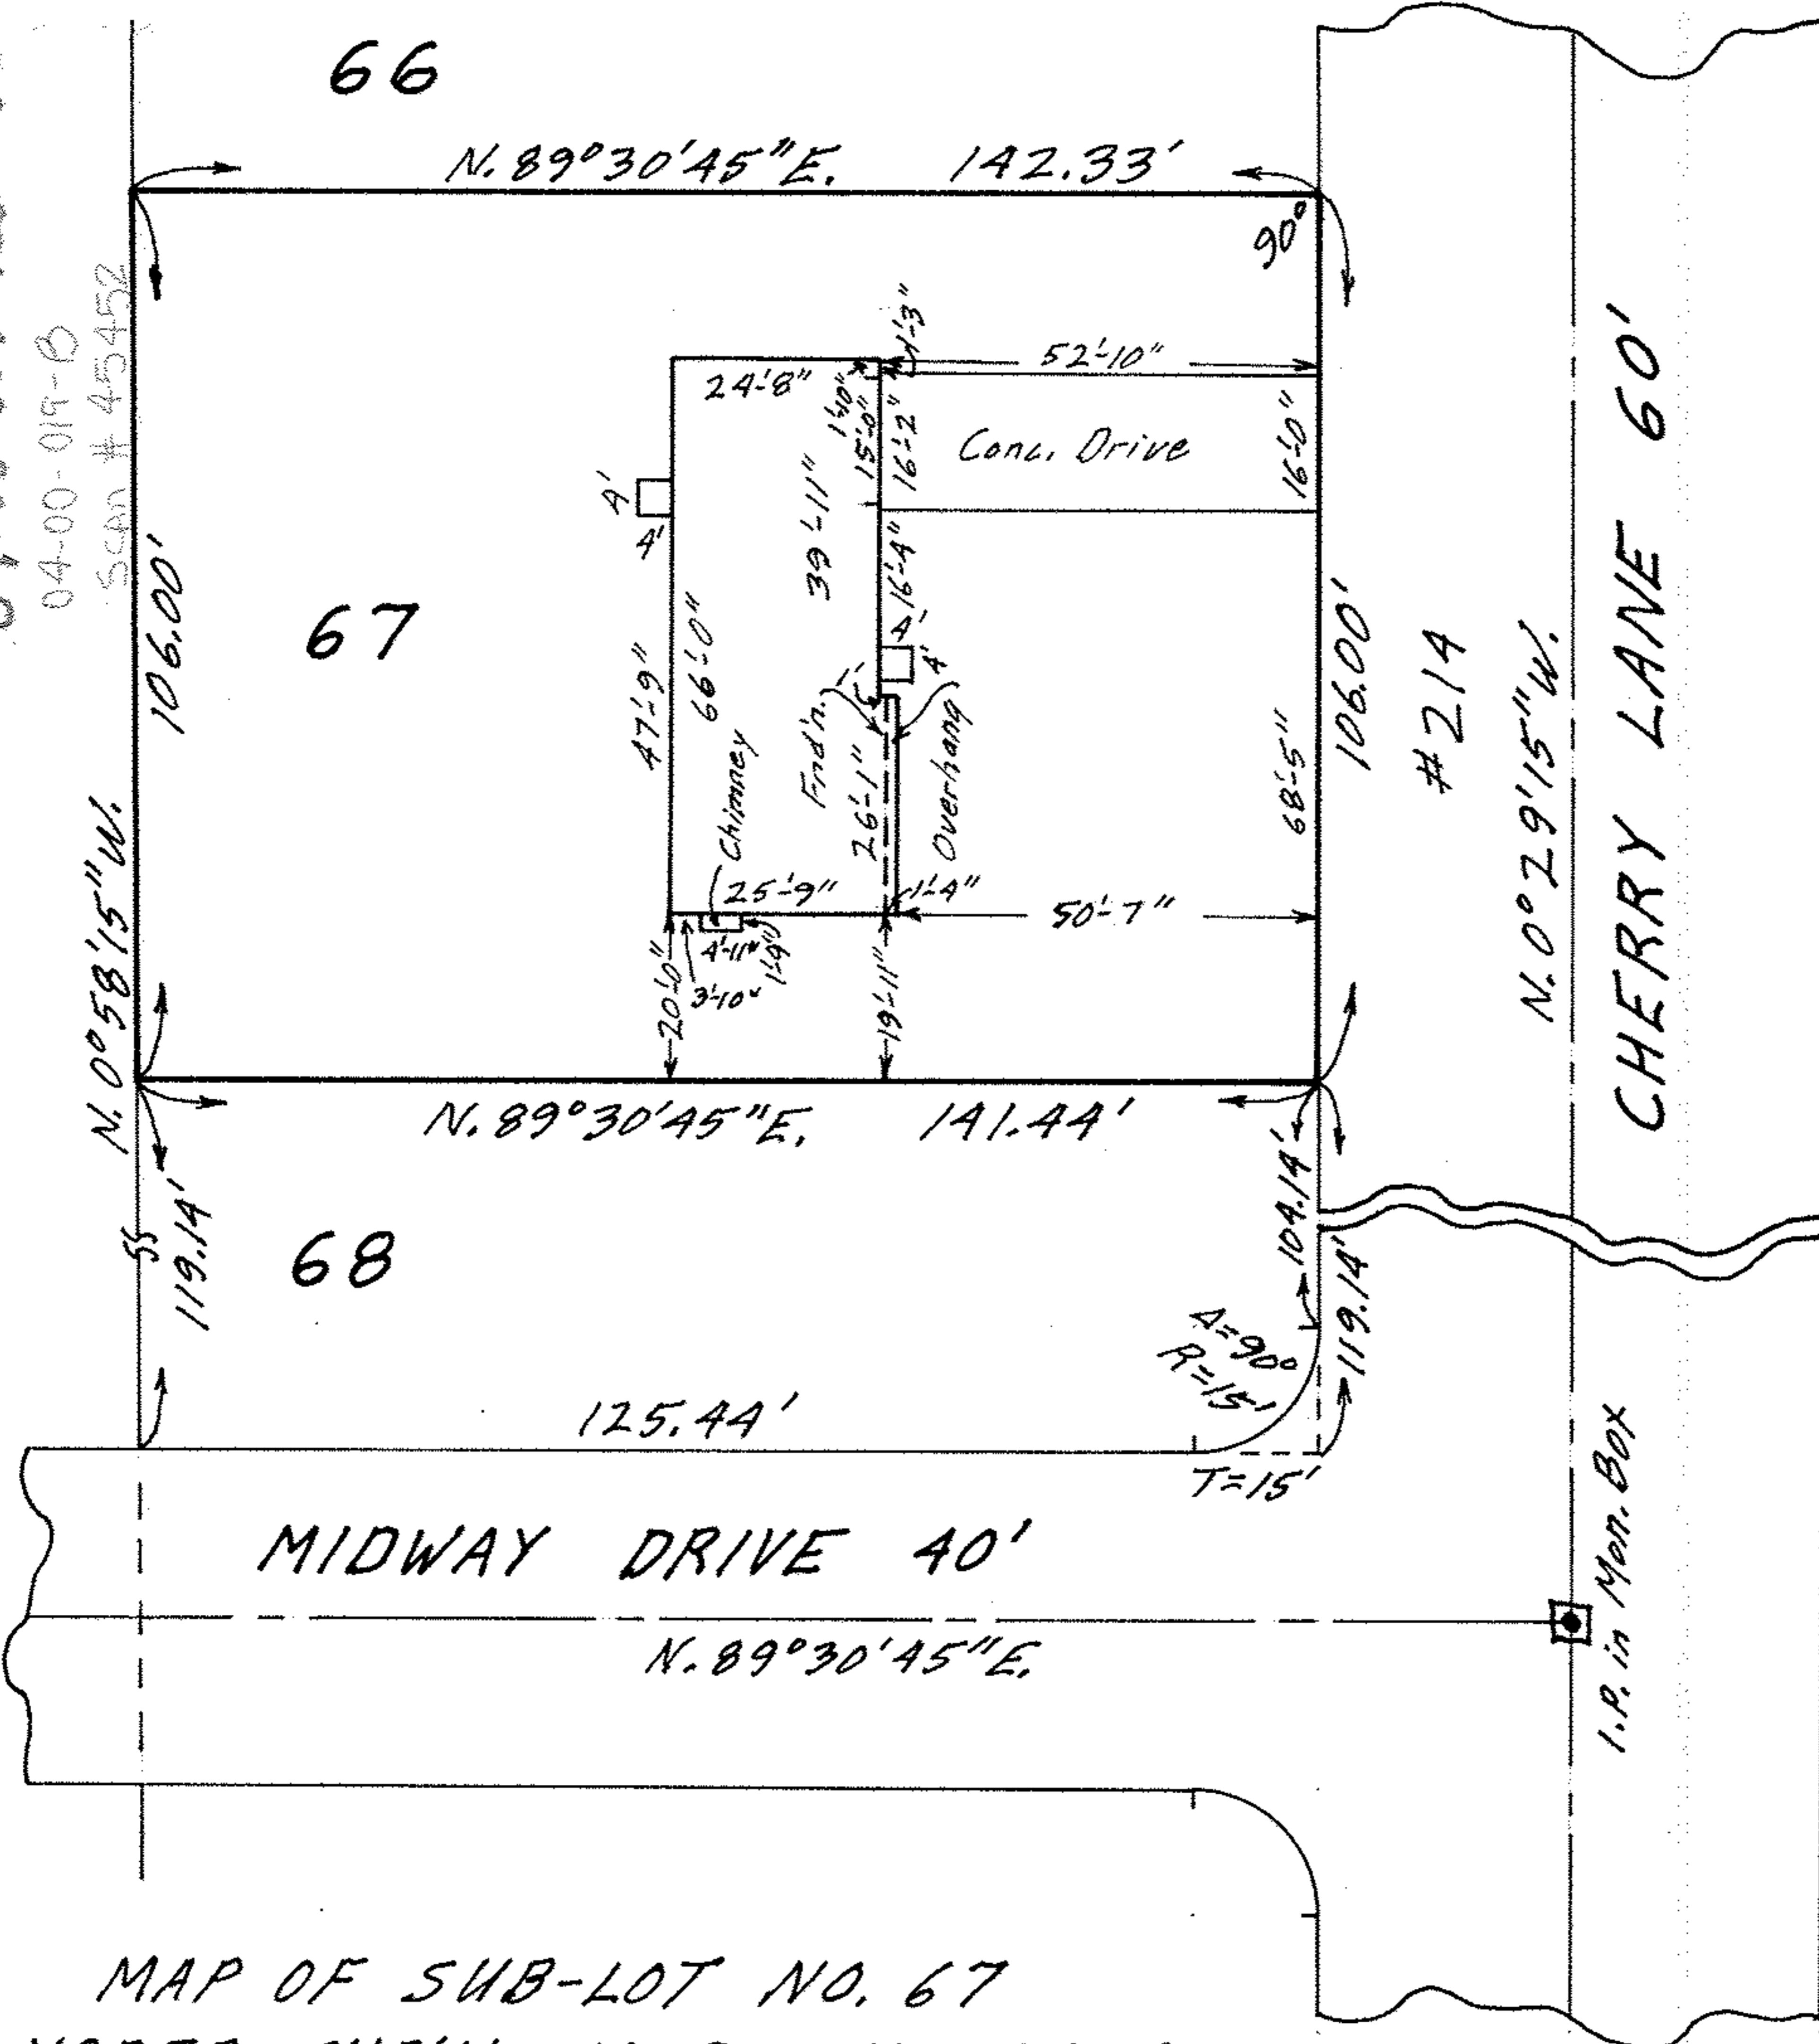

MAP OF SUB-LOT NO. 67
 YODER SUB'N. NO. 8 VOL. 24 PG. 43
 SECTION 19 AVON TOWNSHIP
 AVON LAKE CITY - LORAIN COUNTY - OHIO
 SCALE: 1" = 30' JULY 5-1968 3:00 P.M.
 Mary E. Penfound REG. SURVEYOR

Robert E. & Mary Lou Fortney