


MAP OF SUB-LOT NO. 36
 GILBERT FORTHOFFER'S SUB'N. NO. 5 Vol. 17 Pg. 21
 SECTION NO. 23 - AVON TOWNSHIP - AVON CITY
 LORAIN COUNTY OHIO

SCALE: 1" = 30' JUNE 6 - 1970 12:15 P.M.
 NOTE: There are no encroachments on this property.
 Gary E. Penfound REG. SURVEYOR NO. 4457

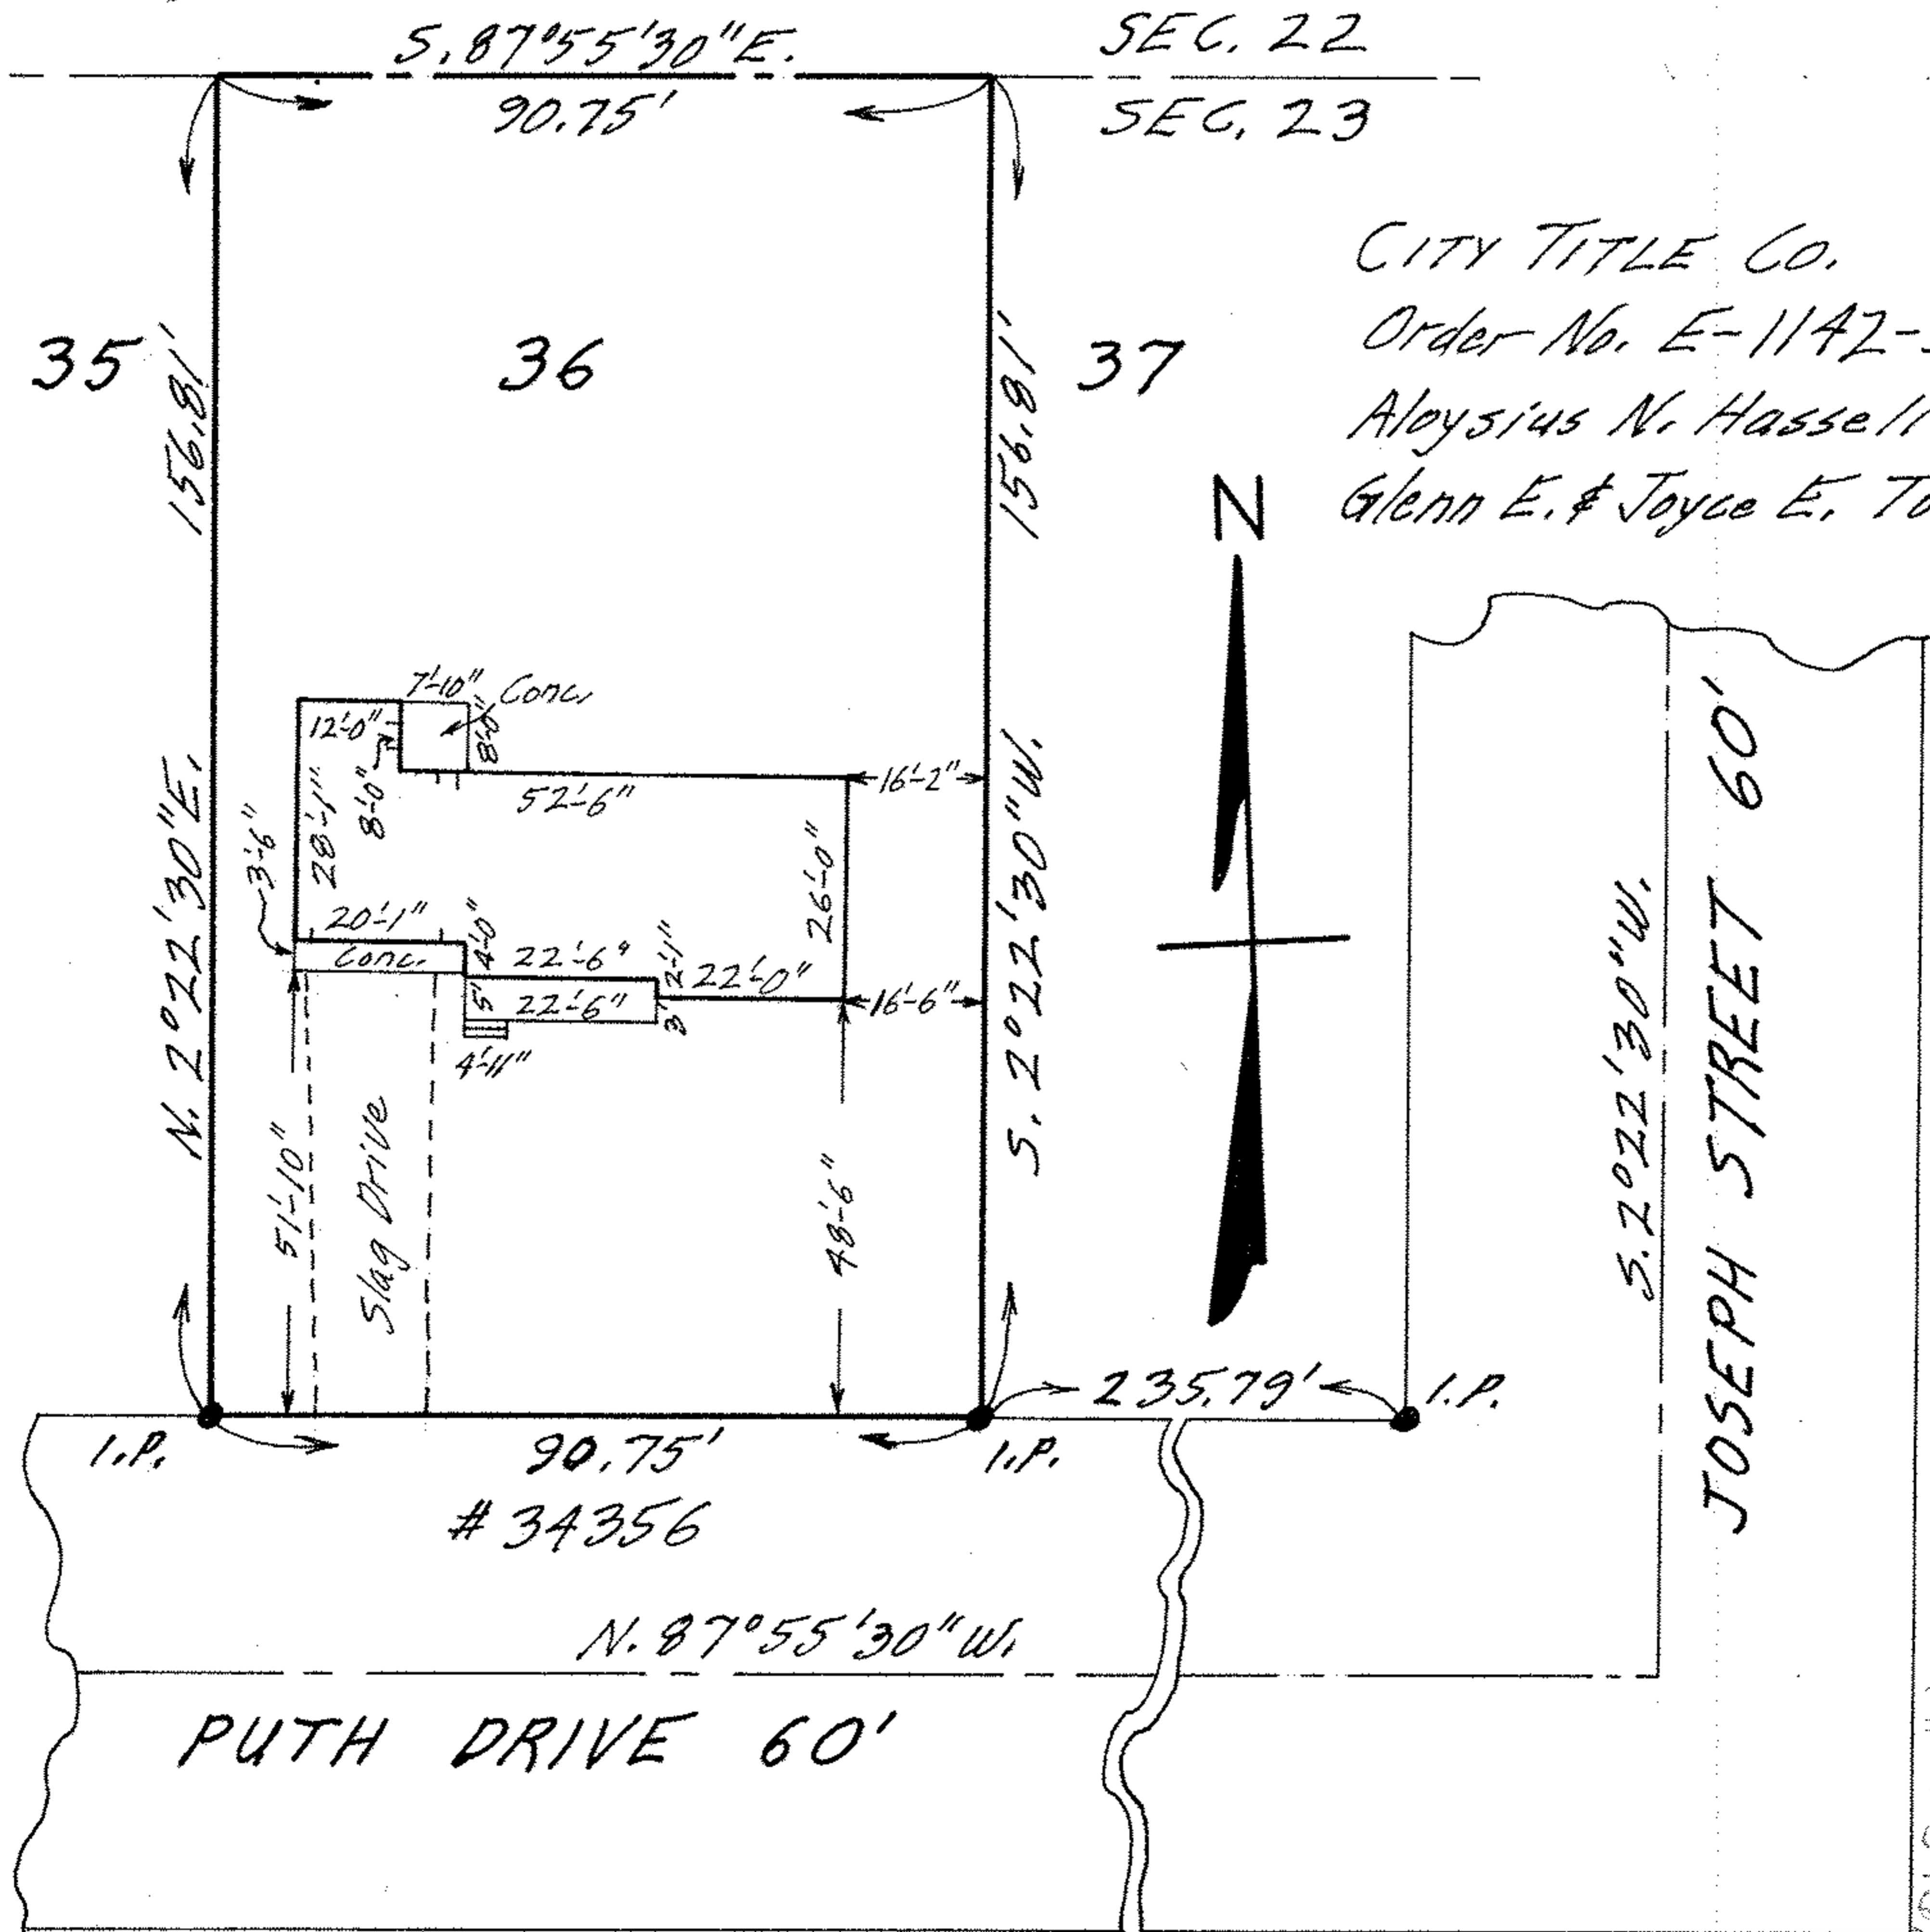

04-00-023-106-008
 04-00-023-C
 SCAN# 45462