


04-00-024-102-005

ROBERT D. MURRAY & CAROL MURRAY VOL. 1177 PG. 23

N 89°-27'-30"E 1598.27'

04-00-024-109-006

007

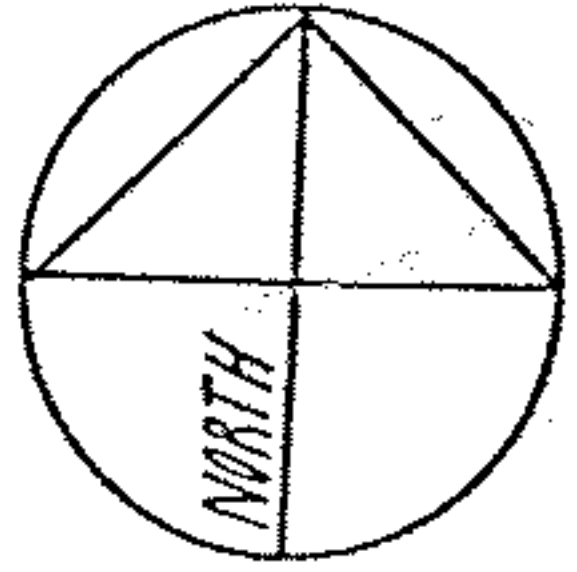

SCALE 1"=50'

AUGUST 1985

I.P. →

30.14'

211.86

~~16419~~

1356.27

I.P. ←

117.54'

- 059

~~0.58 A~~

0.67 A

138.90

117.01

S 0° 32' 30" E

138.90

222.97

S 89°-27'-30"W

RAY HENRY

VOL. 1196 PG. 858

P.P. 04-00-024-102-005

CITY OF AVON - COUNTY OF LORAIN

STATE OF OHIO

- 060

~~H 71 A~~

11.62 A

N 04°-53'-00"E 1186.18'

336.83'

JAYCOX ROAD 60'

219.29

need the additional  
radiations

1358/631


347.65'

S 00°-49'-32"E

AVON MEADOWS SUBDIVISION VOL. 23 PG. 29 'MAP REG.

#16419

APPROVED
LORAIN CO.
MAP DEPT.
DATE 10-21-85
PAGE 4-00-024-A
BY C. FRANCIS
VOID AFTER

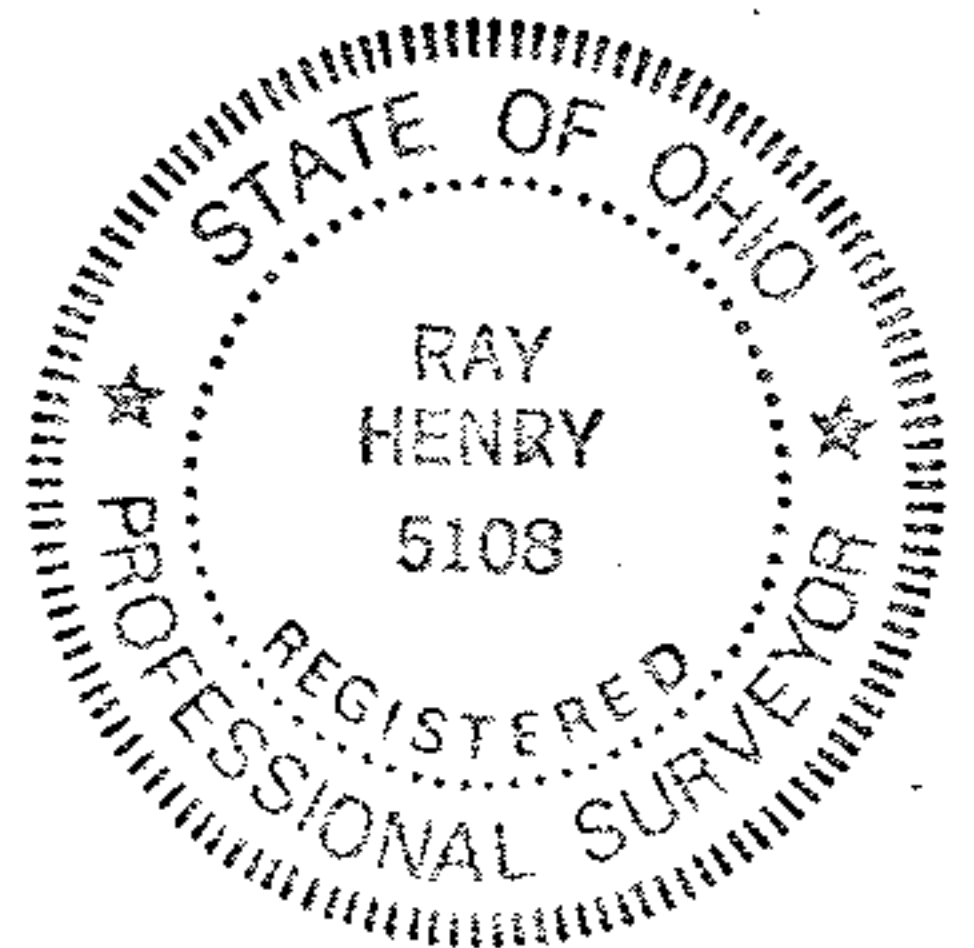

I.P. →

S 89°-53'-30"W

1631.88'

I.P. ←

AV-HILL CO VOL. 1108 PG. 304

← STONE IN MON. BOX USED

A  
B  
C