
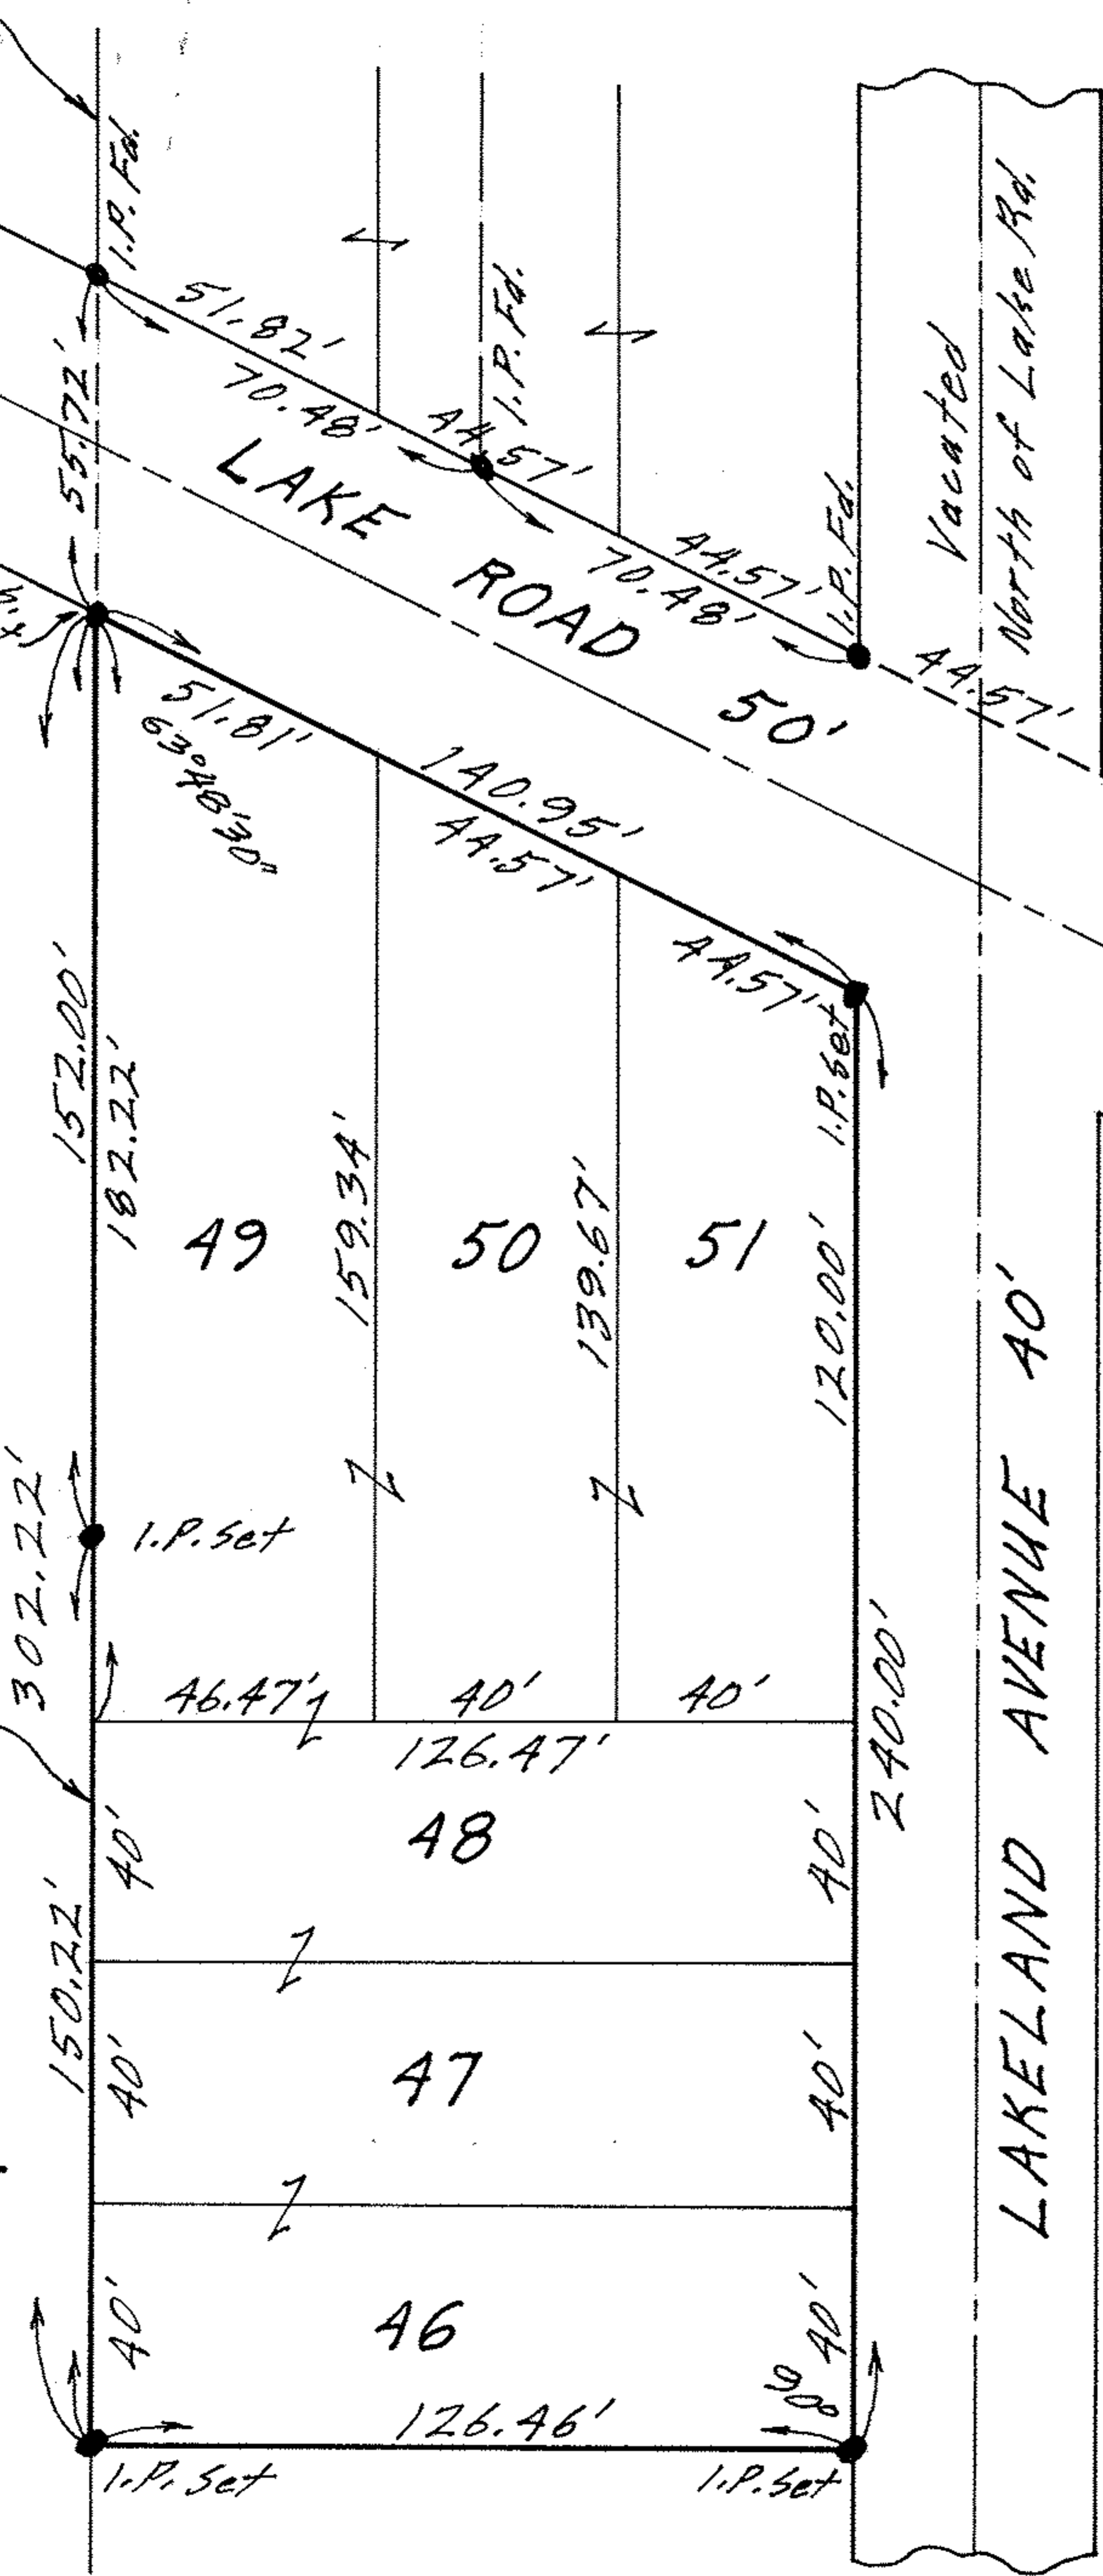


04-00-030-704-017-2021

04-00-030-C SCAN # 45475

Westerly Line LAKE BREEZE

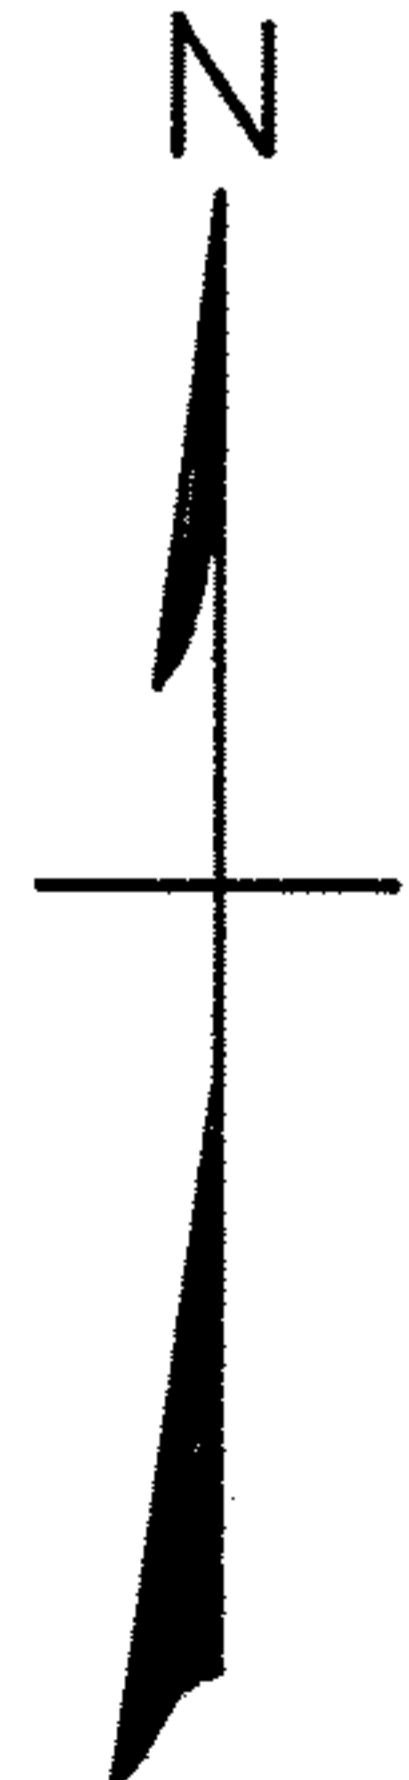

PLAT OF SURVEY FOR
 WILLIAM & ADA MORRIS
 SUB-LOTS 46-47-48-49-50 & 51 OF
 LAKE BREEZE ALLT. Vol. 7 Pg. 33

AVON LAKE CITY
 LORAIN COUNTY OHIO

SCALE: 1" = 40' SEPT. 22-1967

Gary E. Penfound Reg. Surveyor No. 4457