
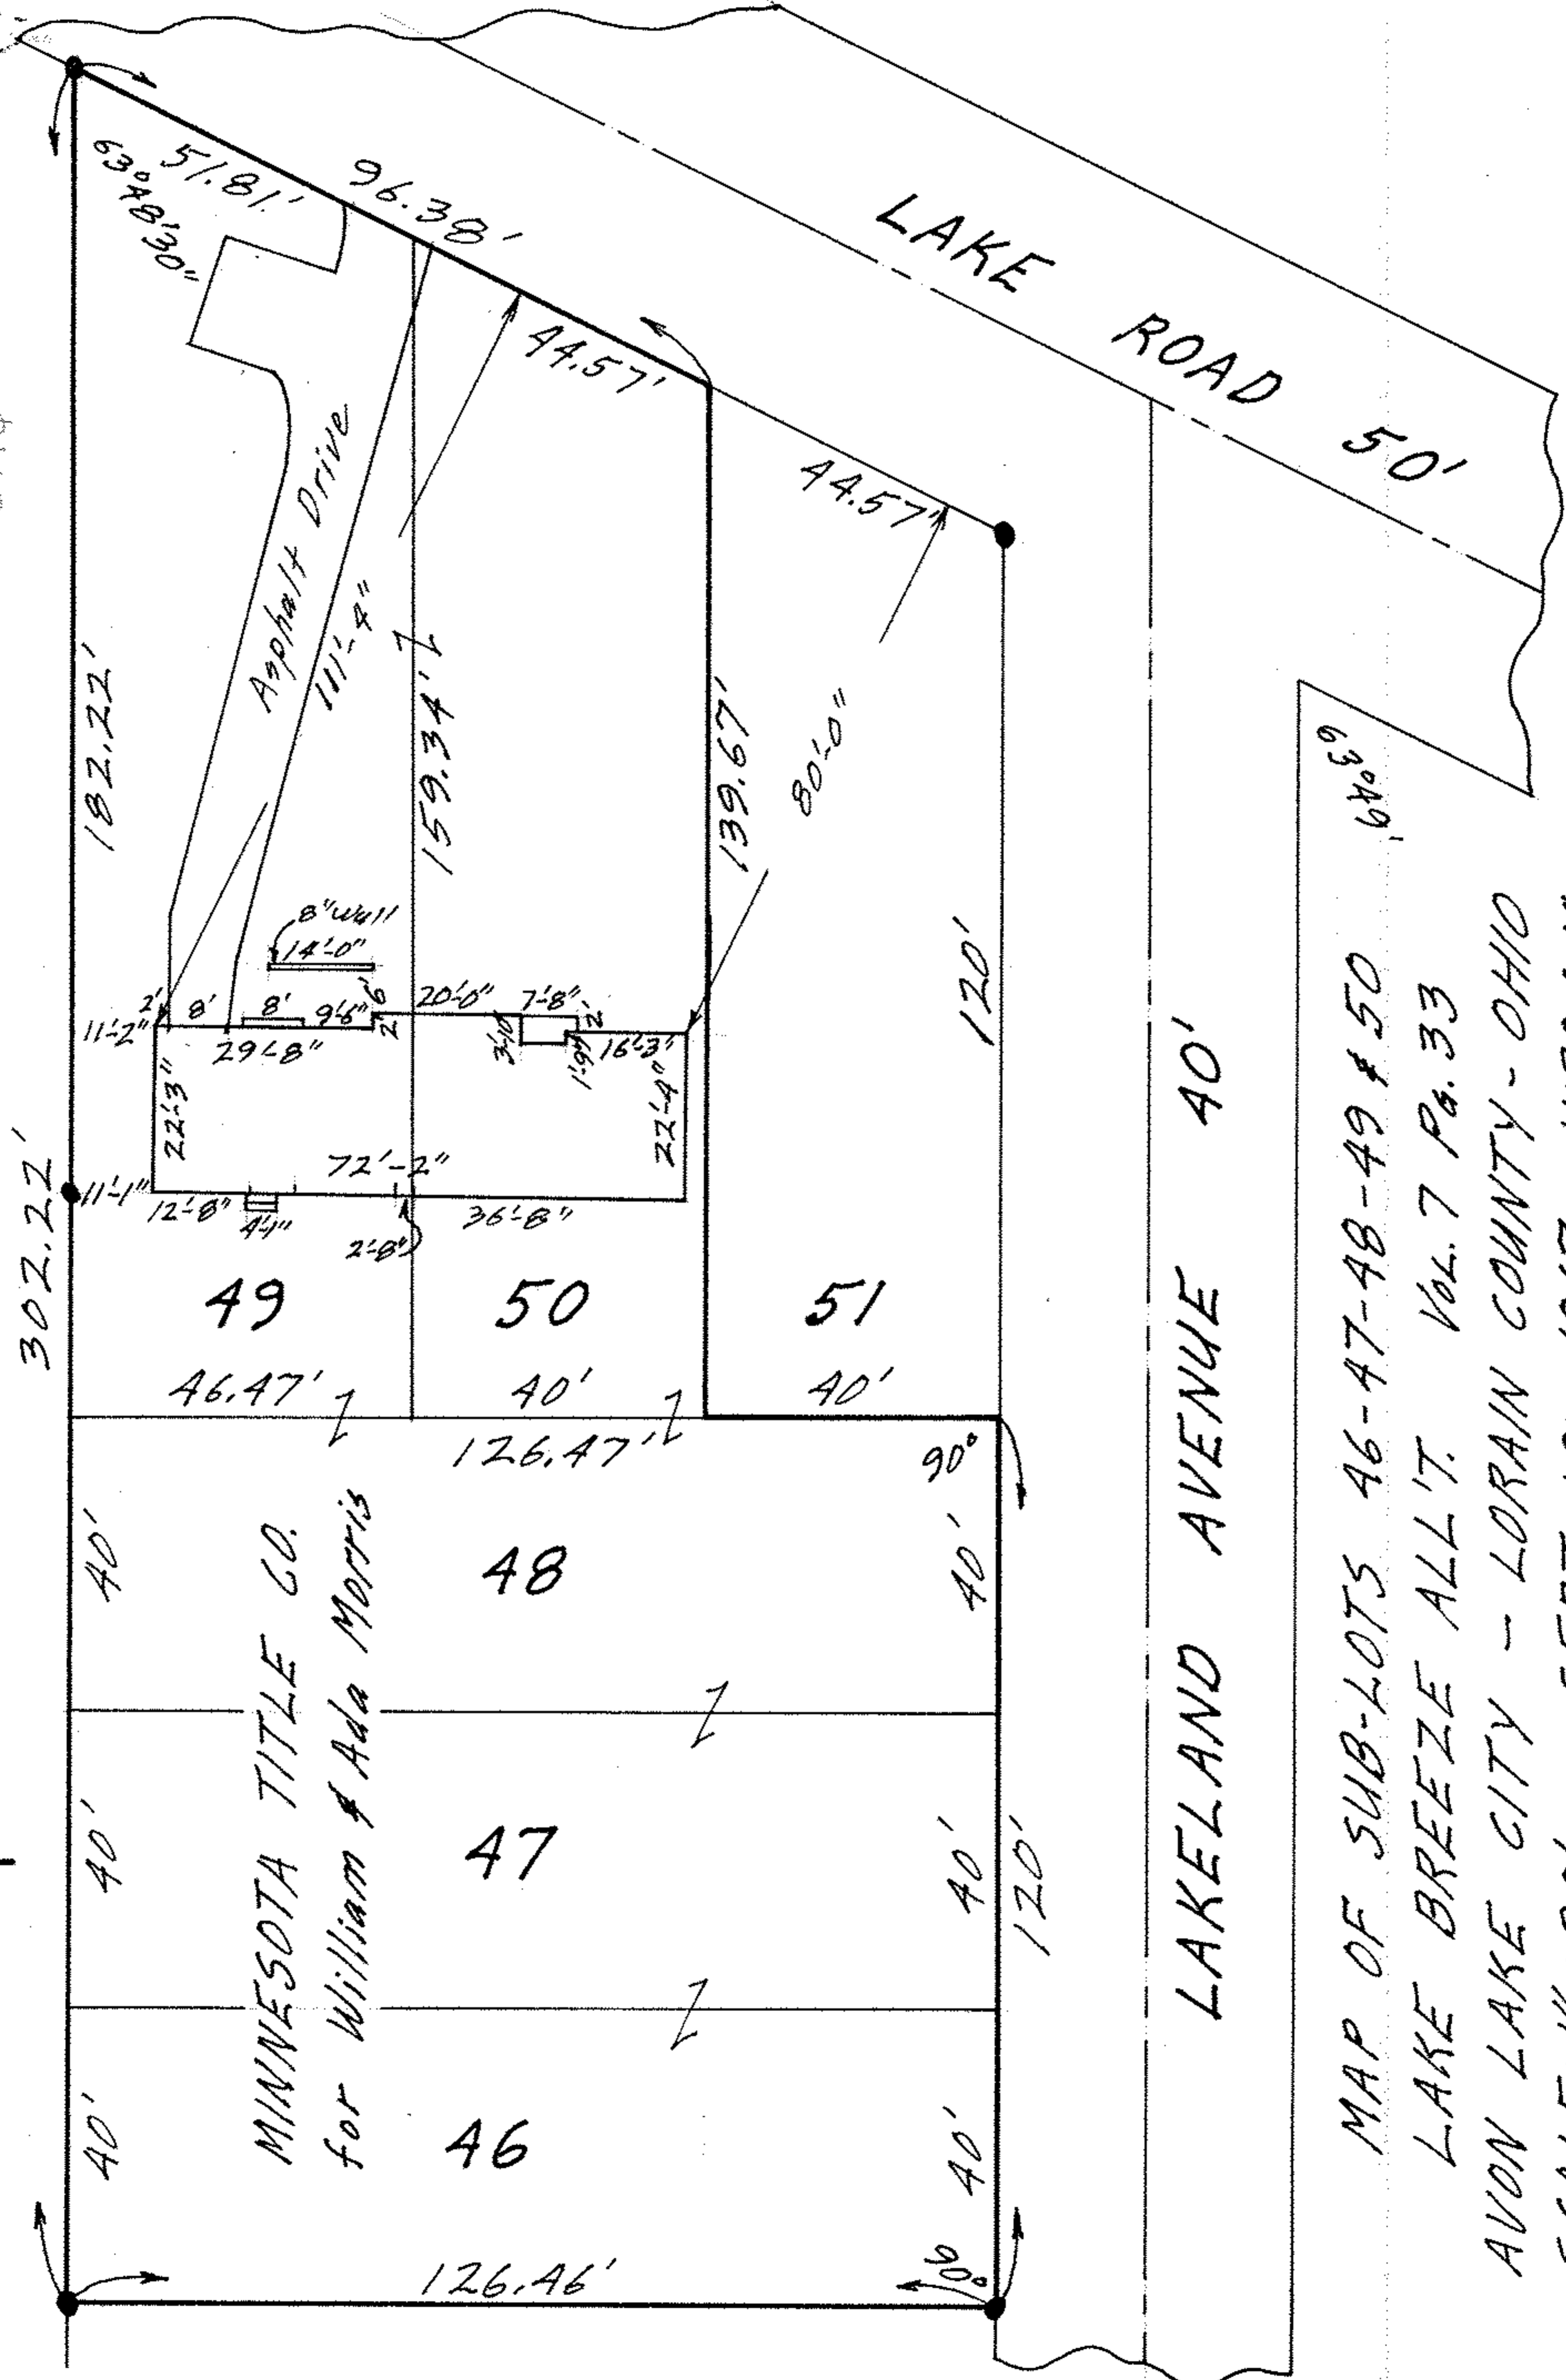


04-00-030-104-017-021
04-00-030-C SSAN# 45476

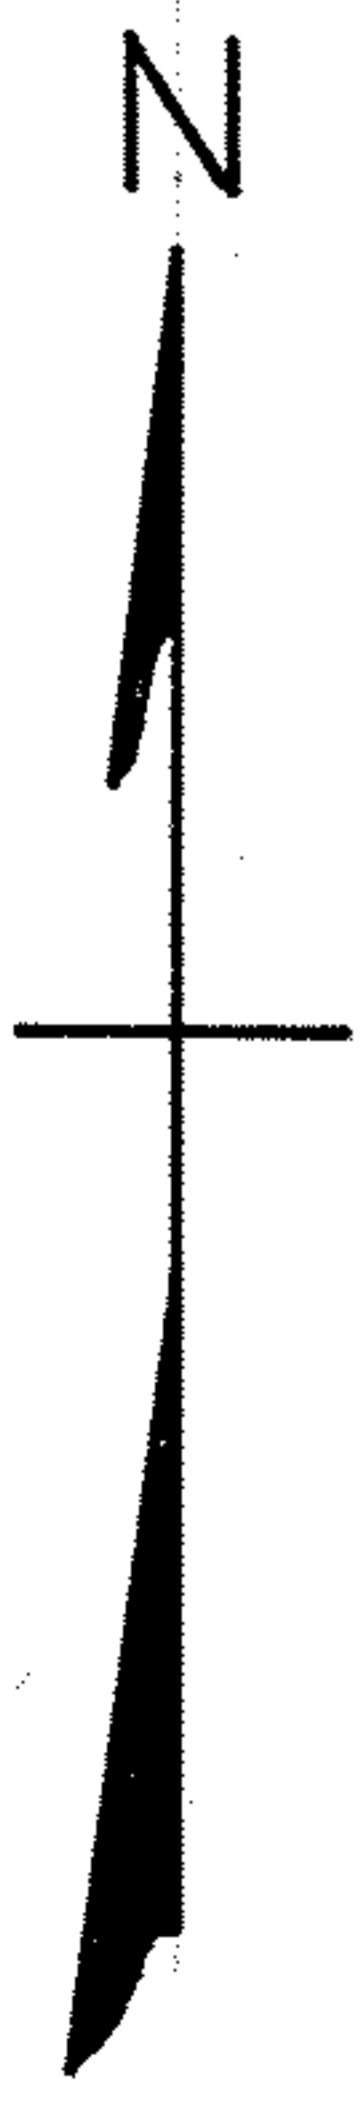

MINNESOTA TITLE CO.
for William & Ada Morris

LAKELAND AVENUE 40'

MAP OF SUB-LOTS 46-47-48-49 & 50
LAKE BREEZE ALL'T. Vol. 7 Pg. 33
AVON LAKE CITY - LORAIN COUNTY - OHIO
SCALE: 1"=30' SEPT. 18 - 1967 11:30 A.M.
Gary E. Penfound REG. SURVEYOR