


04-00-030-127-025
04-00-030-B
SCAN # 45482

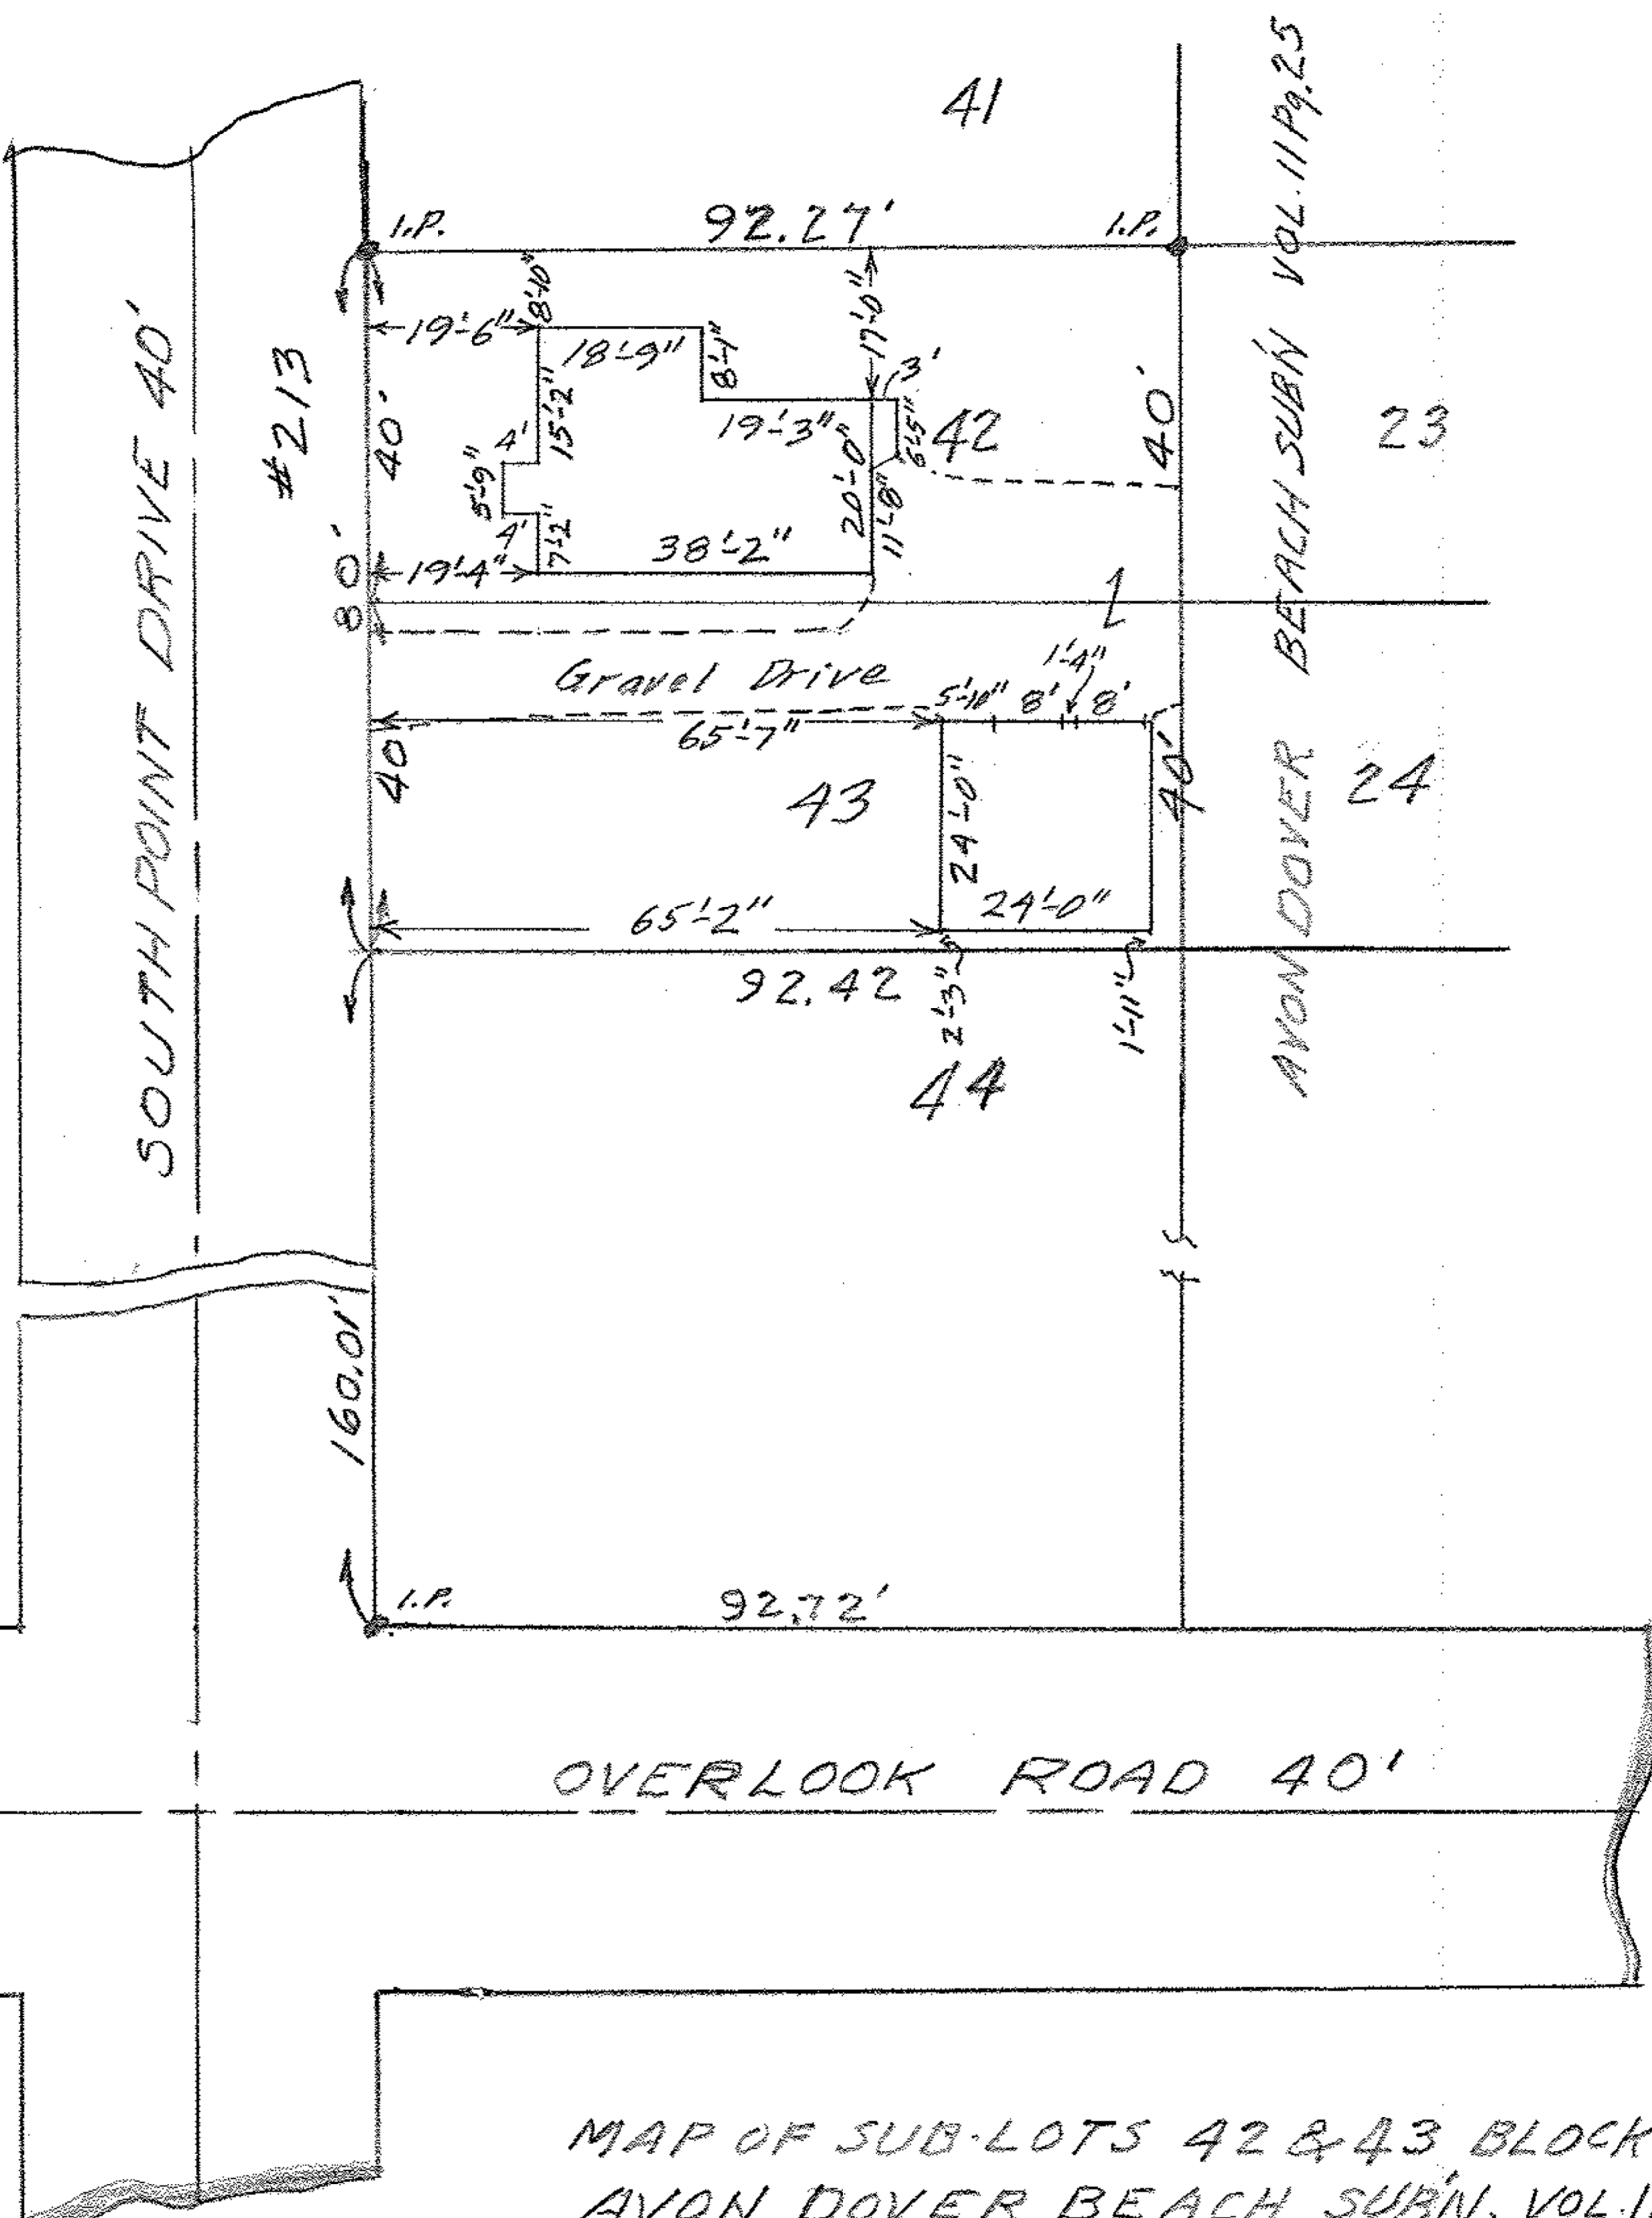

MAP OF SUB-LOTS 42 & 43 BLOCK 3
 AVON DOVER BEACH SUBN, VOL. 11 P. 27.
 SECTION 30-AVON TWP.-CITY OF AVON LAKE.
 LORAIN COUNTY-OHIO.
 Scale 1" = 30' APRIL 29-1964 7:30 P.M.
 Gary E. Penfound REG. SURVEYORS
 for C. E. Penfound

E-13158 James & Carolyn A. McMullen