



KLEINOEDER-SCHMIDT

and ASSOCIATES

ENGINEERS — SURVEYORS — CONSULTANTS IN LAND PLANNING

ELYRIA - NORWALK - MEDINA

OHIO

SURVEY

Sublot(s) #16341

Subd'n

APPROVED	DATE	BY	VOID AFTER
LORAIN CO.	8-27-85	C. F. A. MOIS	
MAP DEPT.			
	PAGE		
	4-D		

Township AVON

Tract

Orig. Lots

Sec. 30


County of LOBAIN

State of Ohio

Corporation CITY OF AVON LAKE

04-00-030-141-054, -055, -056 16341

020-123-141-080-00-40
NORTH
089 174
055 D.V. 1226 P. 694 (29.58 AC.)
022A ? 101M02-1500 1/4 1/4

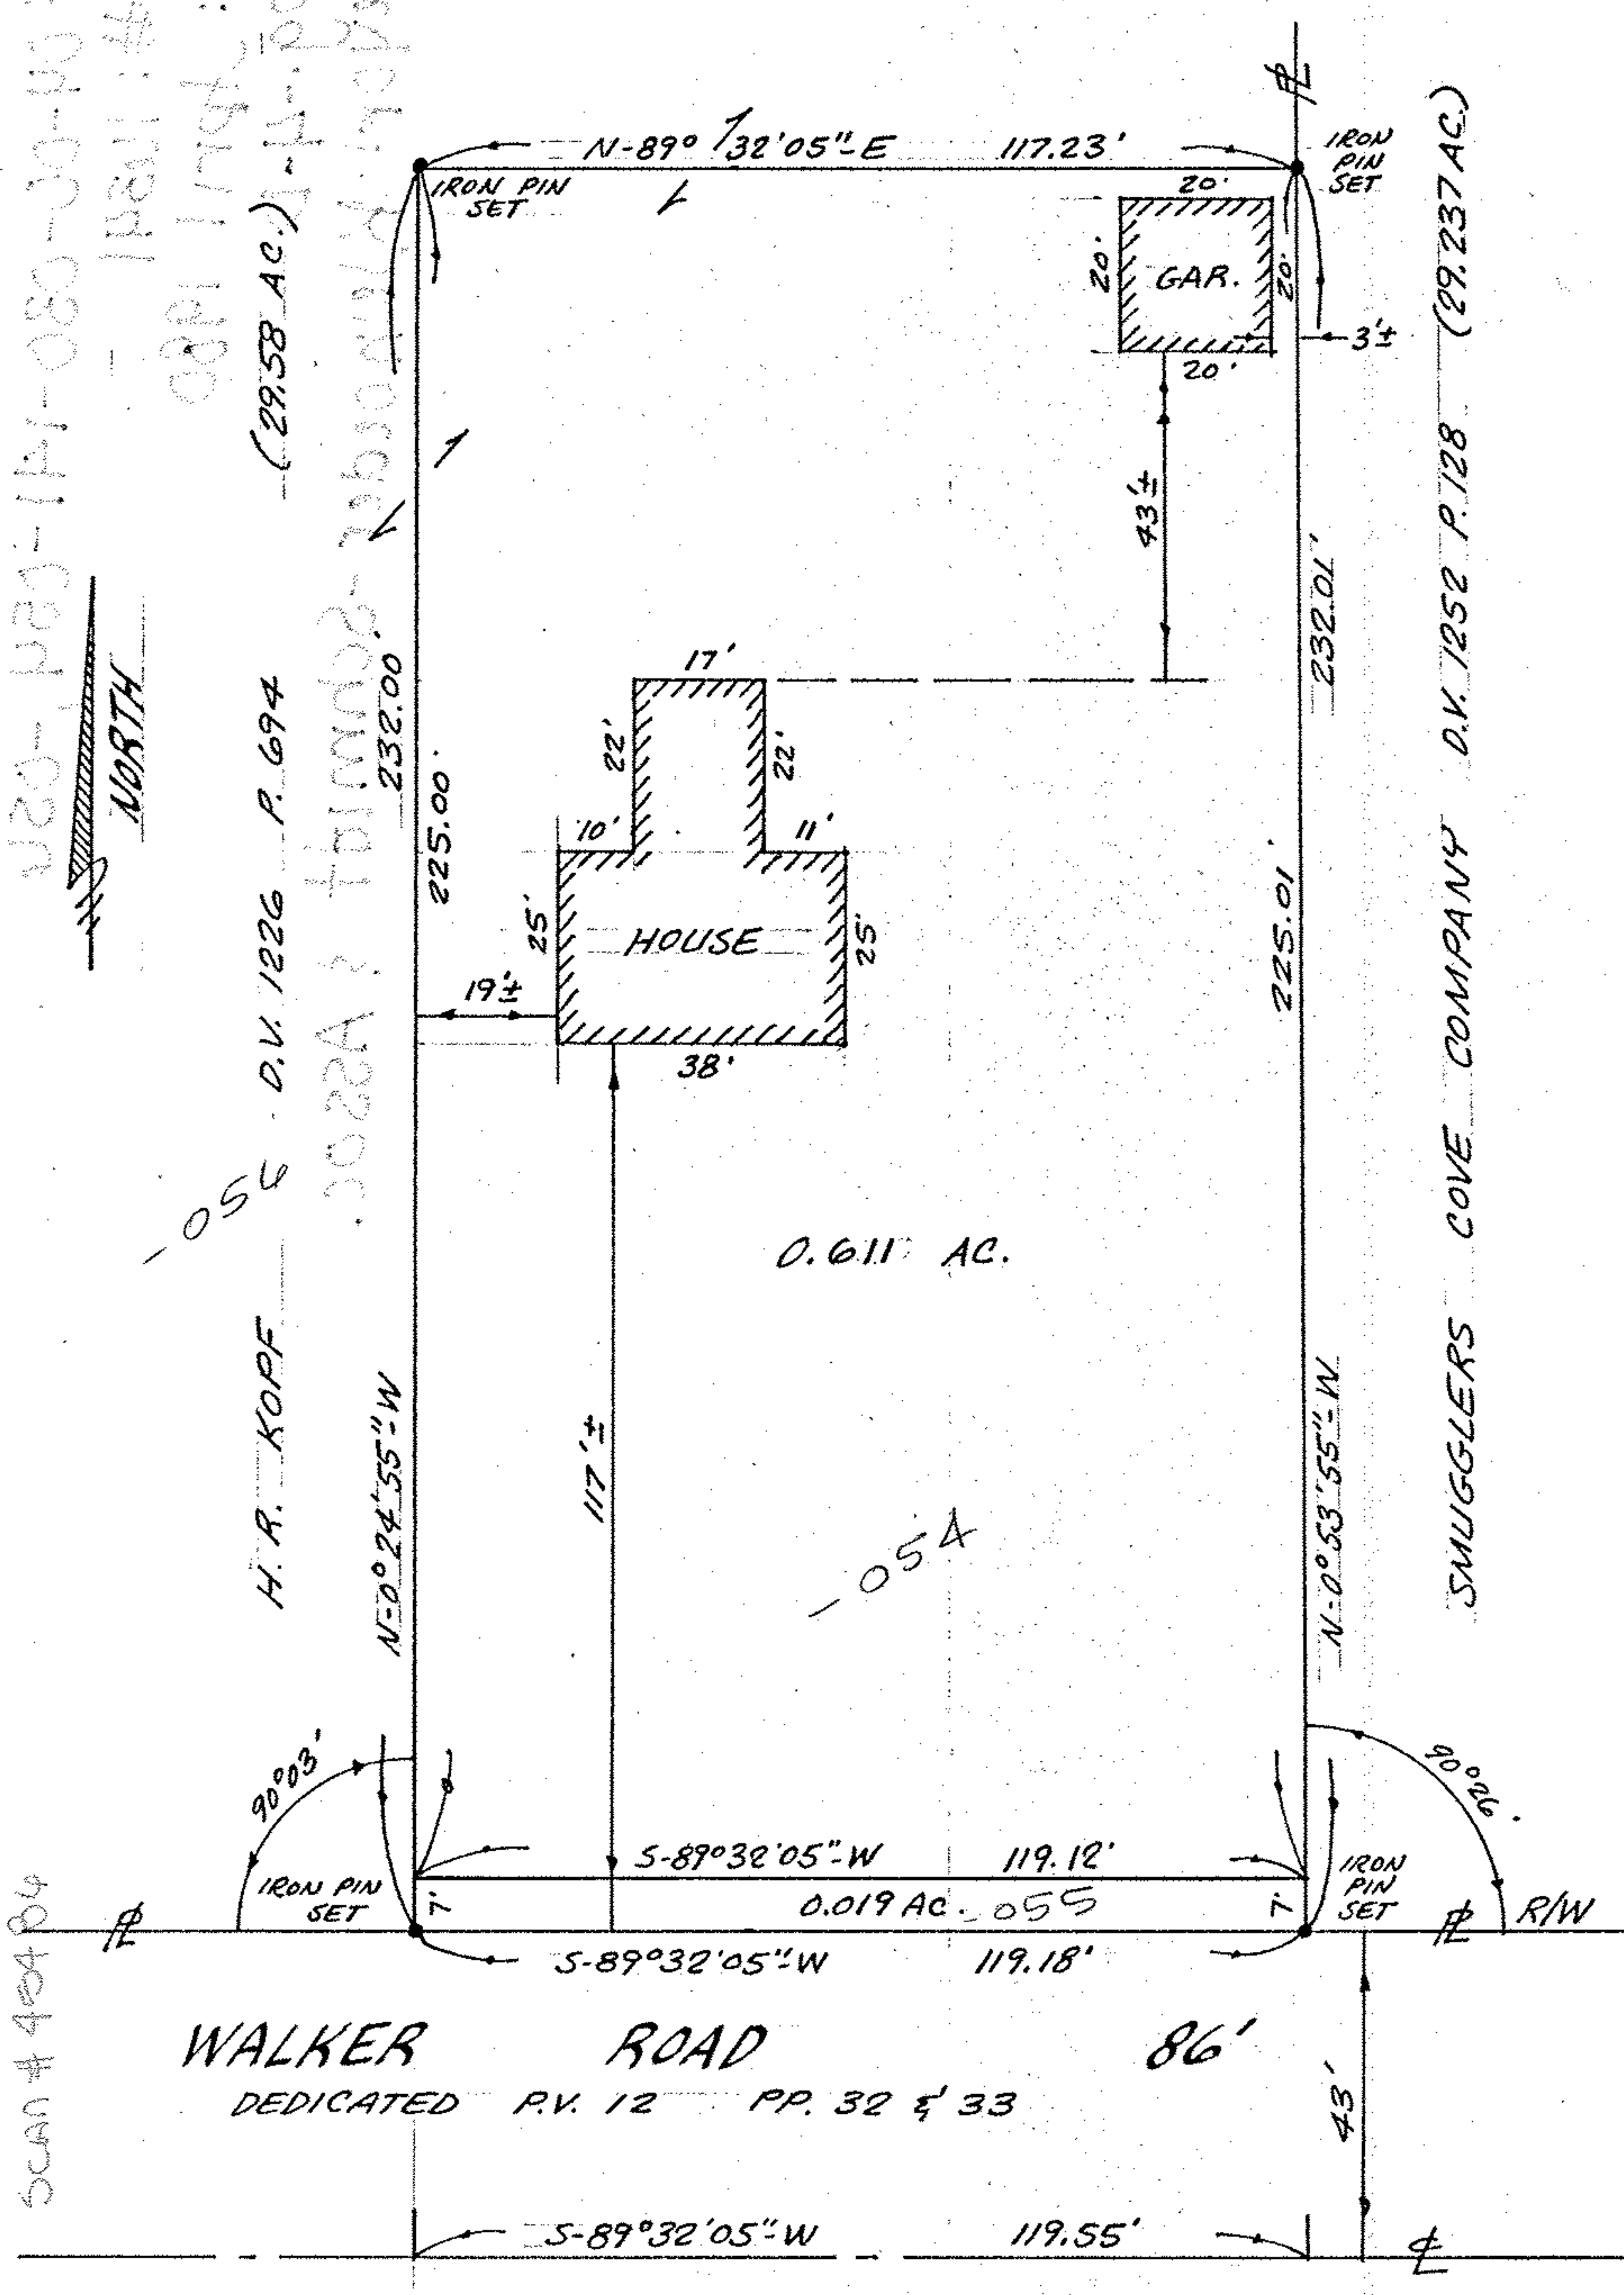

WALKER ROAD
DEDICATED P.V. 12 PP. 32 & 33

SMUGGLERS COVE COMPANY D.V. 1252 P. 128 (29.237 AC.)

Prepared for: H. R. KOPF

Scale: 1" = 30'

Date: APR. 23, 1980

Dr. by: DE

Job No 78-15

REV. 8-8-85