
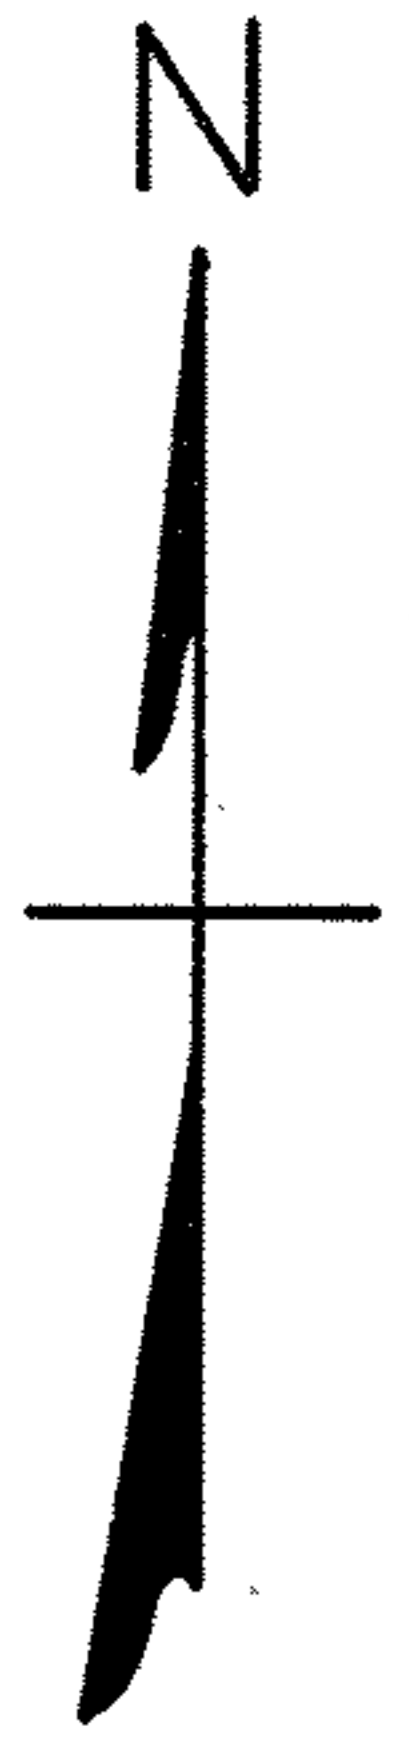


05-00-012-102-004
05-00-012-A
Scan # 45529

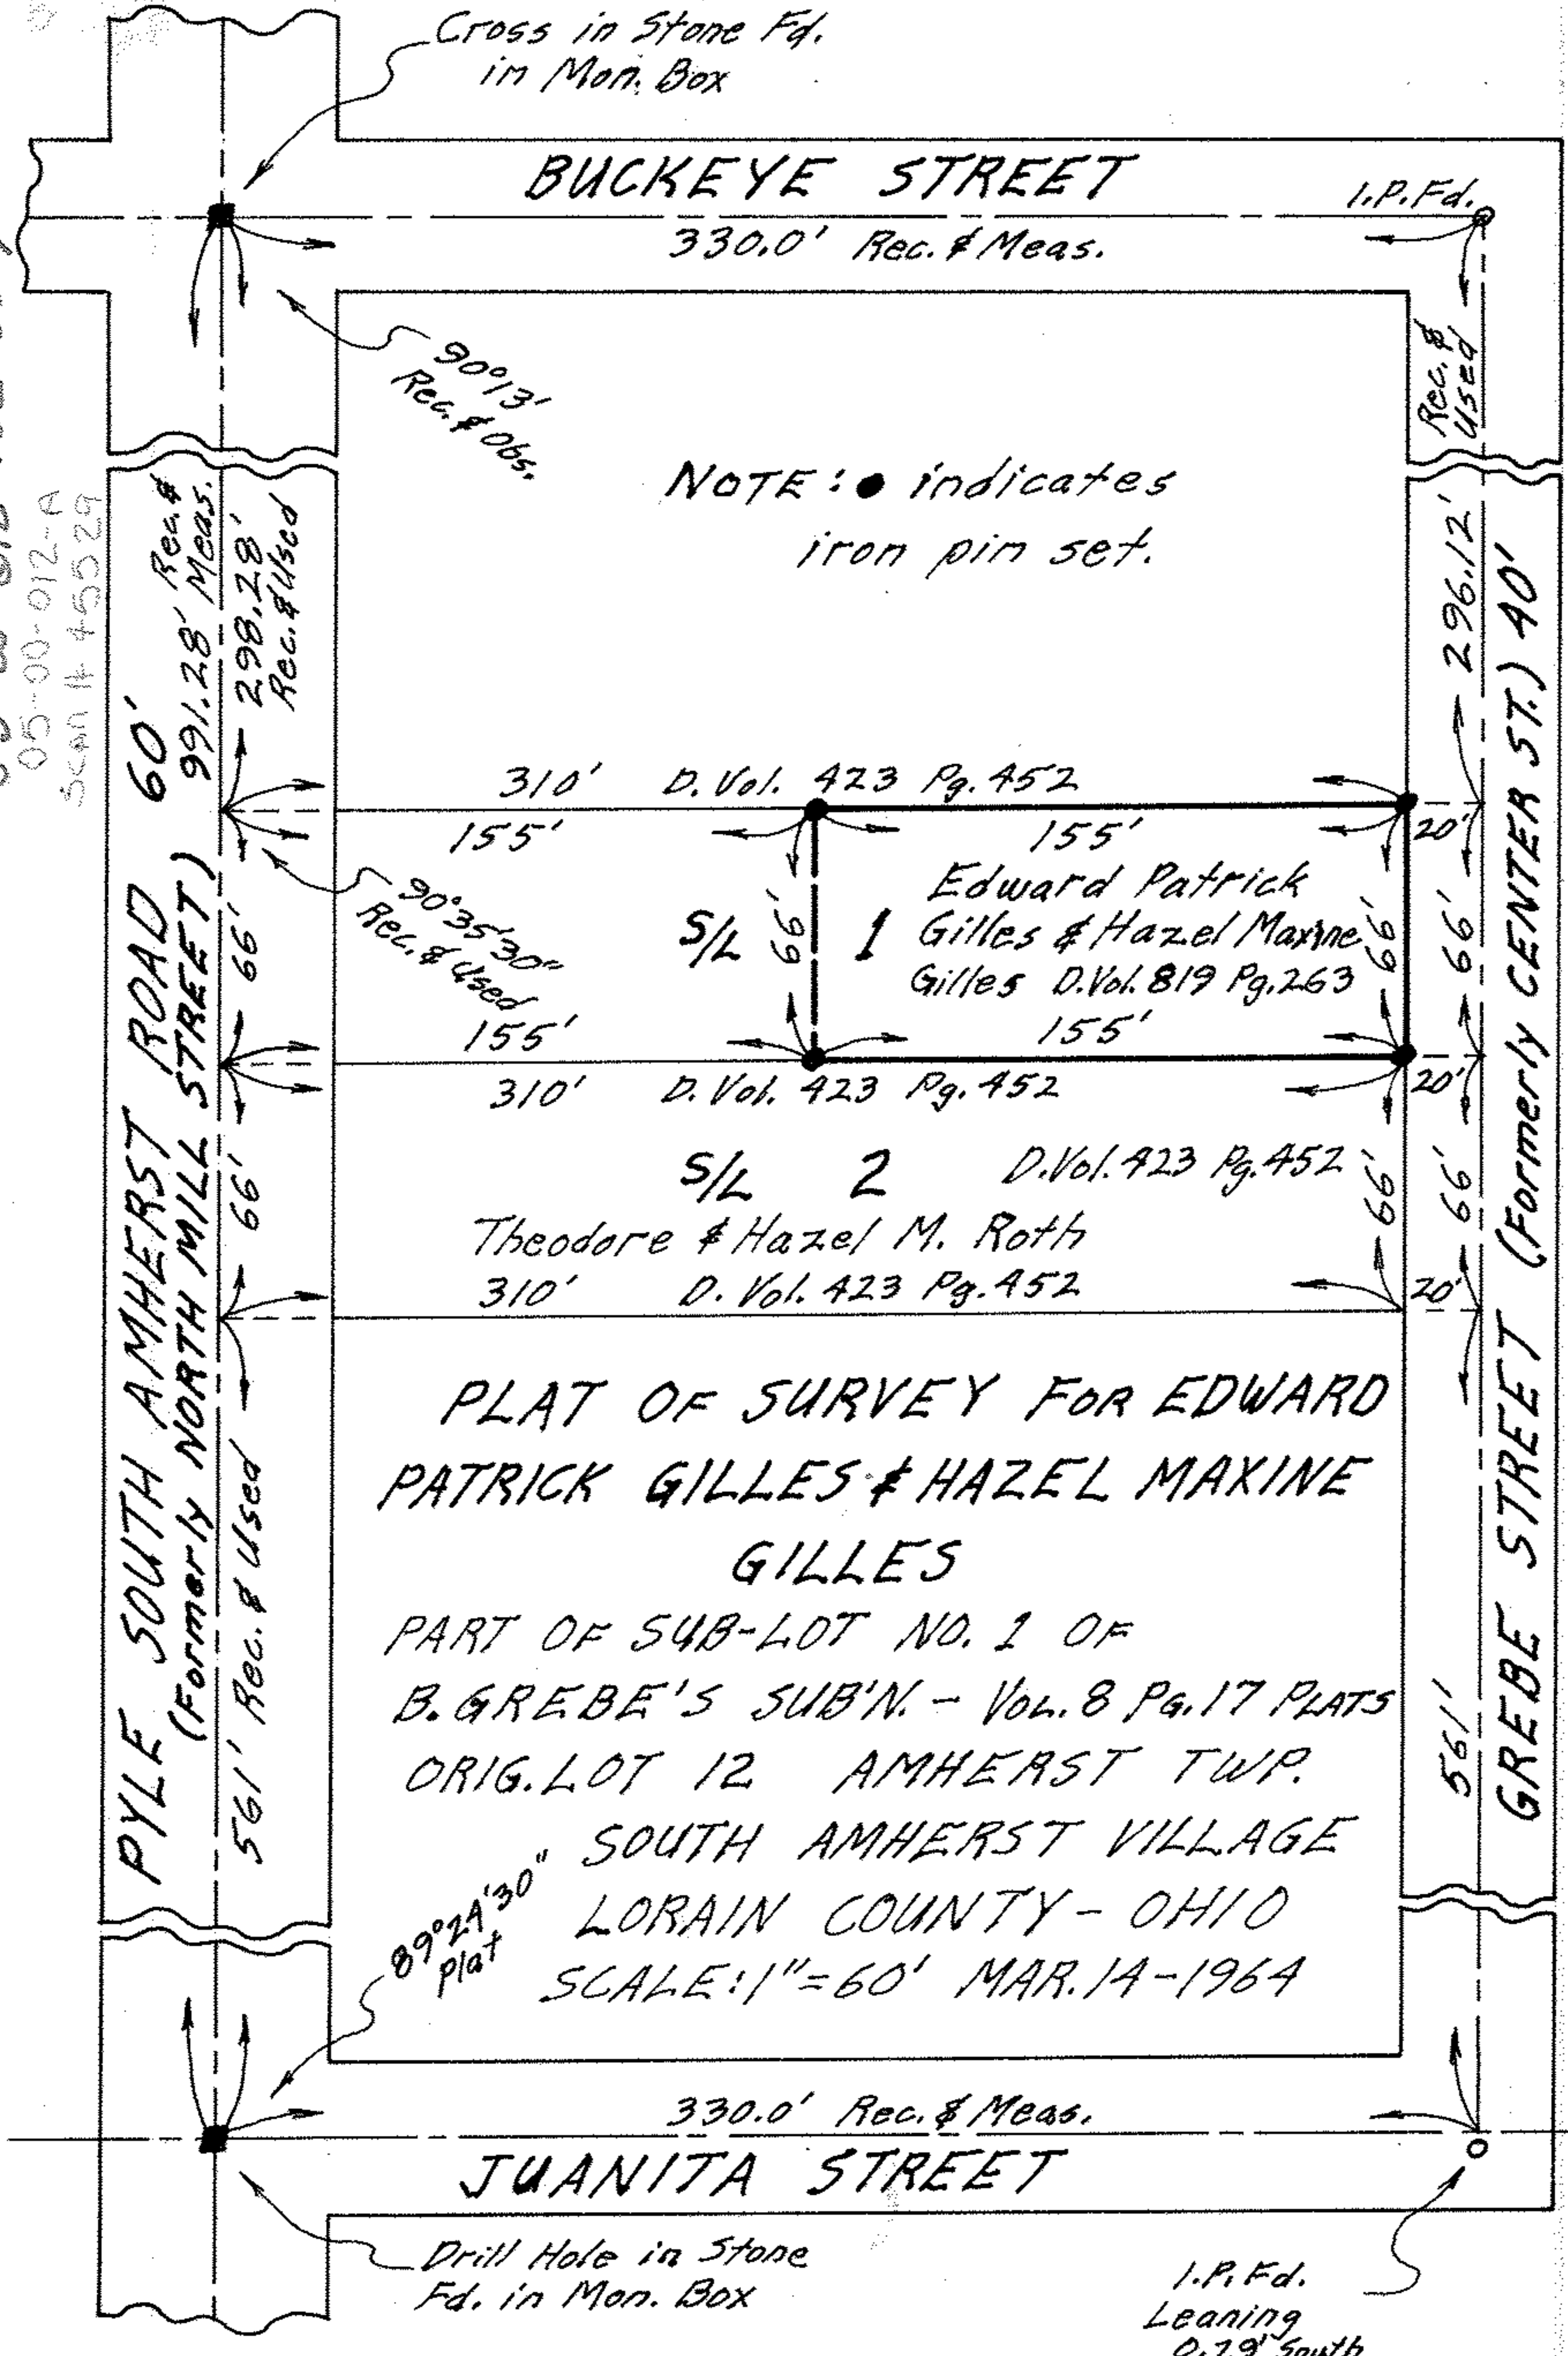

Gary E. Penfound
Reg. Surveyor No. 4457

O.L. 12
O.L. 11