


DS-00-004-113-009

5

1" = 20'

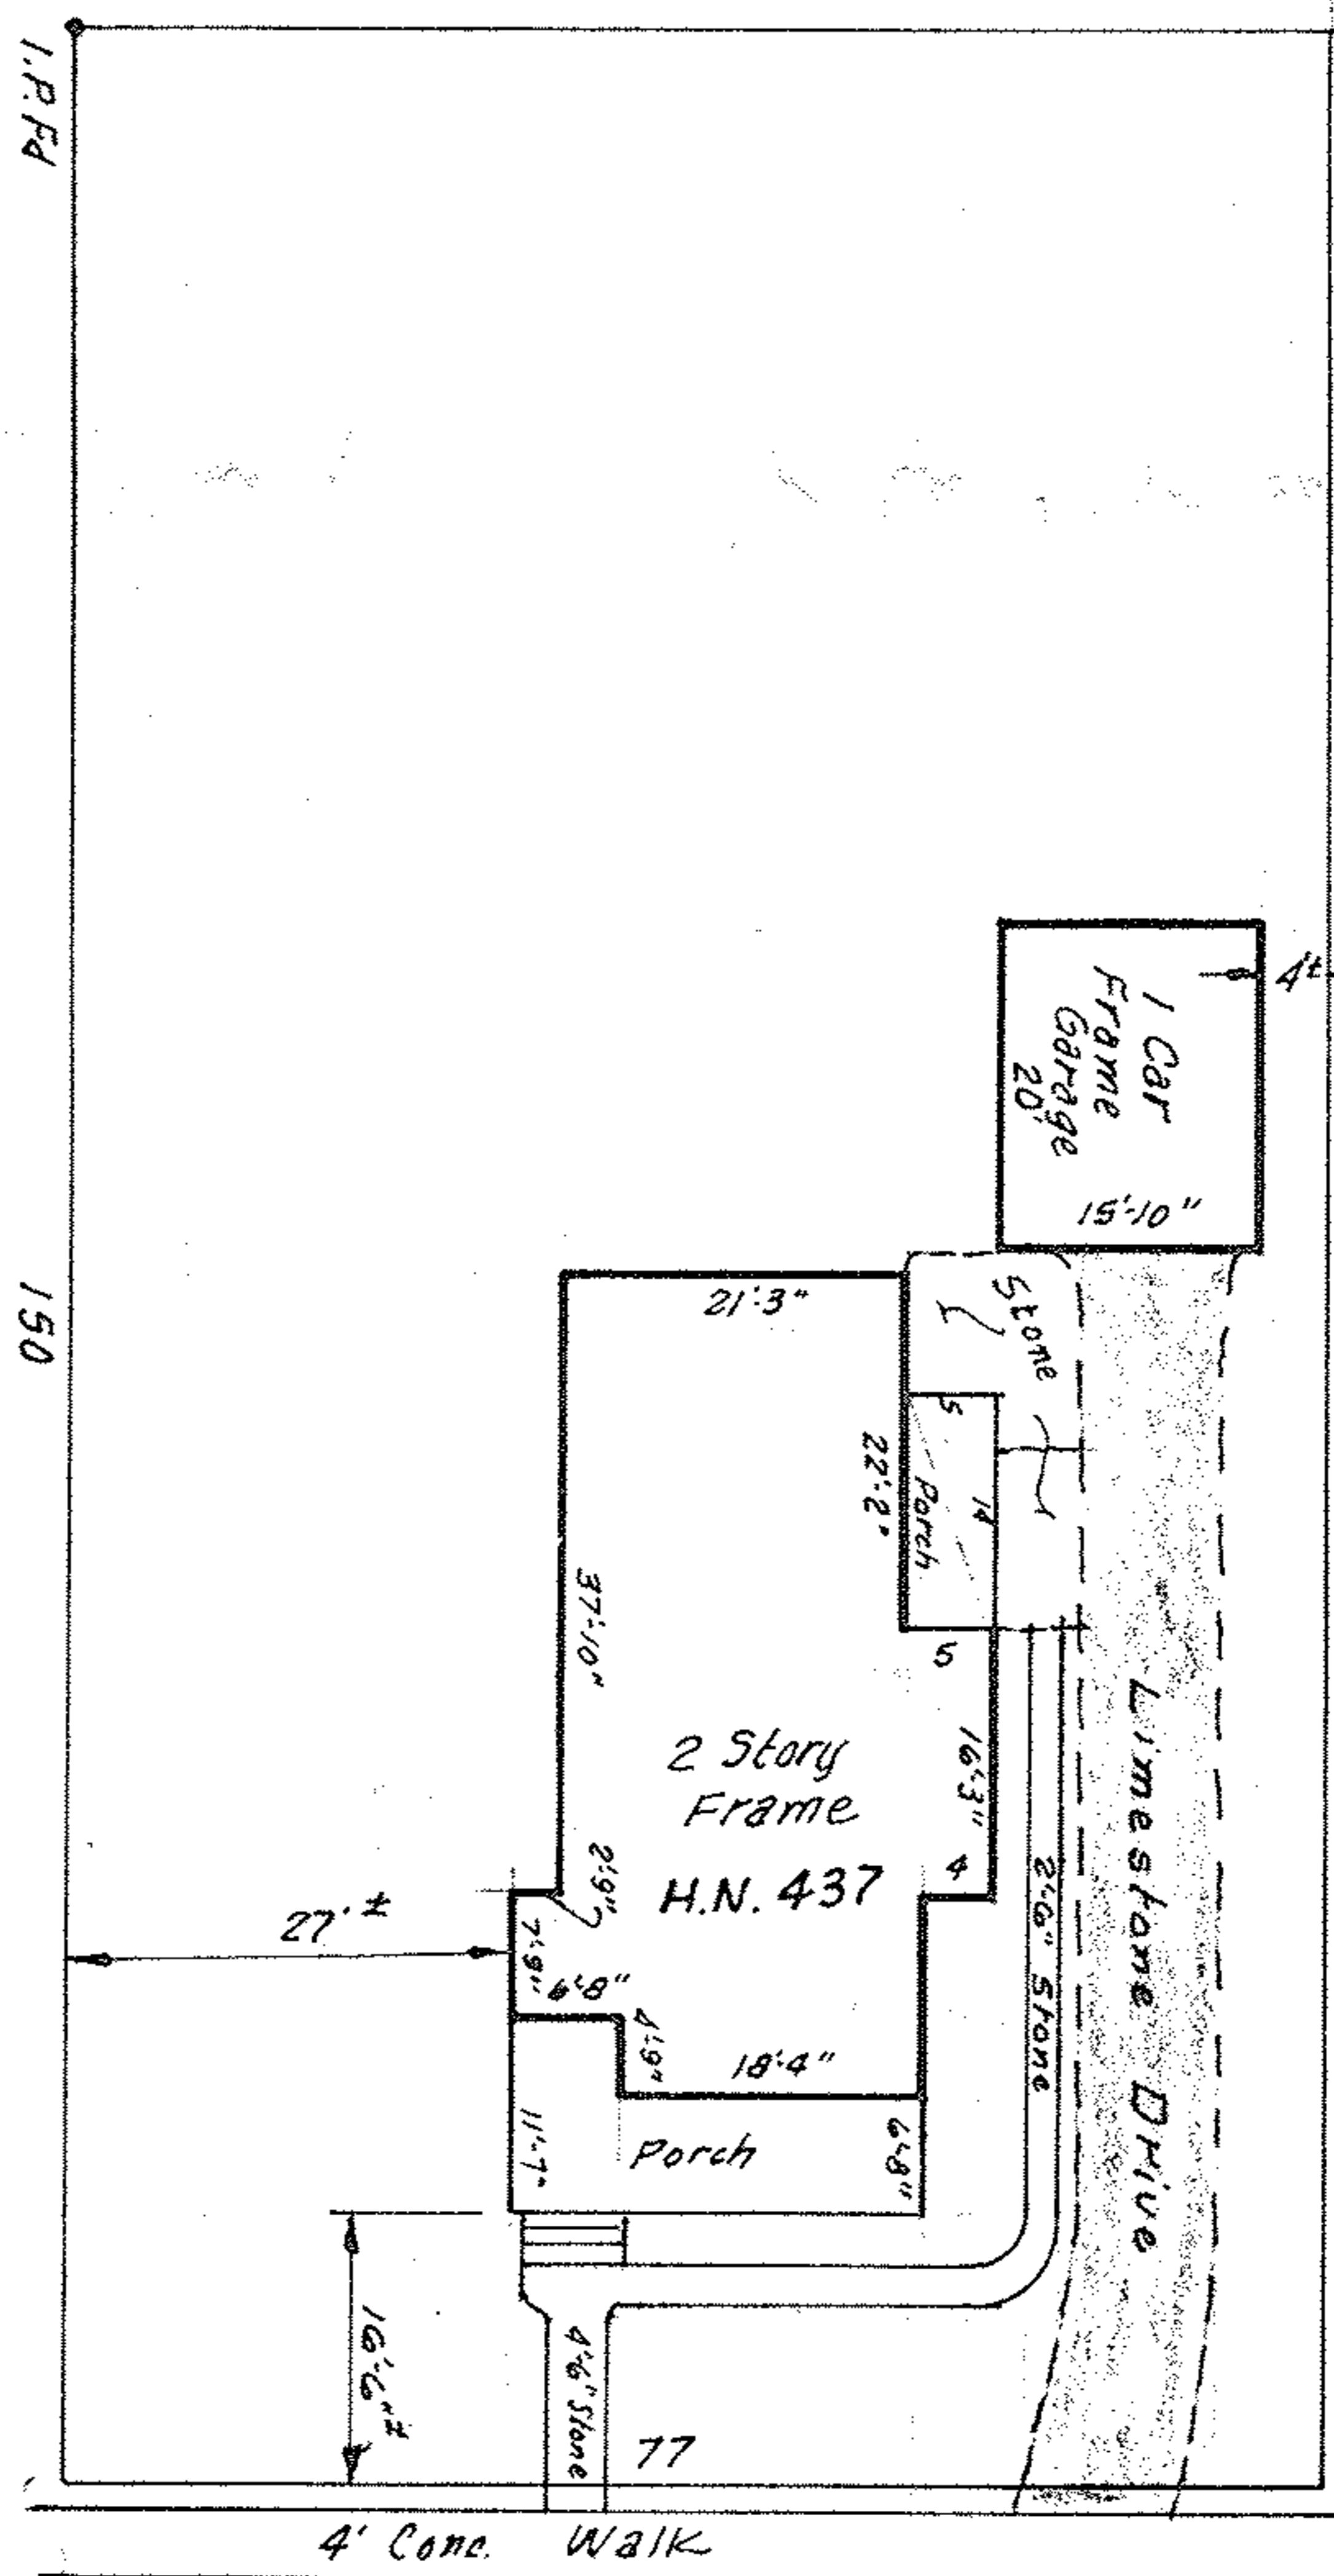

FRANKLIN ST. 50'
E (orig SCHOOL ST.)

SUBLT #201 OF JOSIAH HARRIS HEIRS
ADDITION - PLAT VOL. 2, PG. 3 - PART OF
ORIG. AMHERST TWP. LOT 24 -
NOW IN CITY OF AMHERST, OHIO

MCLINCHY & ASSOCIATES
APRIL 14, 1976
#76058

LT #EL43, 736