

05-00-037-A

05-00-037-113-035


Survey and Map by A. F. Koepf Reg. Surveyor

034  
036

Map of Part of Lot 299 as found recorded  
in Vol. 2 Page 5 of Lorain Co. Plat  
Set Records  
Scale 1" = 40'

2

Aug. 14, 1964

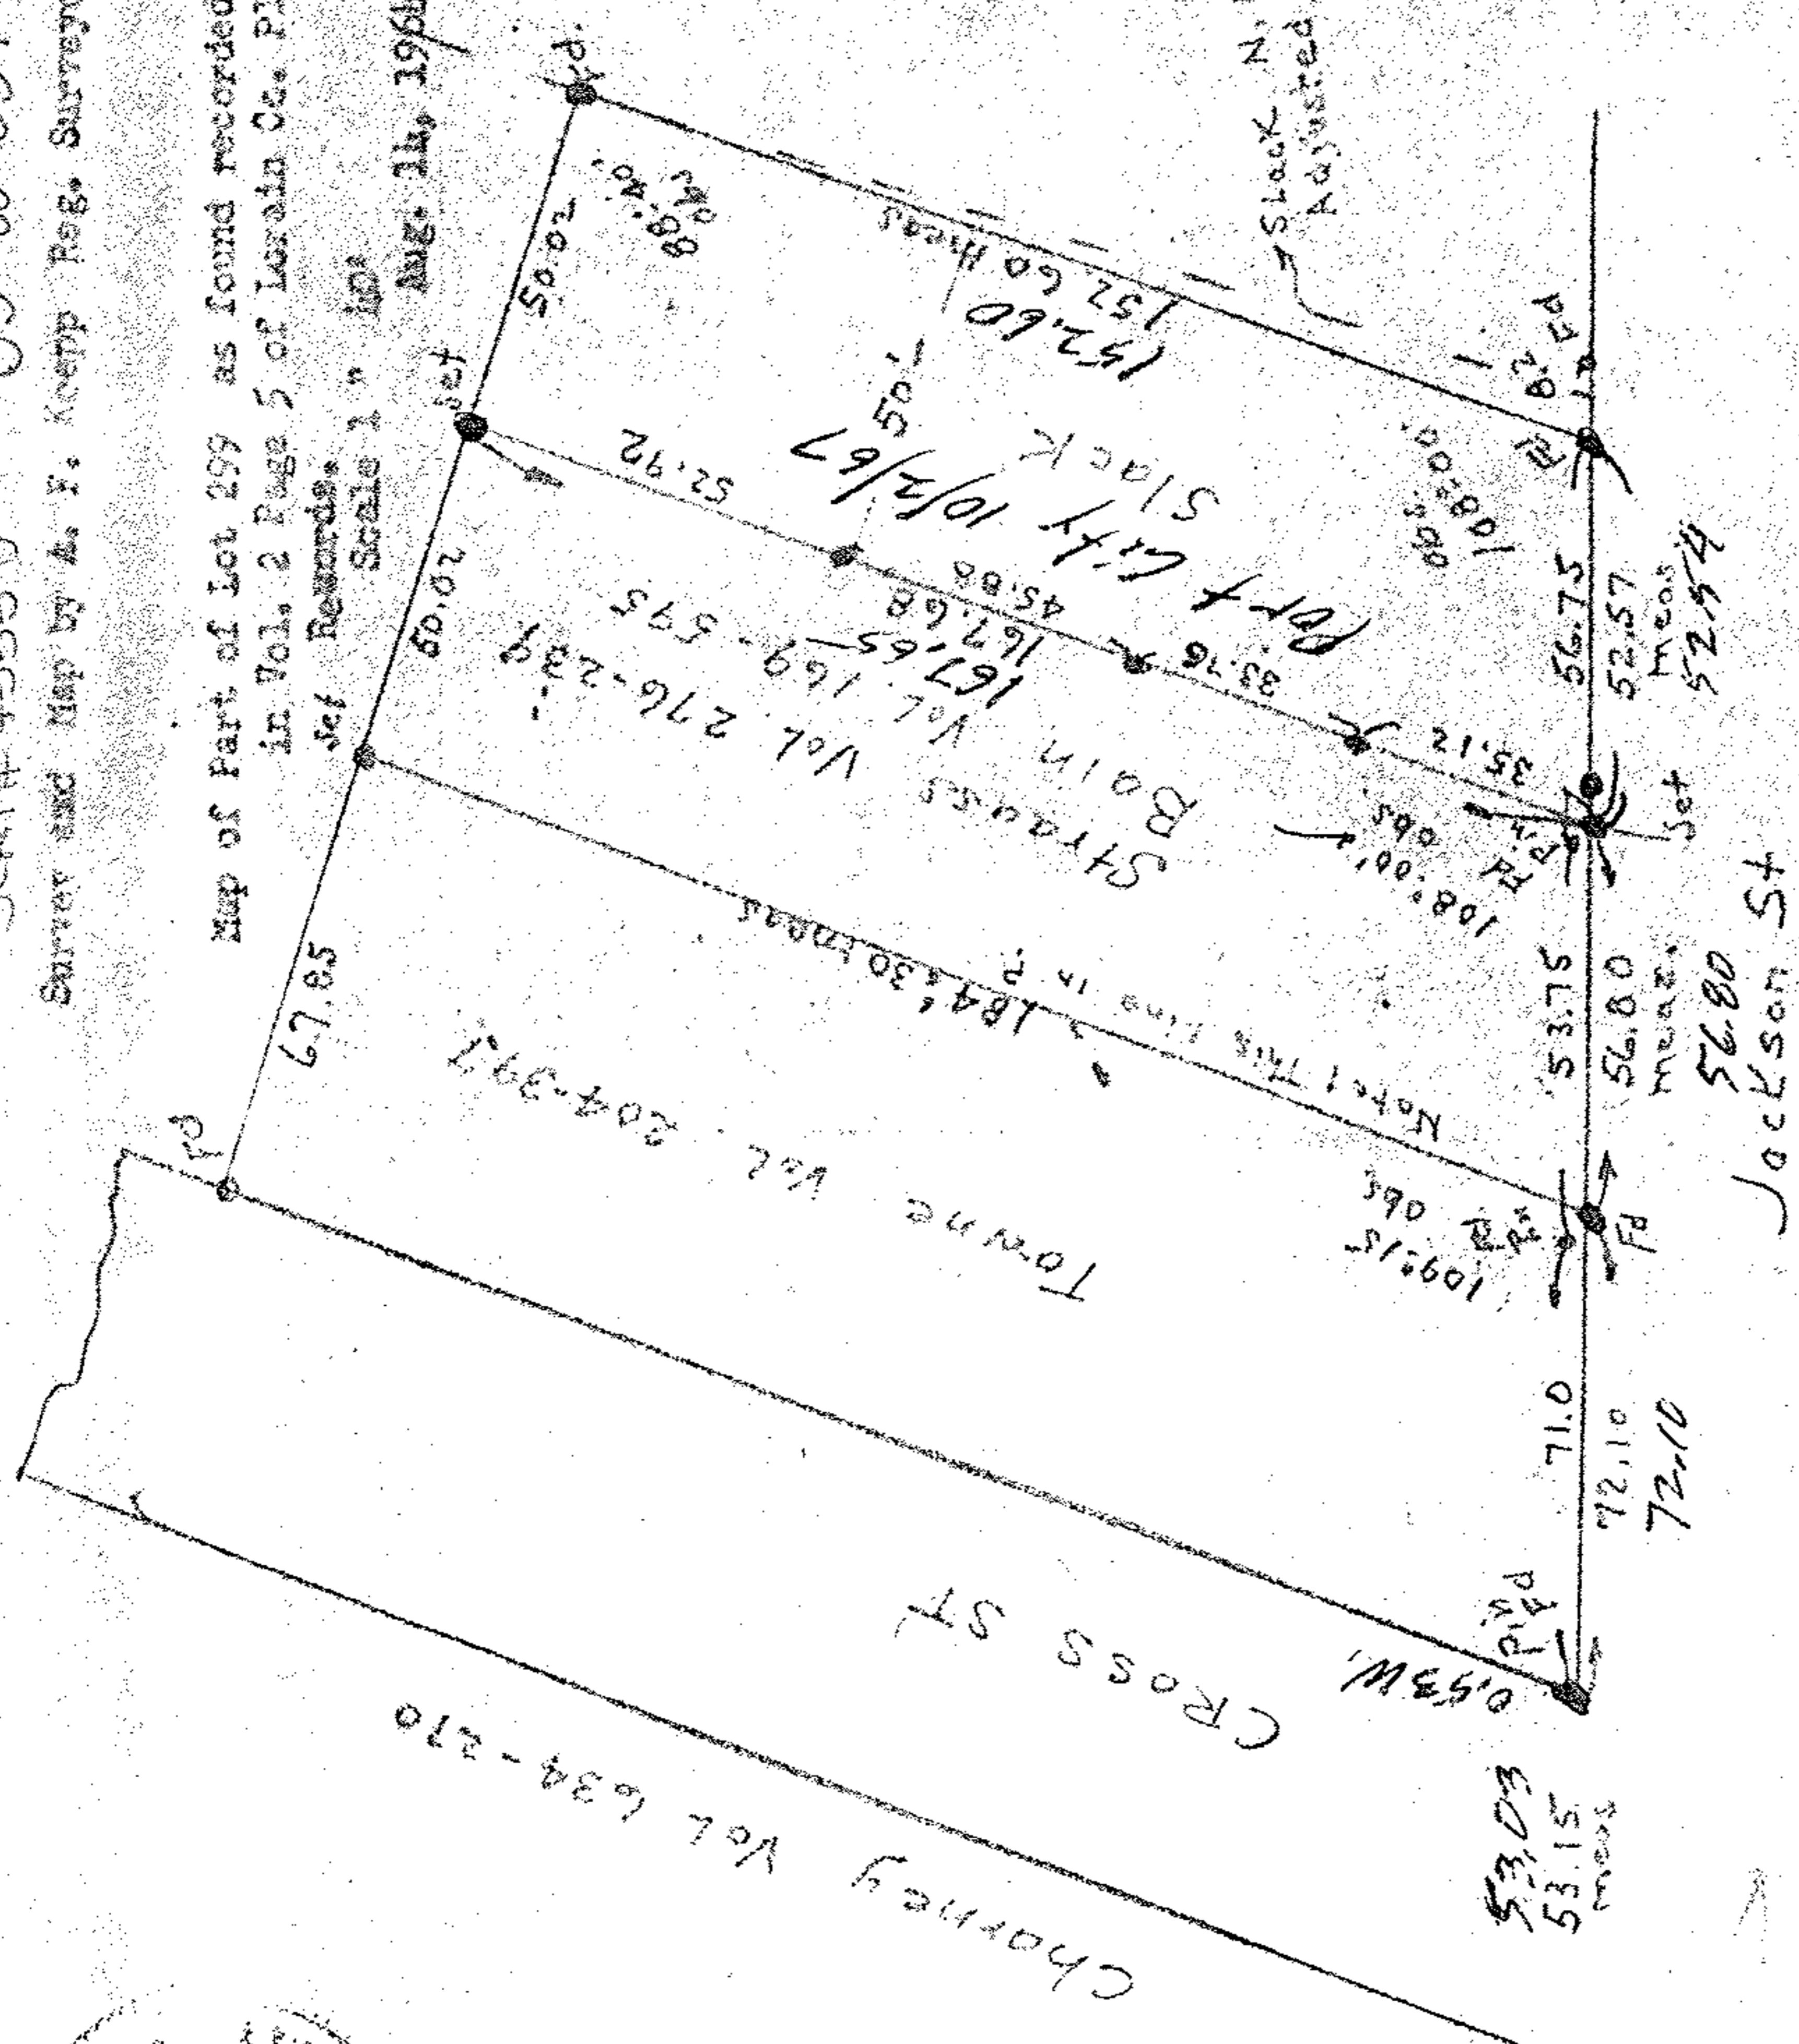

Note: Strauss Deed reads 50 feet at right angles to Slack north line

