

D. 5-00-042-104-090 5-00-042-9

SCAN# 46580
Samuel & Thelma



MAP OF PART OF ORIG. LOT NO. 42
AMHERST TOWNSHIP

LORAIN COUNTY OHIO

SCALE: 1" = 30' JAN. 7-1966 9:30 A.M.

Gary E. Penfound REG. SURVEYORS
for C. E. Penfound

GL-1416 Peter & Alexandara
M. Rogers

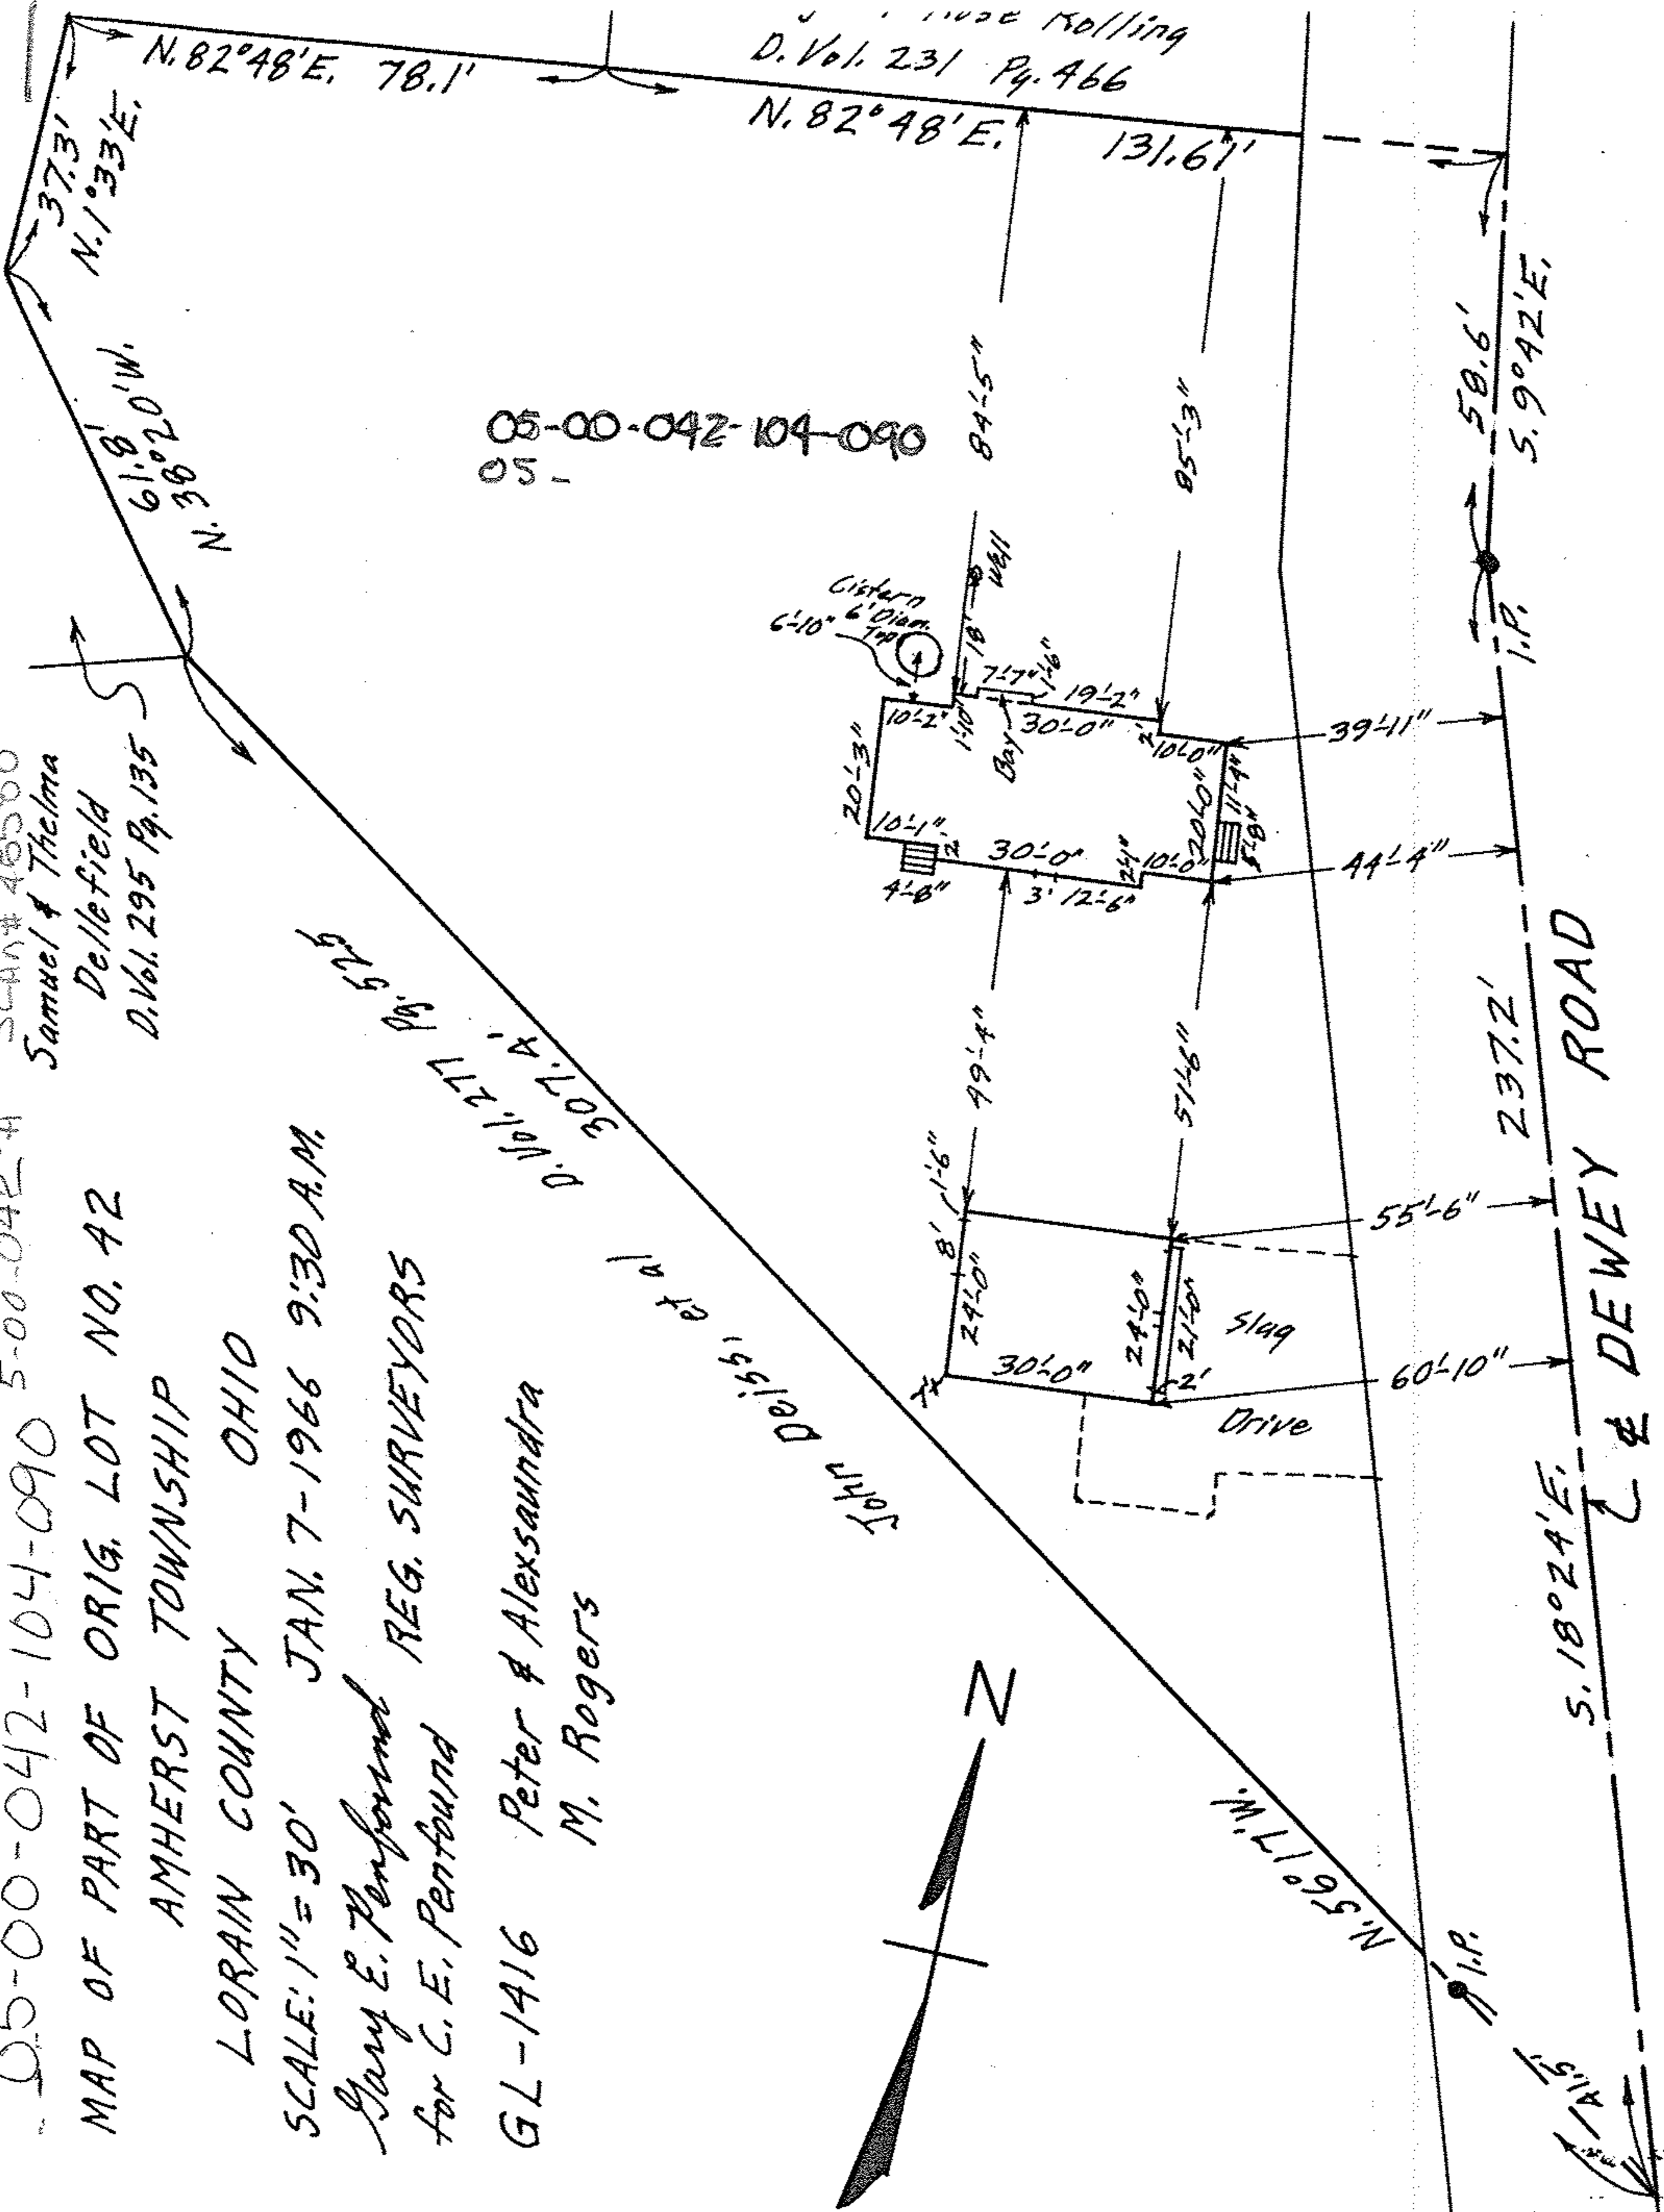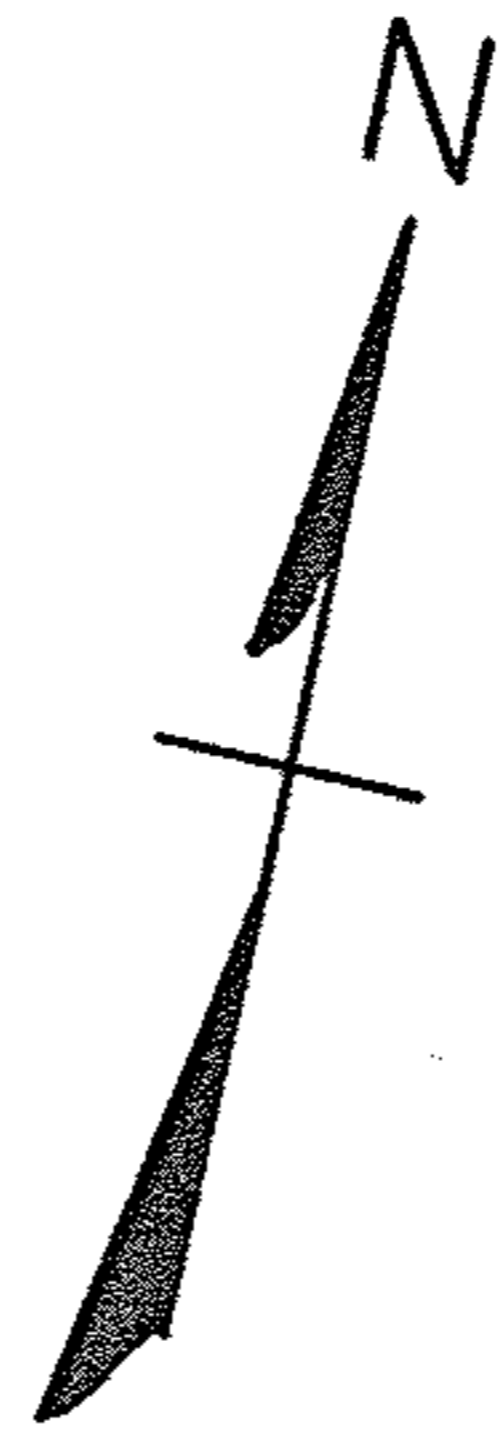

05-00-042-104-090
05

include Rolling
D. Vol. 231 Pg. 466

Dellefield
D. Vol. 295 Pg. 135

307.4
D. Vol. 1277 Pg. 526

141.5