
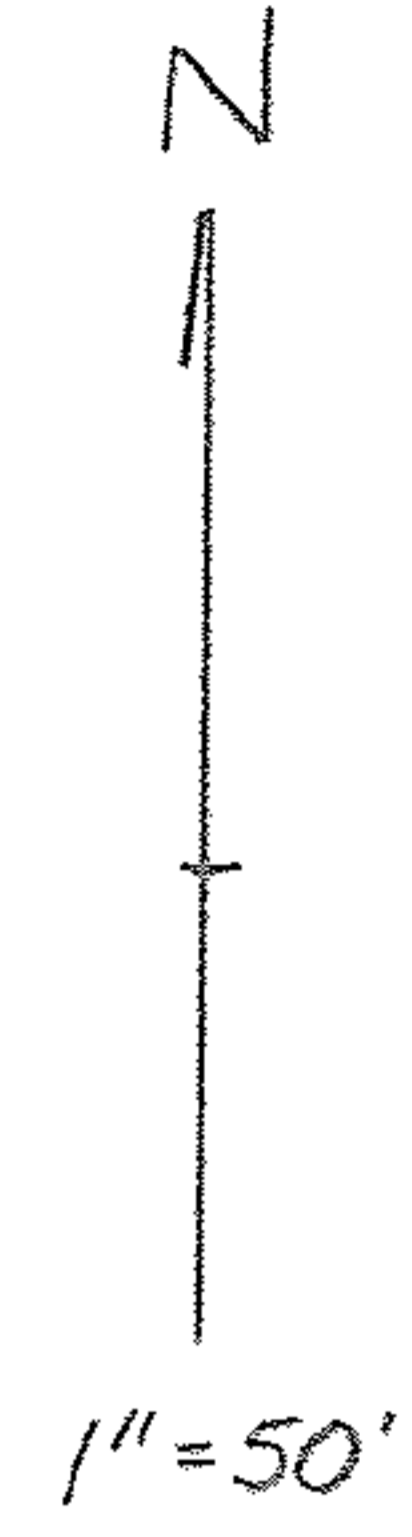


05-00-45-000-024  
 05-00-045-A  
 SCAN # 45584

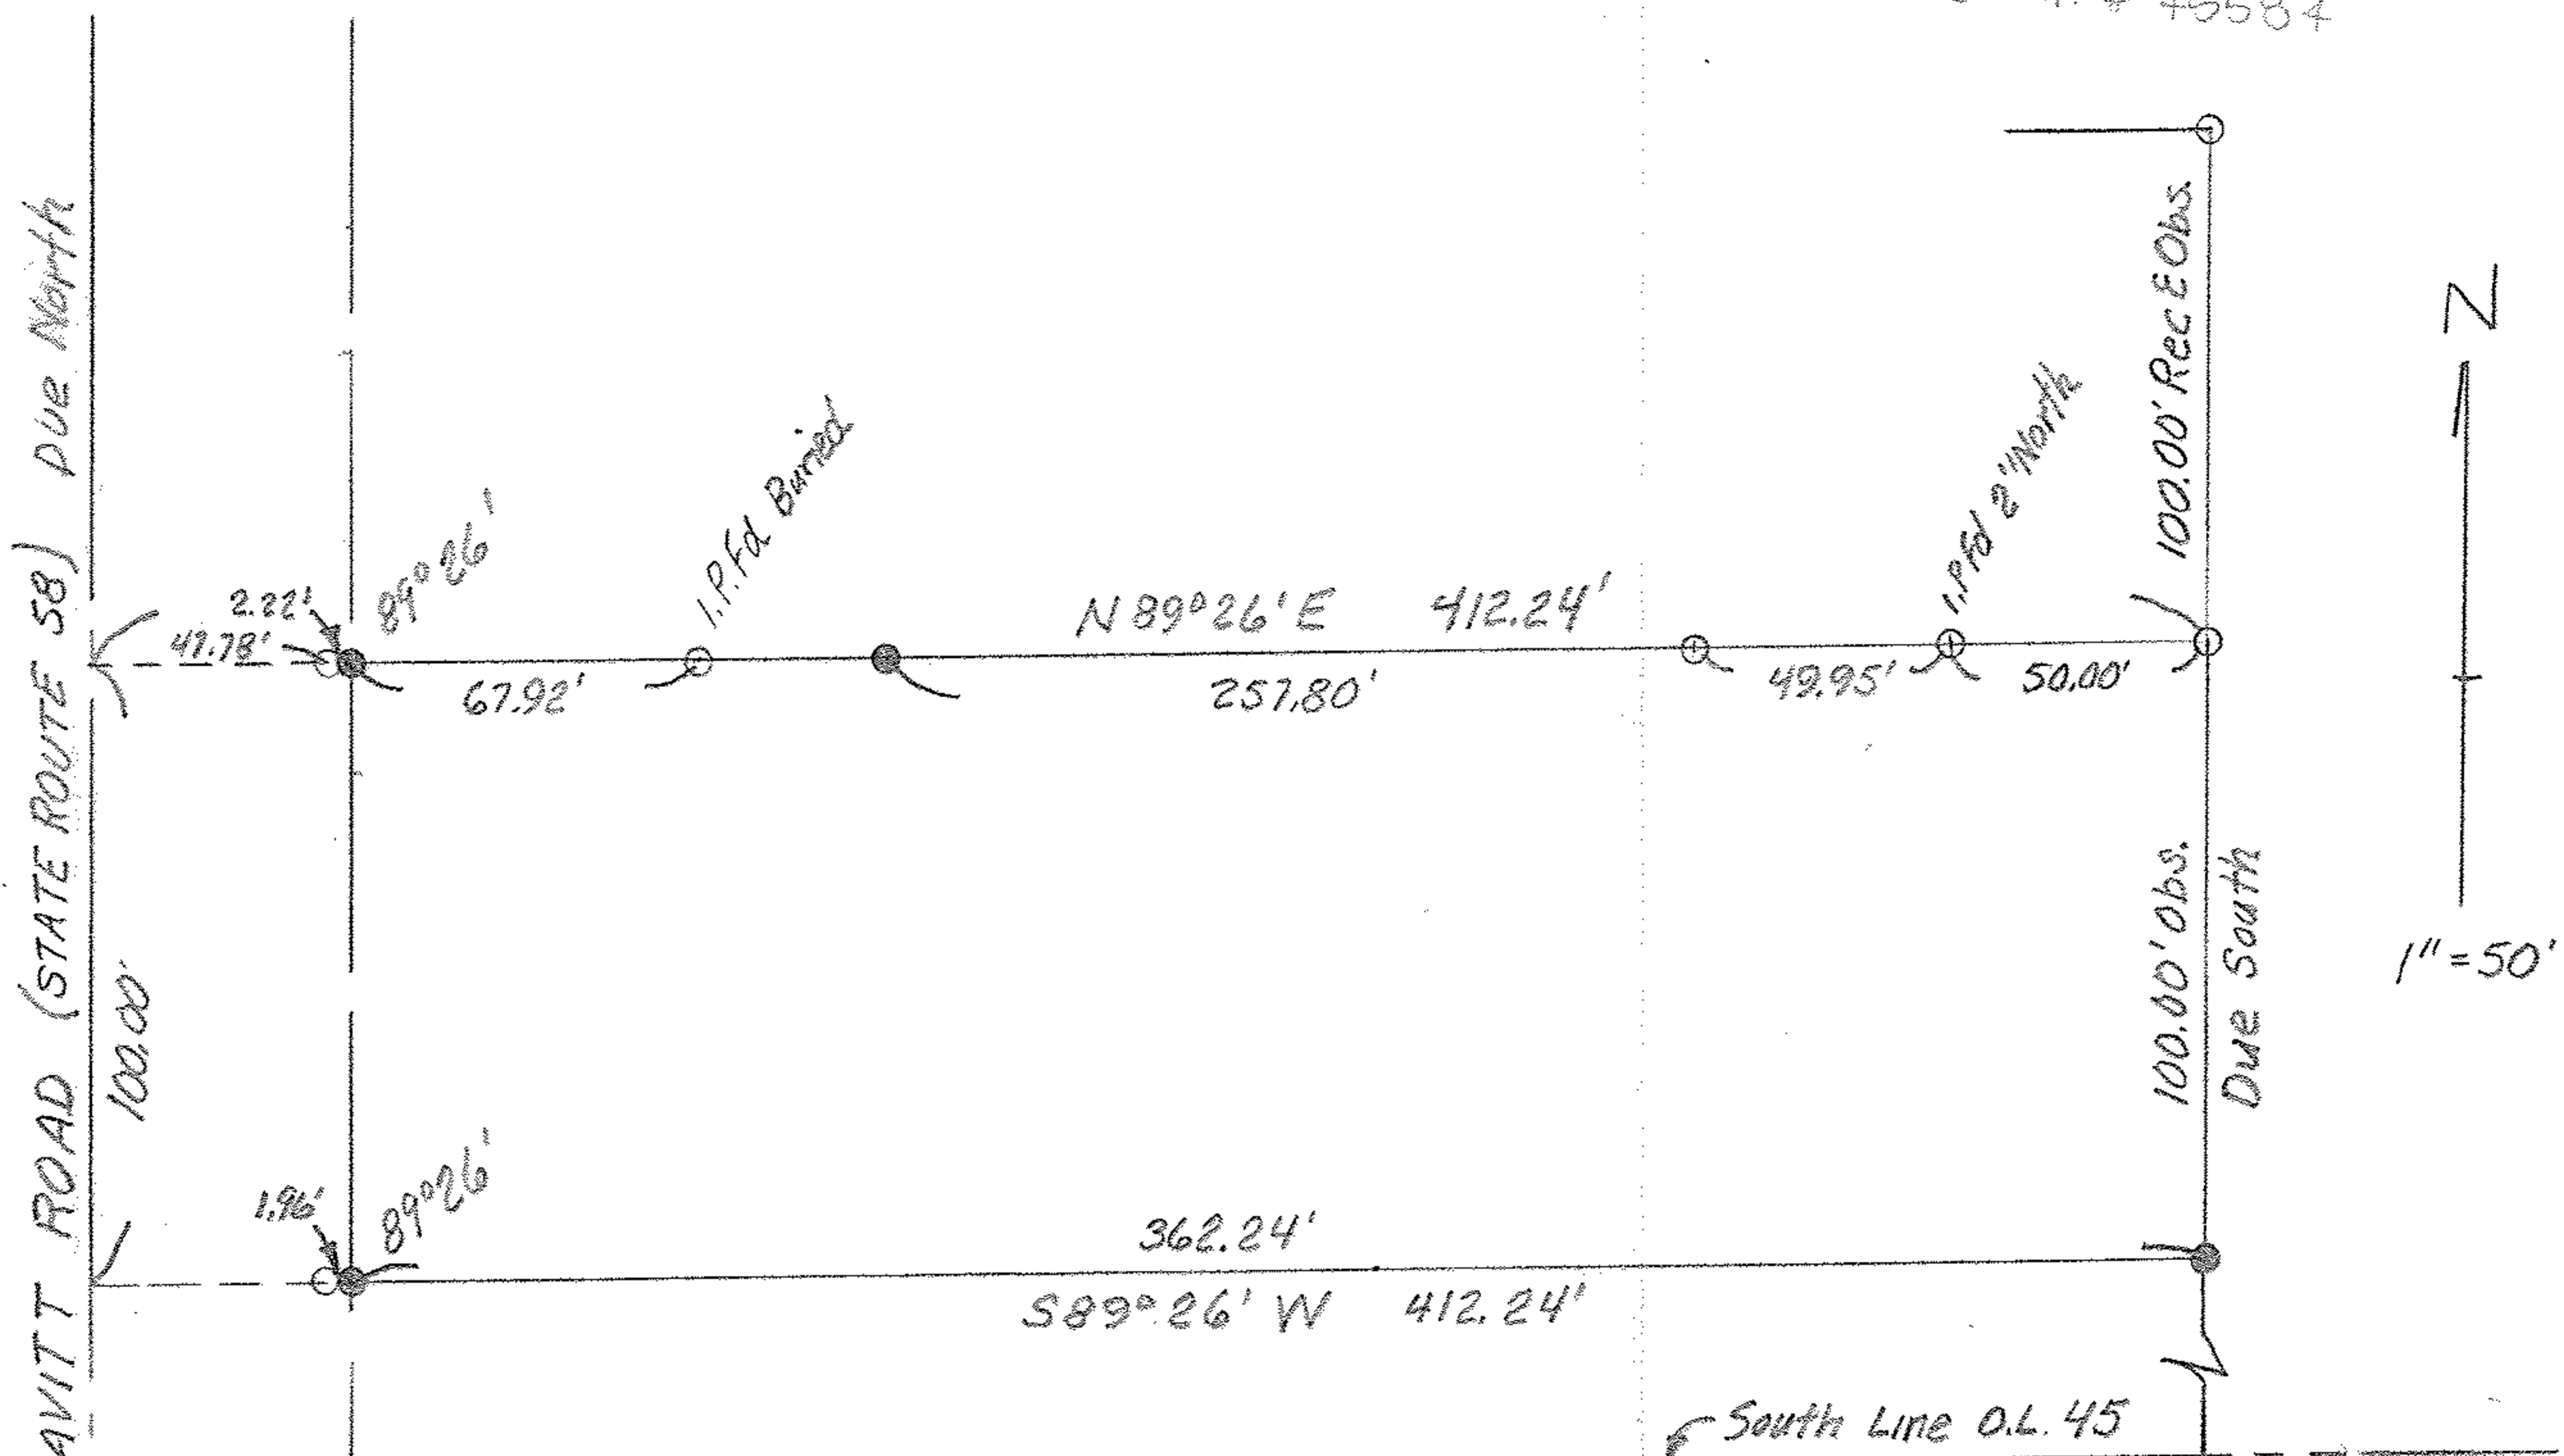

- I. Pipe Found
- I. Pipe Set or Reset

PLAT OF SURVEY FOR  
 MARY OLAH  
 O.L. 45 AMHERST TWP.  
 LORAIN COUNTY, OHIO

McGLINCHY & ASSOCIATES  
 AMHERST, OHIO SEPT. 1989  
 Job No. 898782