


DETAIL SHEET OF PART OF ORIGINAL LOT NO. 52  
AMHERST TWP. - LORAIN COUNTY - OHIO  
DETAIL SCALE: 1"=30' JULY 11-1970 4:15 P.M.

NOTE: There are no encroachments on this property.  
Gary E. Payfound REG. SURVEYOR NO. 4957

CITY TITLE Co. Order No. E-1181  
Jones to Gas

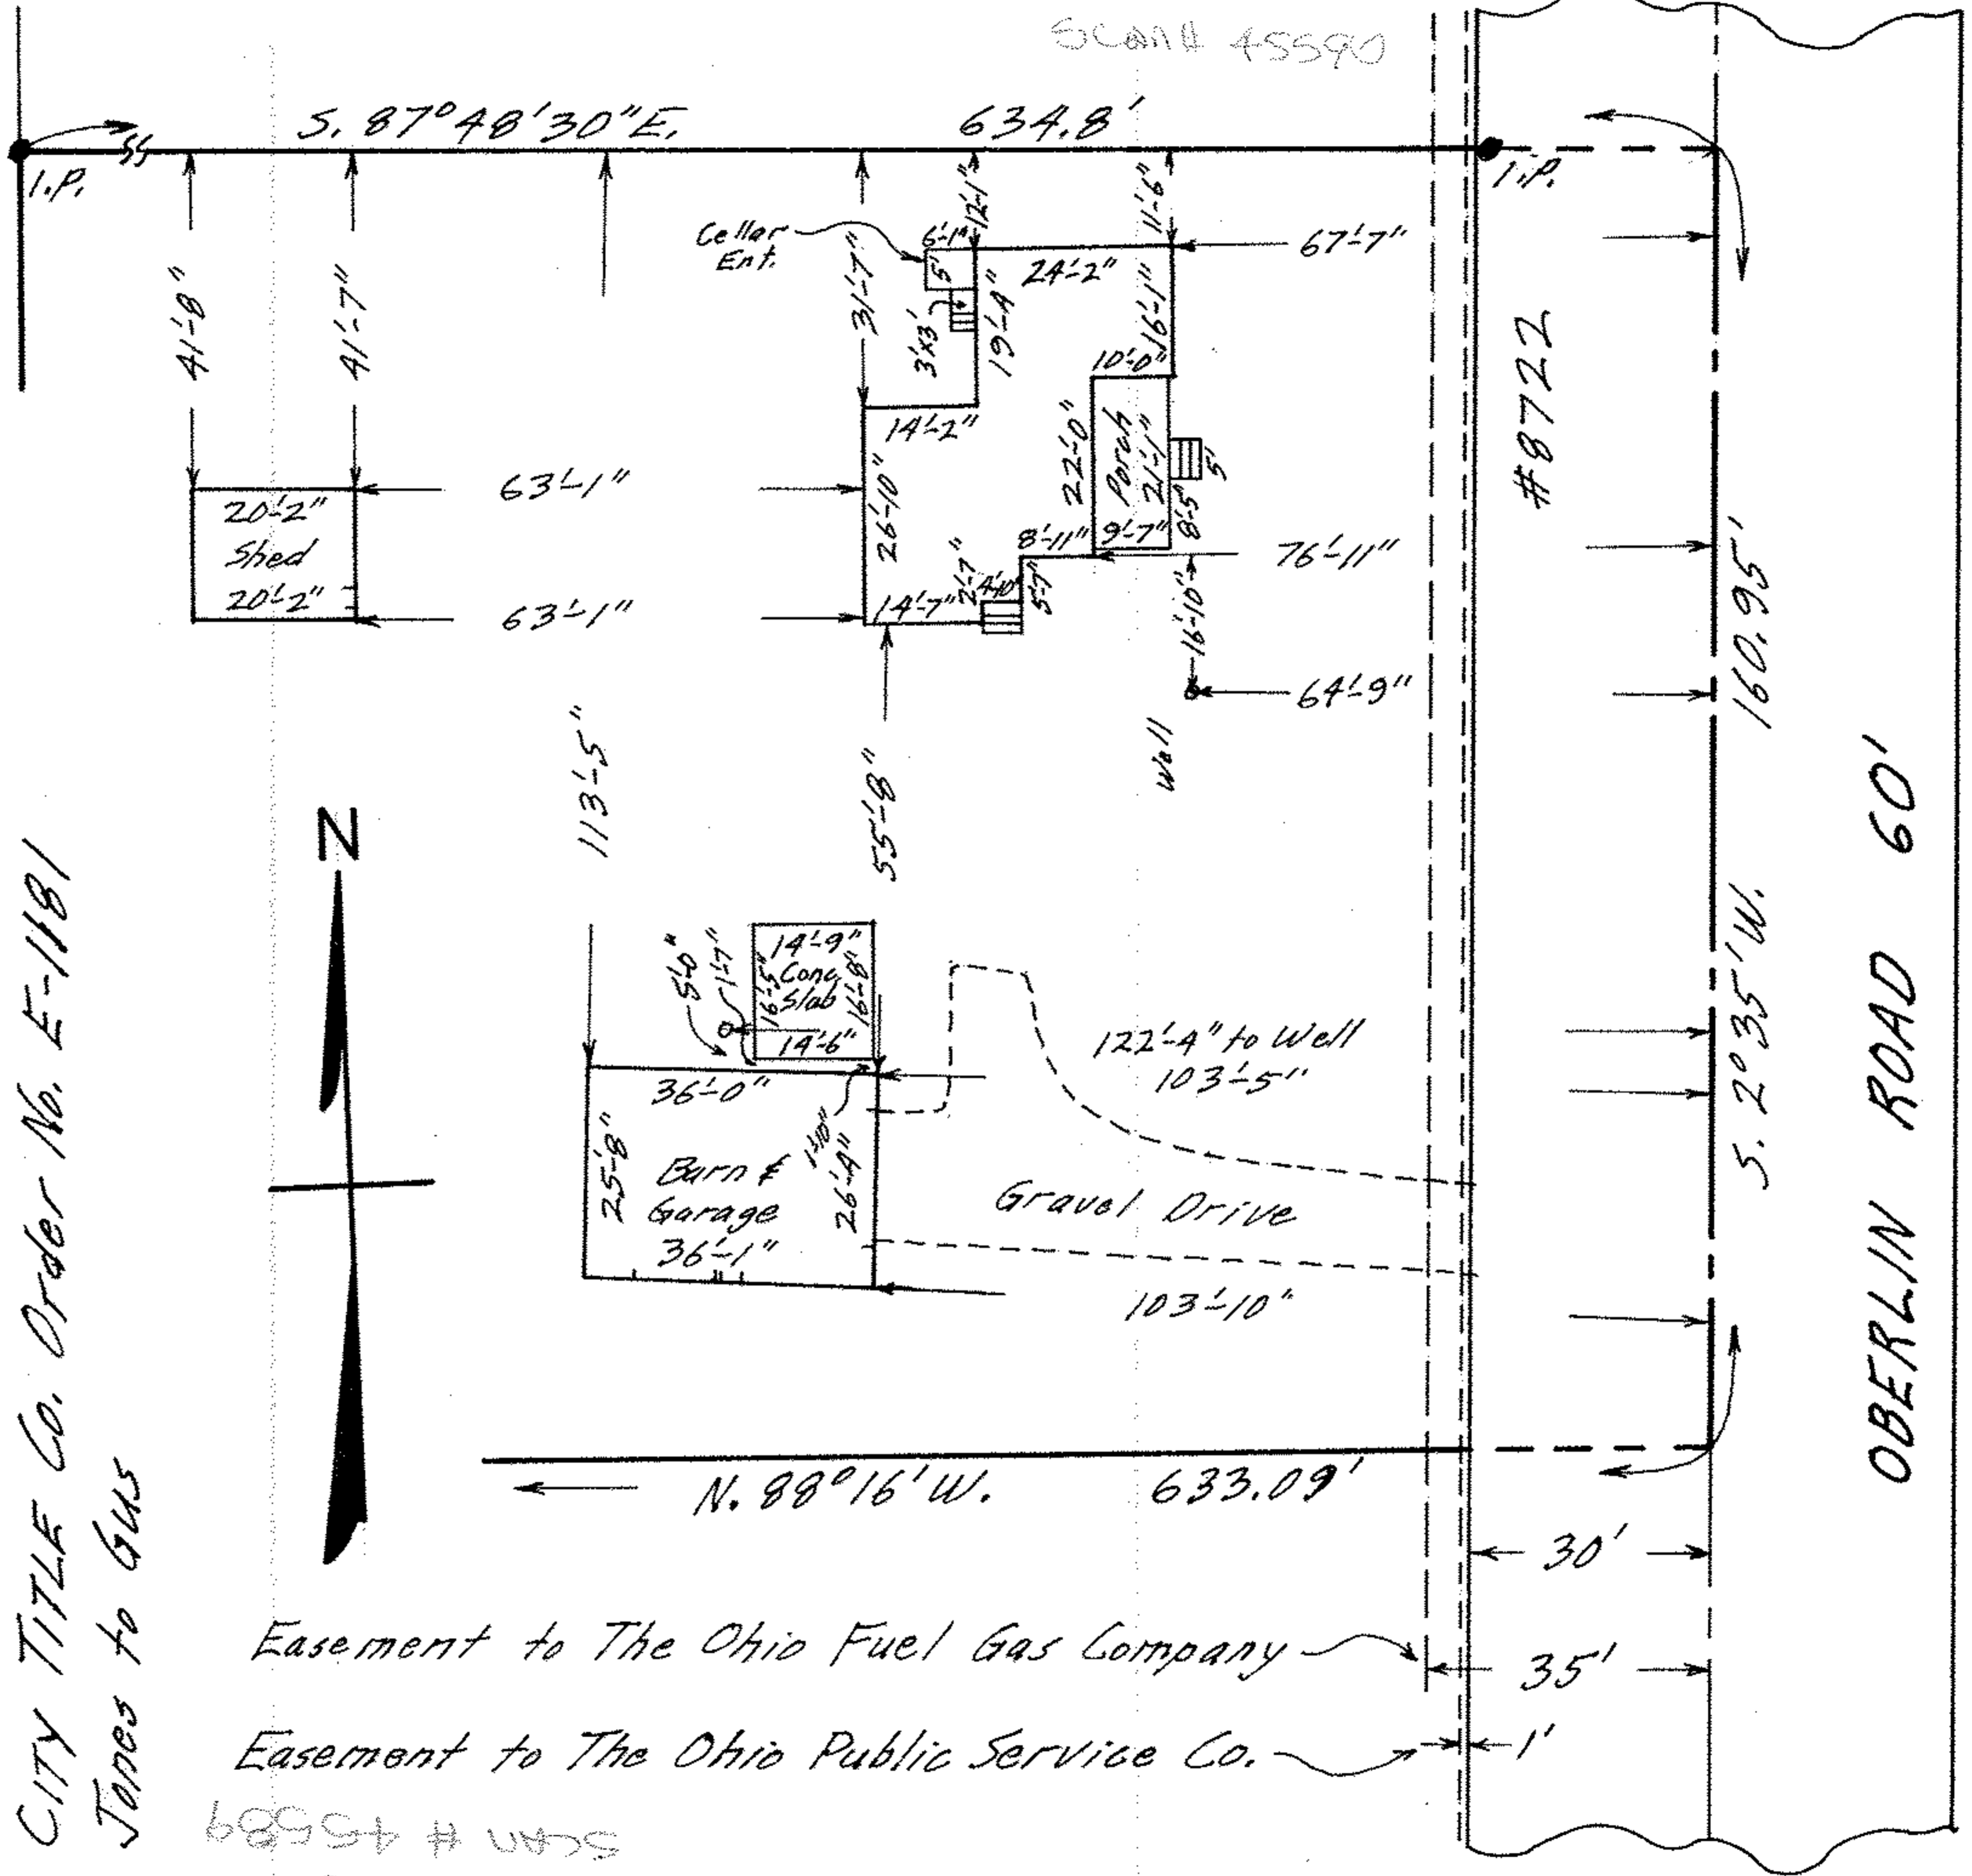

Easement to The Ohio Fuel Gas Company  
Easement to The Ohio Public Service Co.