


08-14-002-000-006
 08-14-003-000-002
 8-B SCAN # 45600

Carlson Surveys

Job: 801-10
 February 2010

08-14-003-000-005
 Edward & Sara B. Schlechter
 V. 1354 P. 317
 2.07 ac.

08-14-003-000-006
 Edward W. & Sara B. Schlechter
 O.R. 1049 P. 273
 42.32 ac.

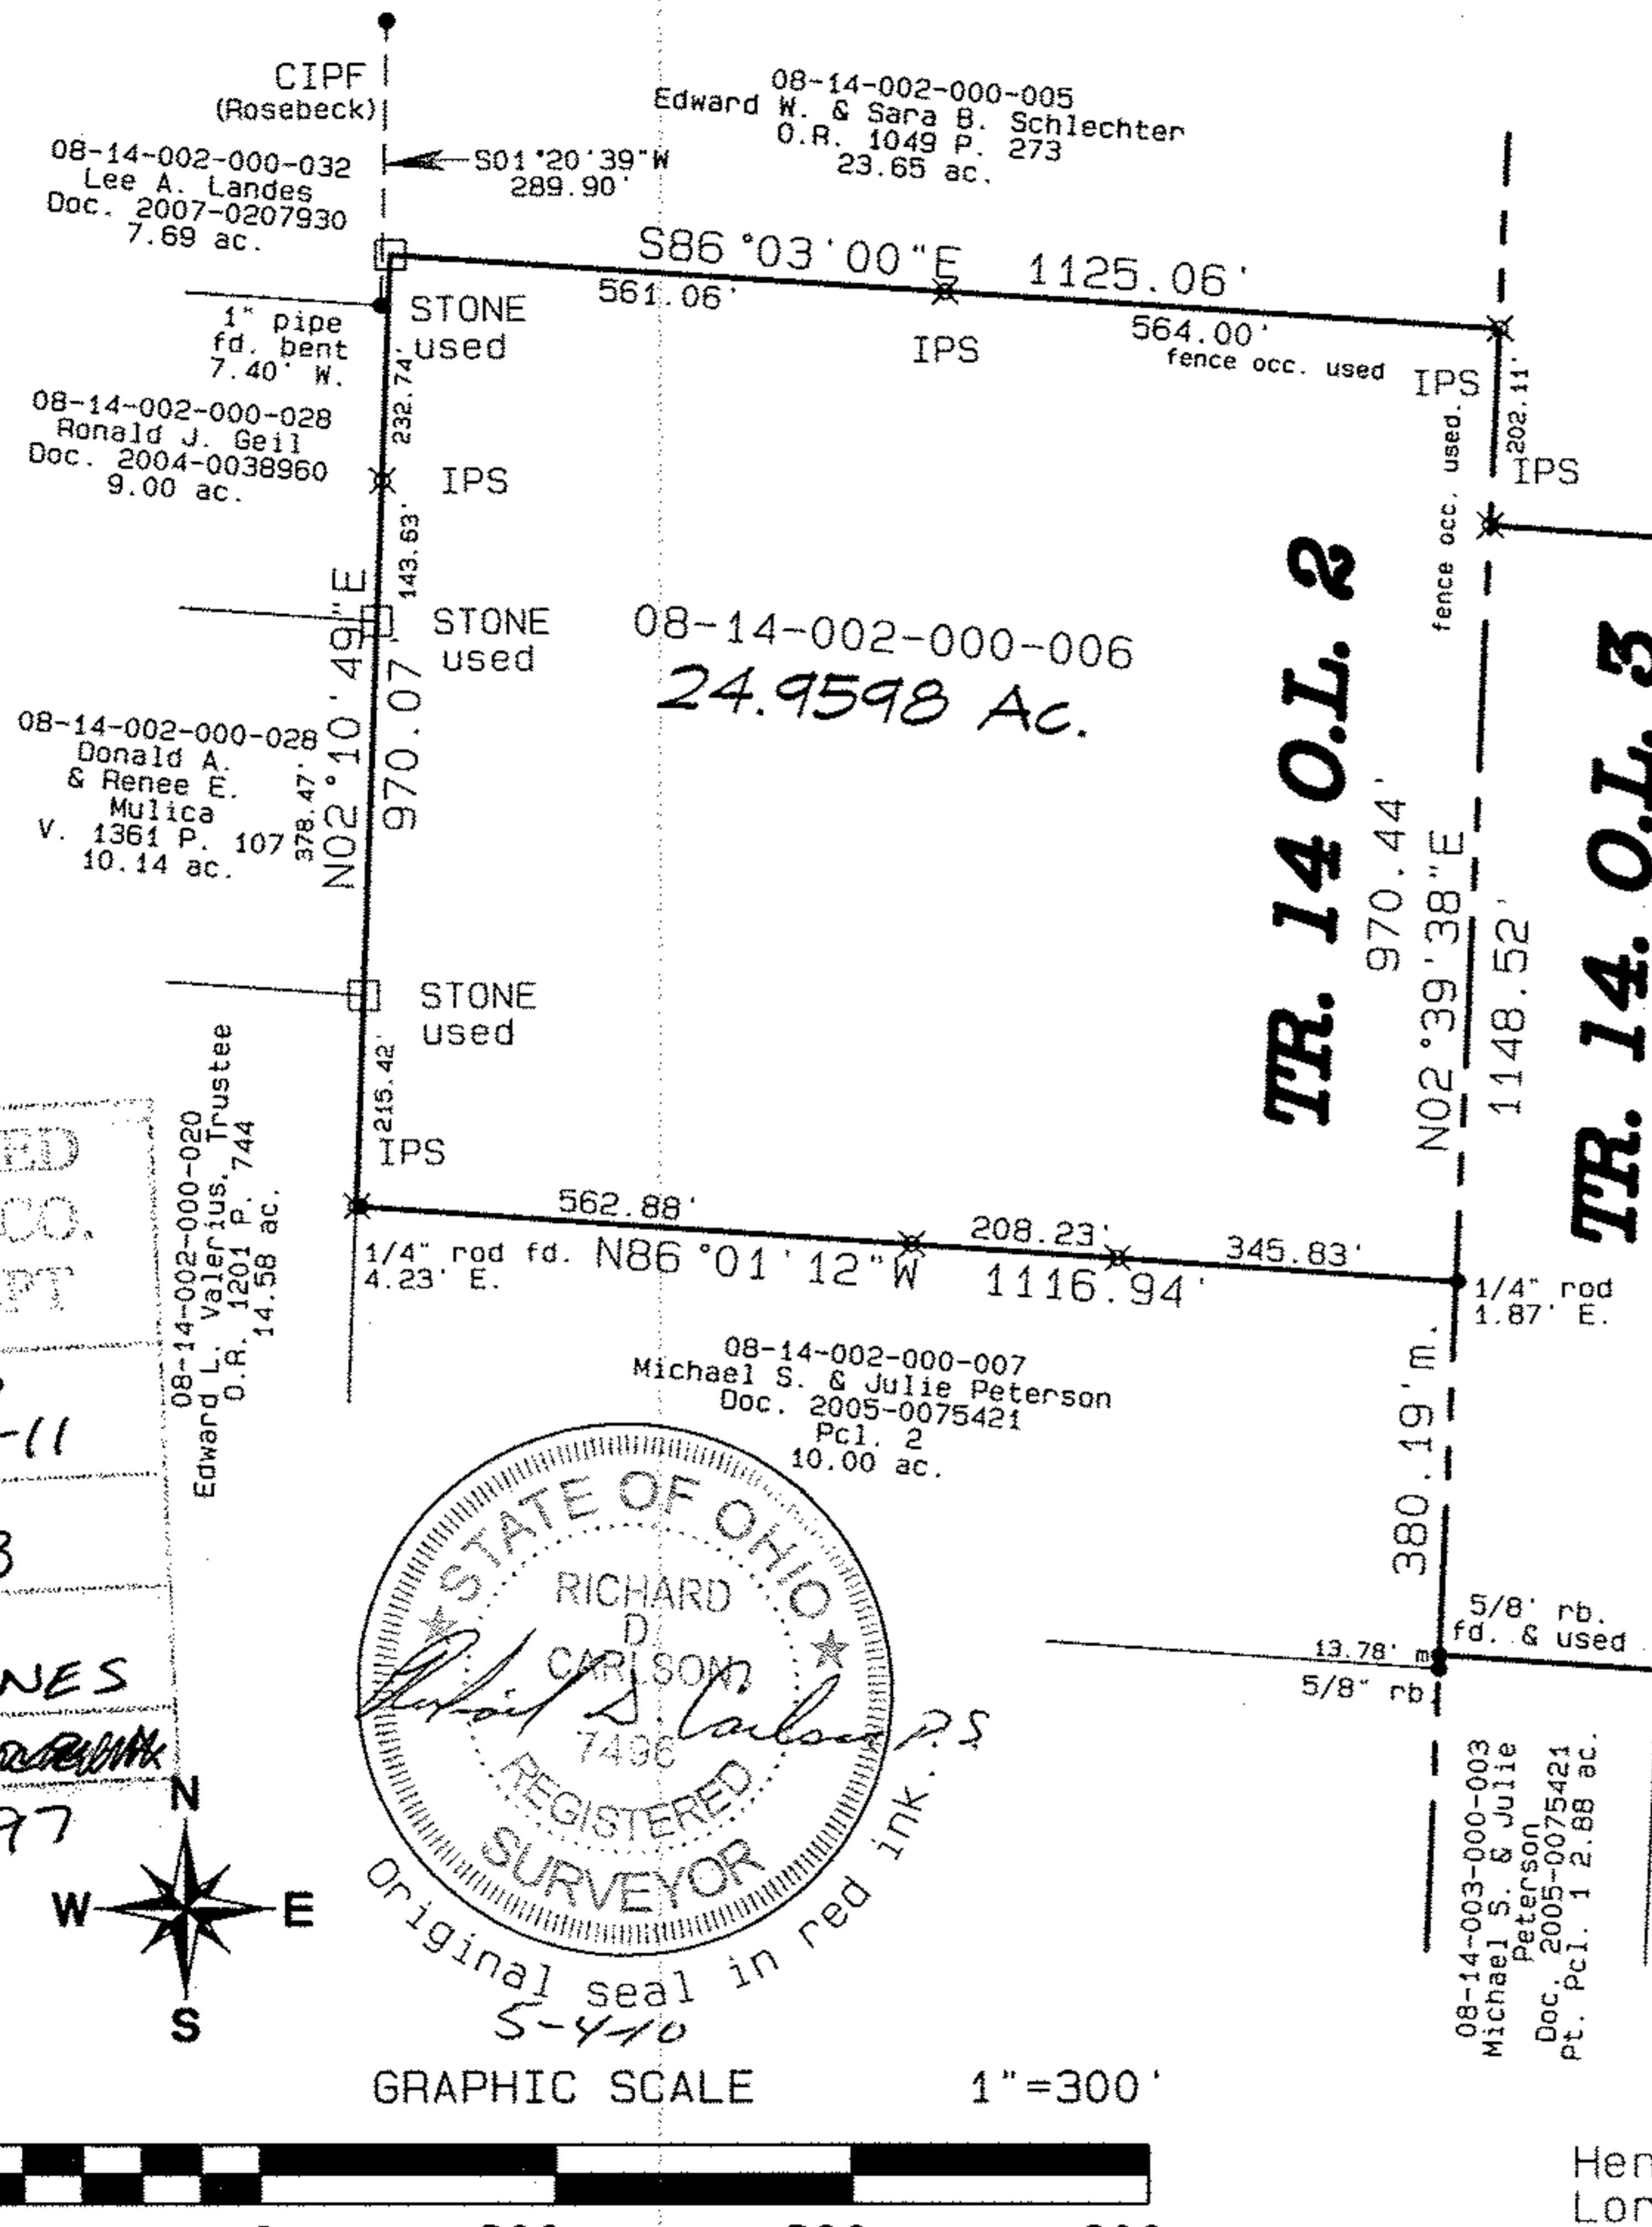


TR. 14 O.L. 2

TR. 14. O.L. 3


Barnd Rd. 60'

Garfield Rd.

APPROVED
 LORAIN CO.
 MAP DEPT
 DATE 2-10-11
 PAGE 8-B
 BY R. MAINES
 #11-02897

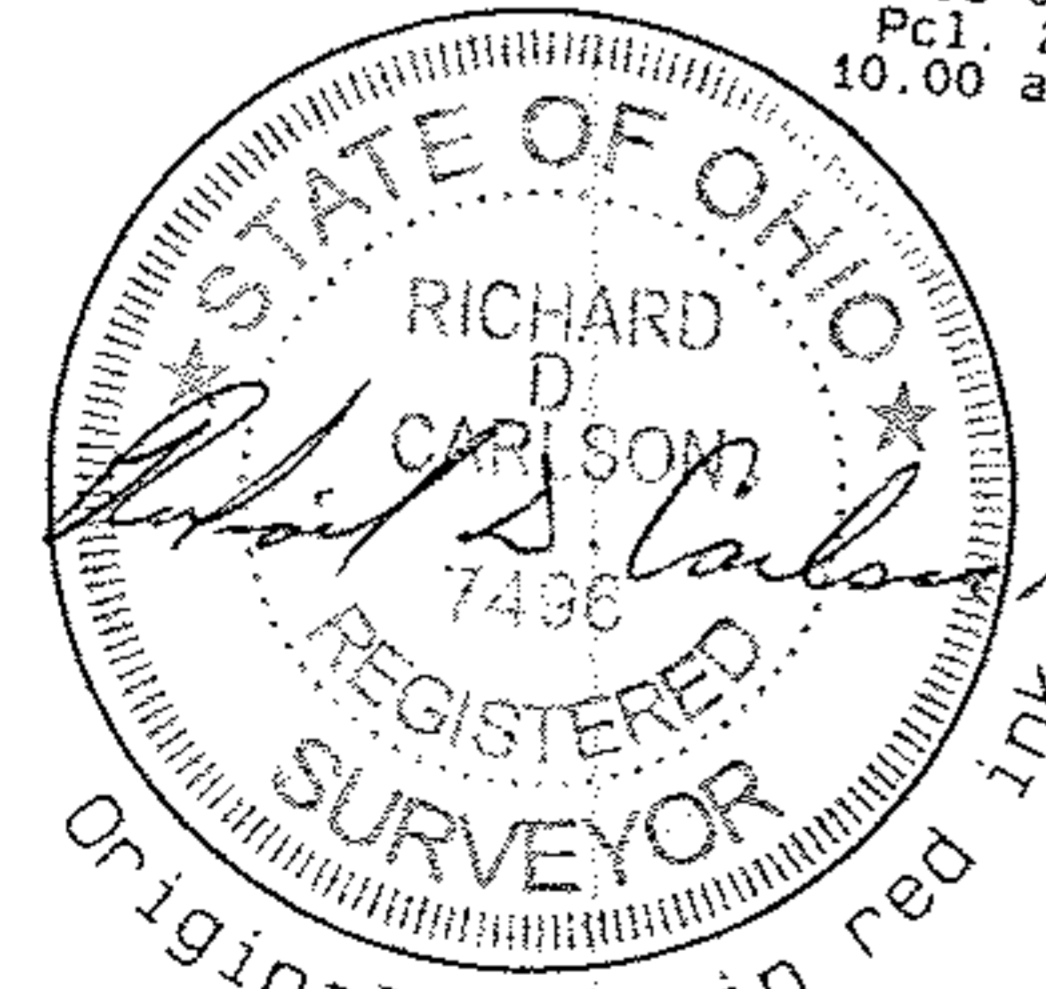

GRAPHIC SCALE 1"=300'

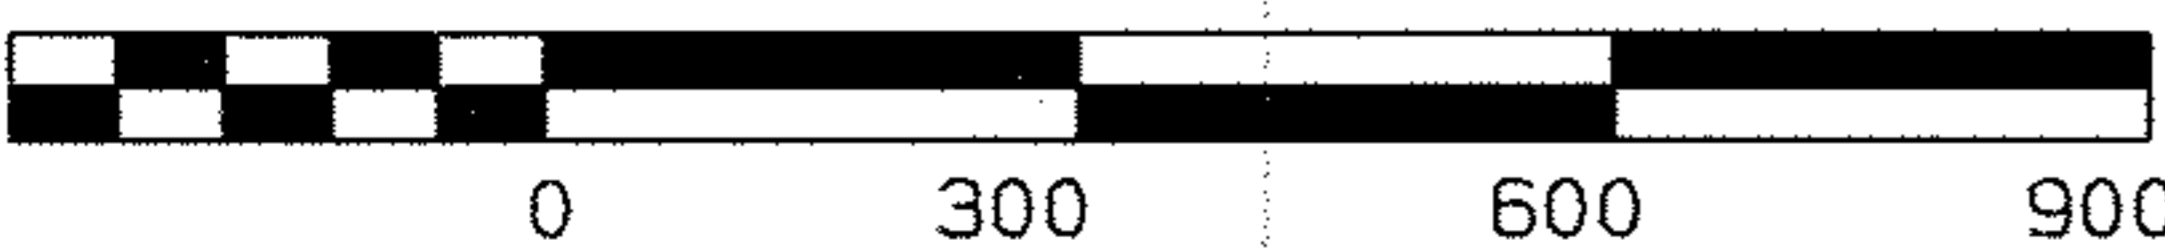

Plat of Survey
Elisabeth Meyer

Henrietta Twp. Tr. 14 O.L. 2 & 3
 Lorain Co. Ohio

08-14-002-000-006, 08-14-003-000-002