


08-14-002-000-006
 08-14-003-000-002 8-A
 Scan # 45401

Carlson Surveys

Job: 801-10
 February 2010

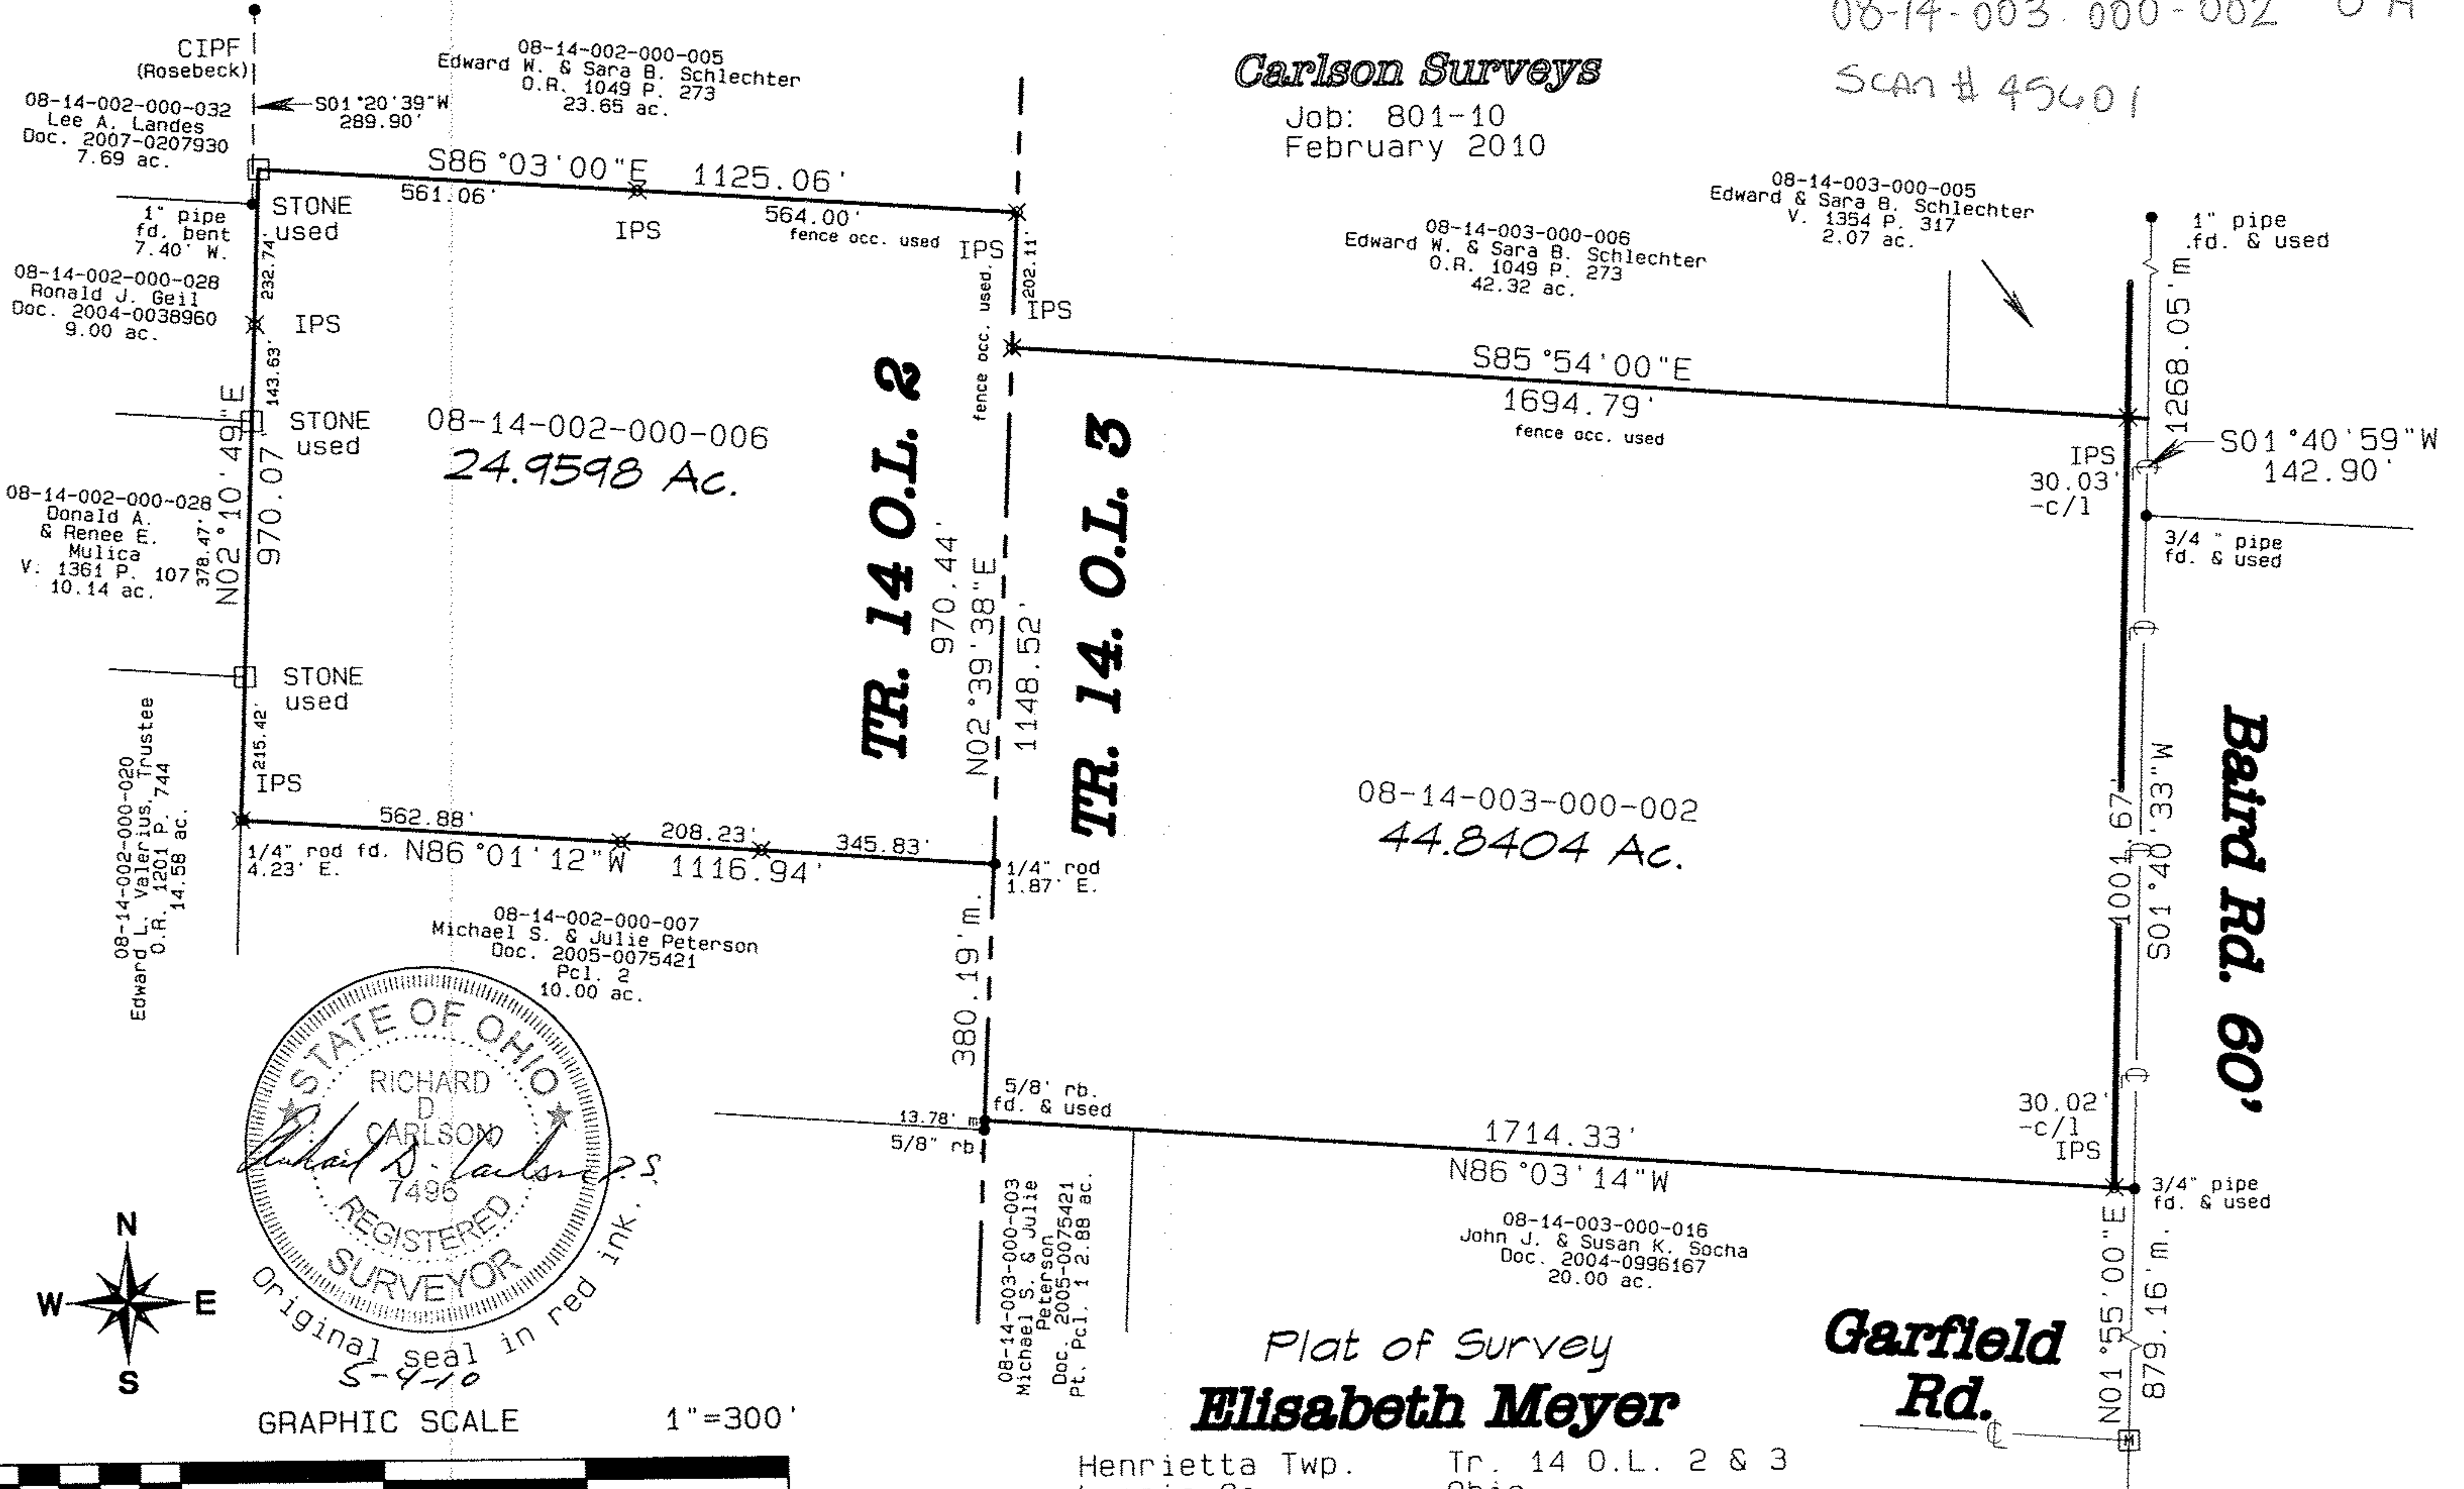

TR. 14 O.L. 2


TR. 14. O.L. 3

Baird Rd. 60'

Garfield Rd.

**Plat of Survey
 Elisabeth Meyer**

Henrietta Twp. Tr. 14 O.L. 2 & 3
 Lorain Co. Ohio

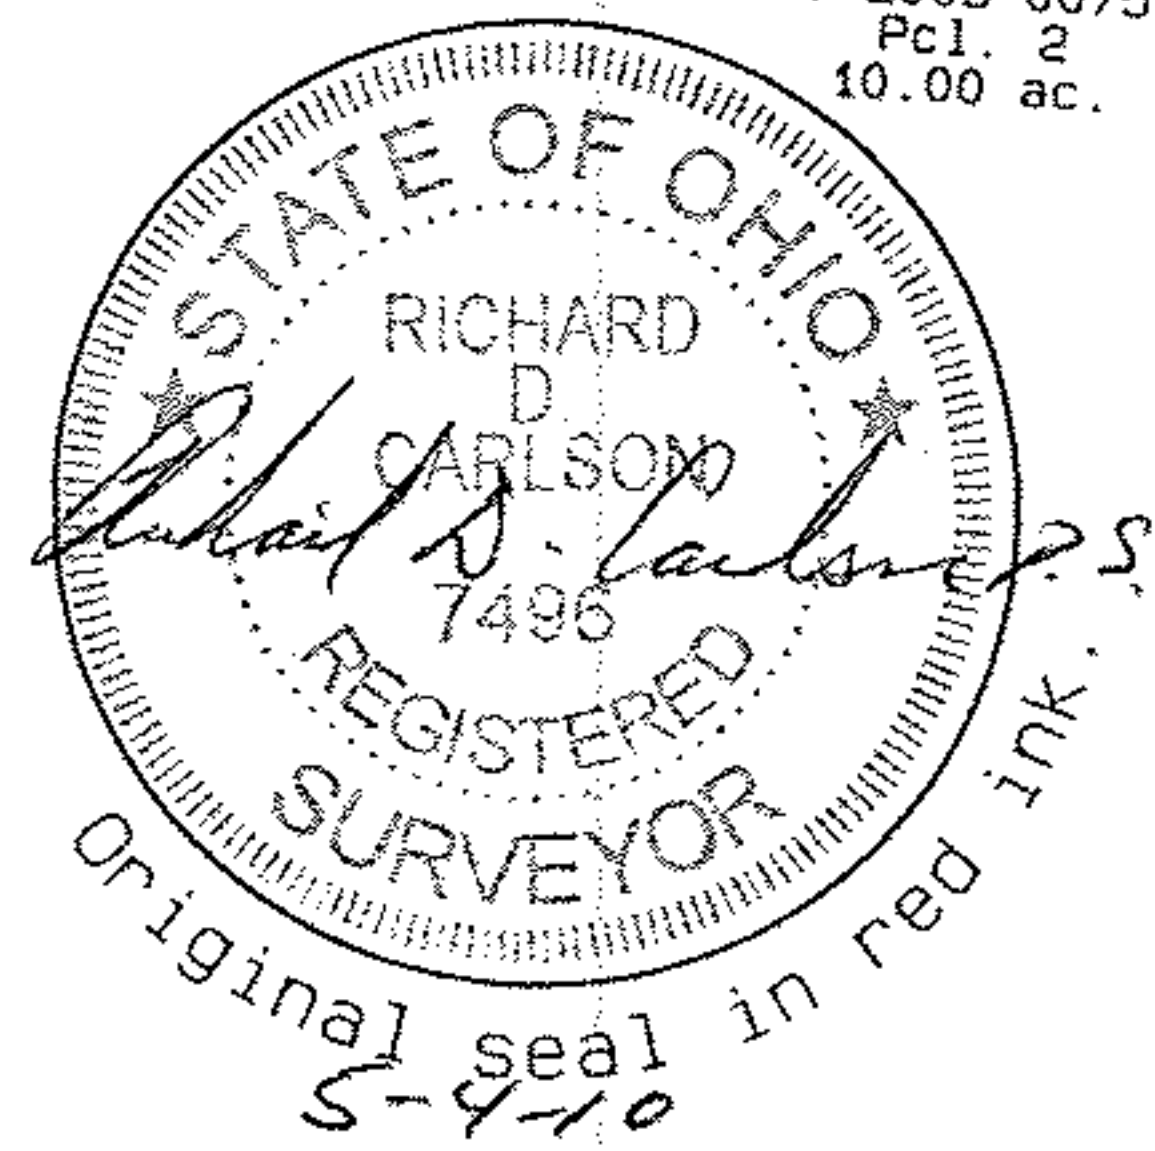

GRAPHIC SCALE 1"=300'

