



# KLEINOEDER-SCHMIDT and ASSOCIATES

ENGINEERS — SURVEYORS — CONSULTANTS IN LAND PLANNING

ELYRIA - NORWALK - MEDINA

OHIO

## SURVEY


Sublot(s) \_\_\_\_\_

Subd'n \_\_\_\_\_

Township AMHERST Tract \_\_\_\_\_  
 Orig. Lot(s) 80 Sec. \_\_\_\_\_  
 County of LORAIN State of Ohio  
 Corporation \_\_\_\_\_

05-00-080-101-

COOPER FOSTER PARK ROAD 60' R/W

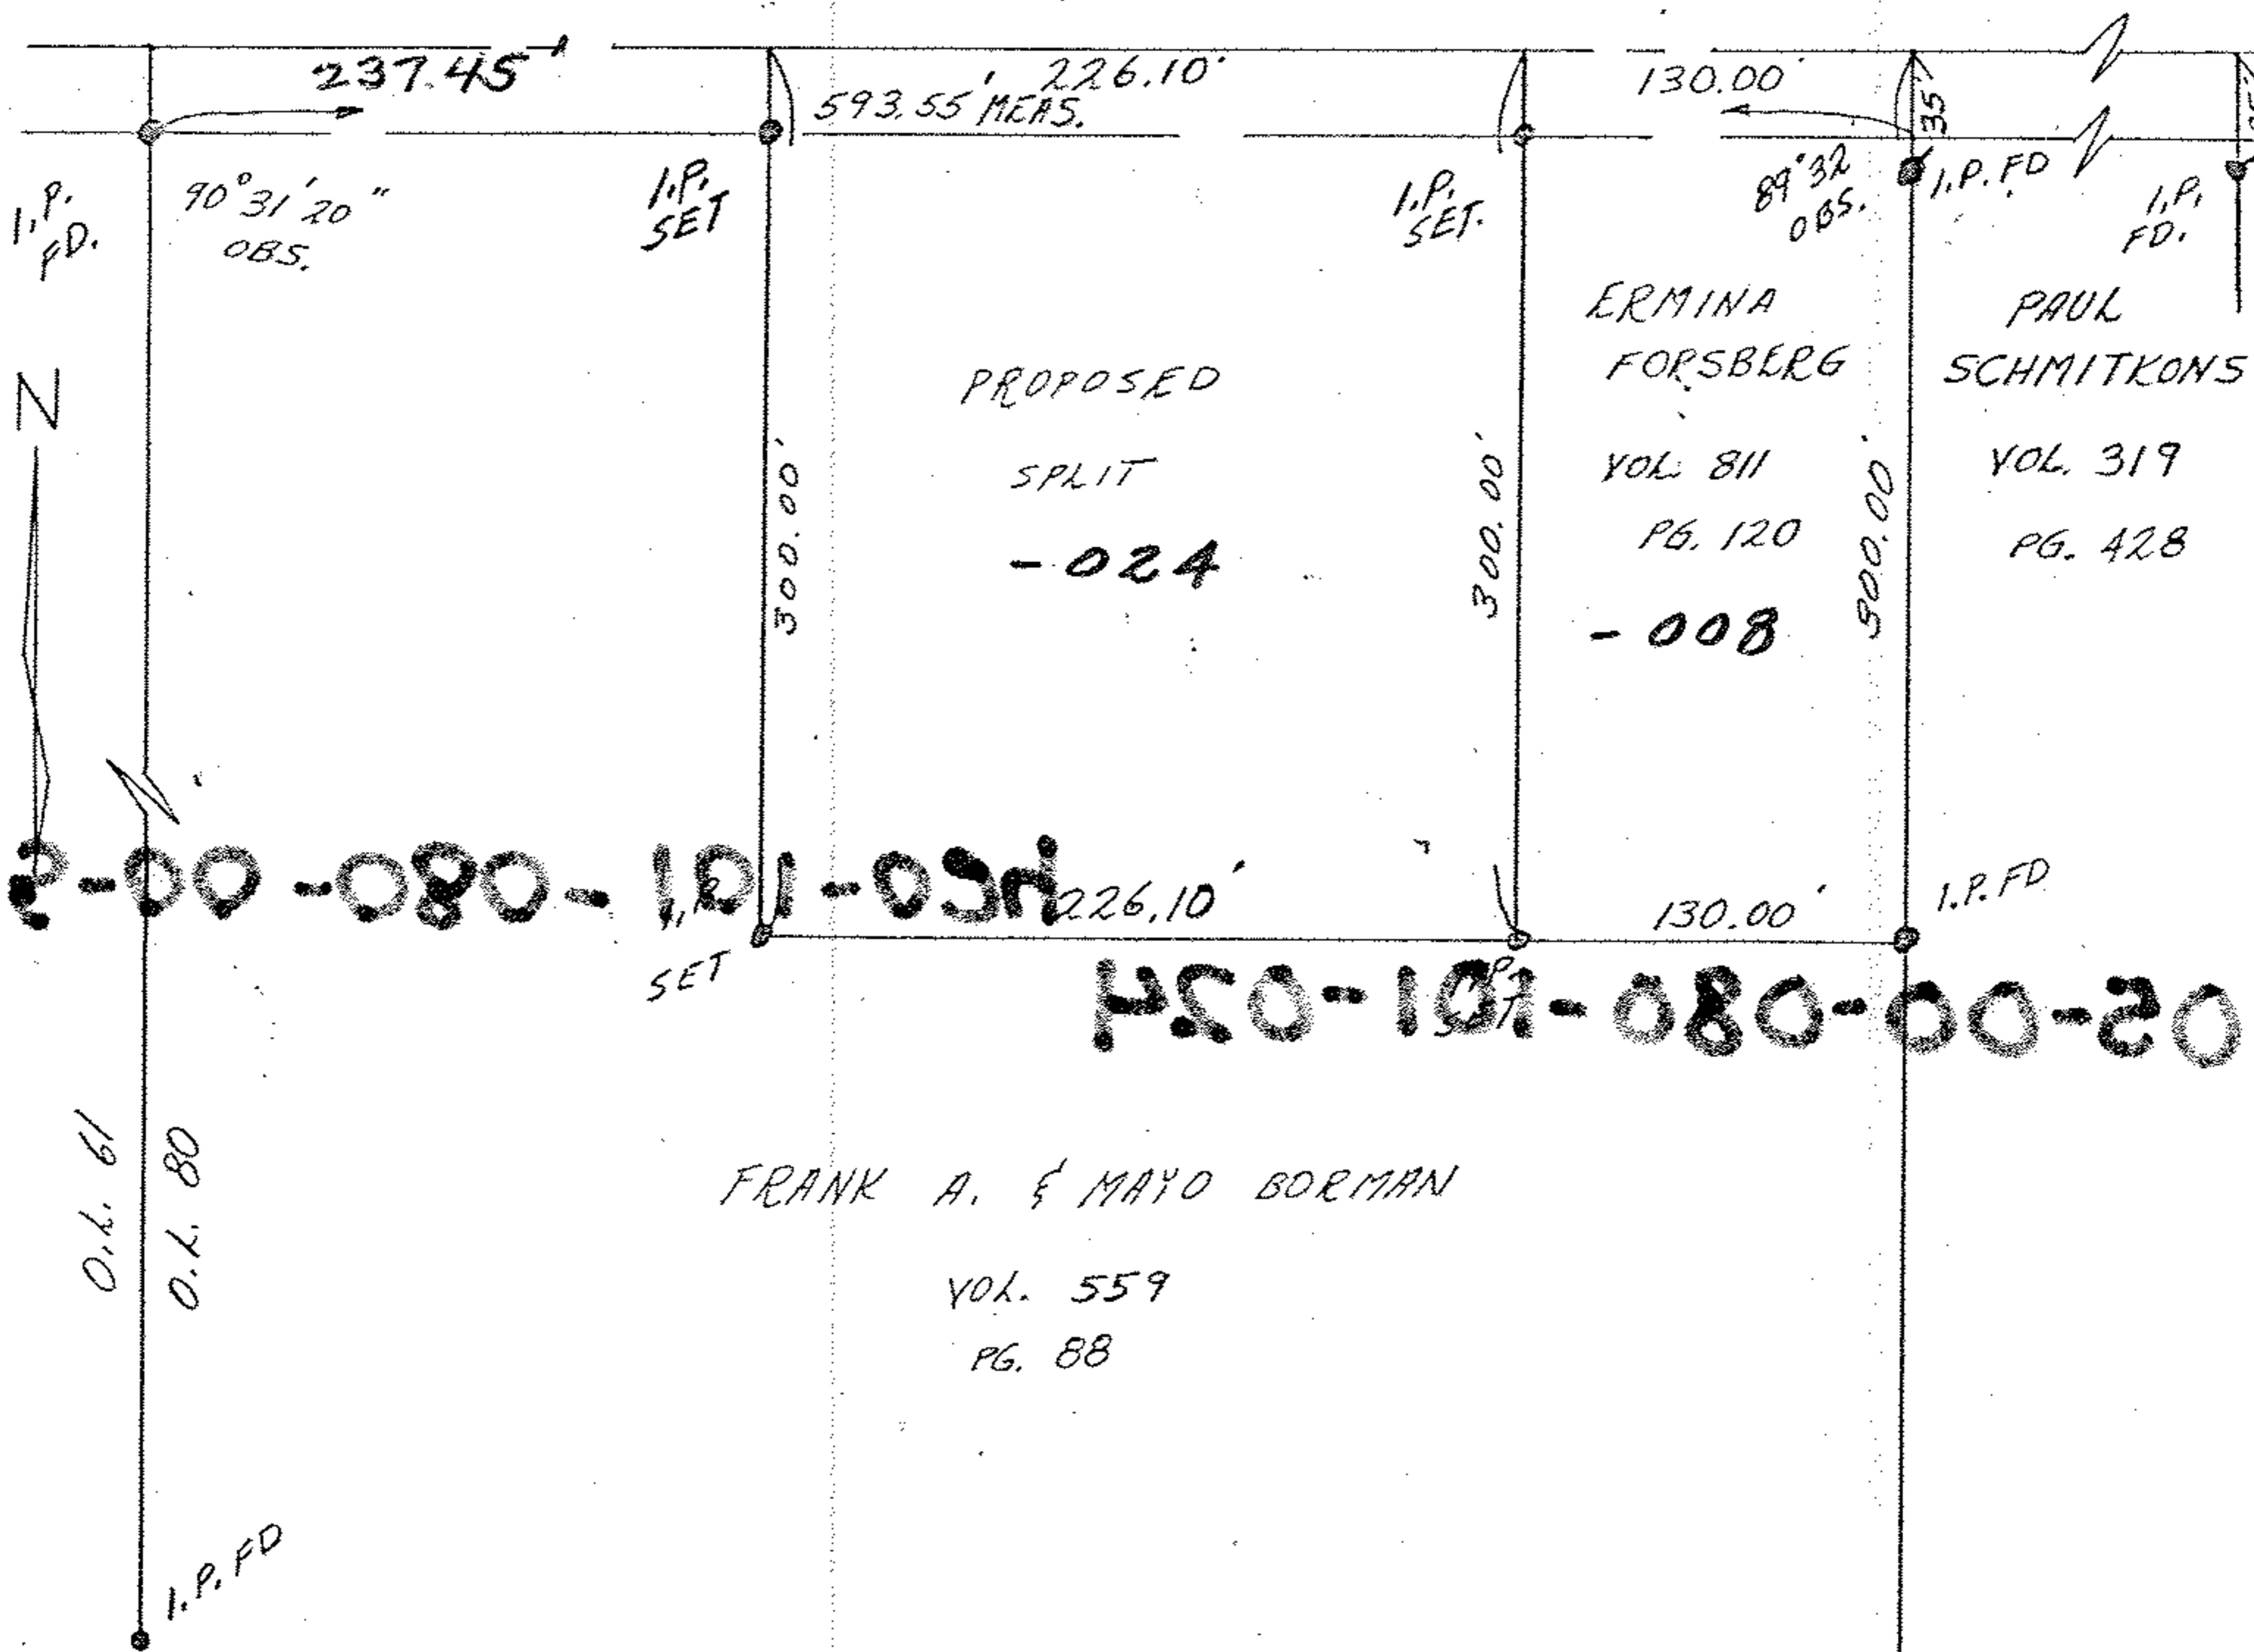

02-00-080-101-024

450-101-080-00-20

FRANK A. & MAYO BORMAN  
 VOL. 559  
 PG. 88

05-00-080-101-024,008  
 part 5-00-080-A

Prepared for: FRANK A. BORMAN 591.36

Scale: 1"=100' | Date: 7/6/76 | Dr. by: KPC | Job No: 76-20