


05-00-000-B 05-00-000-107-015
13
SCAN# 45432

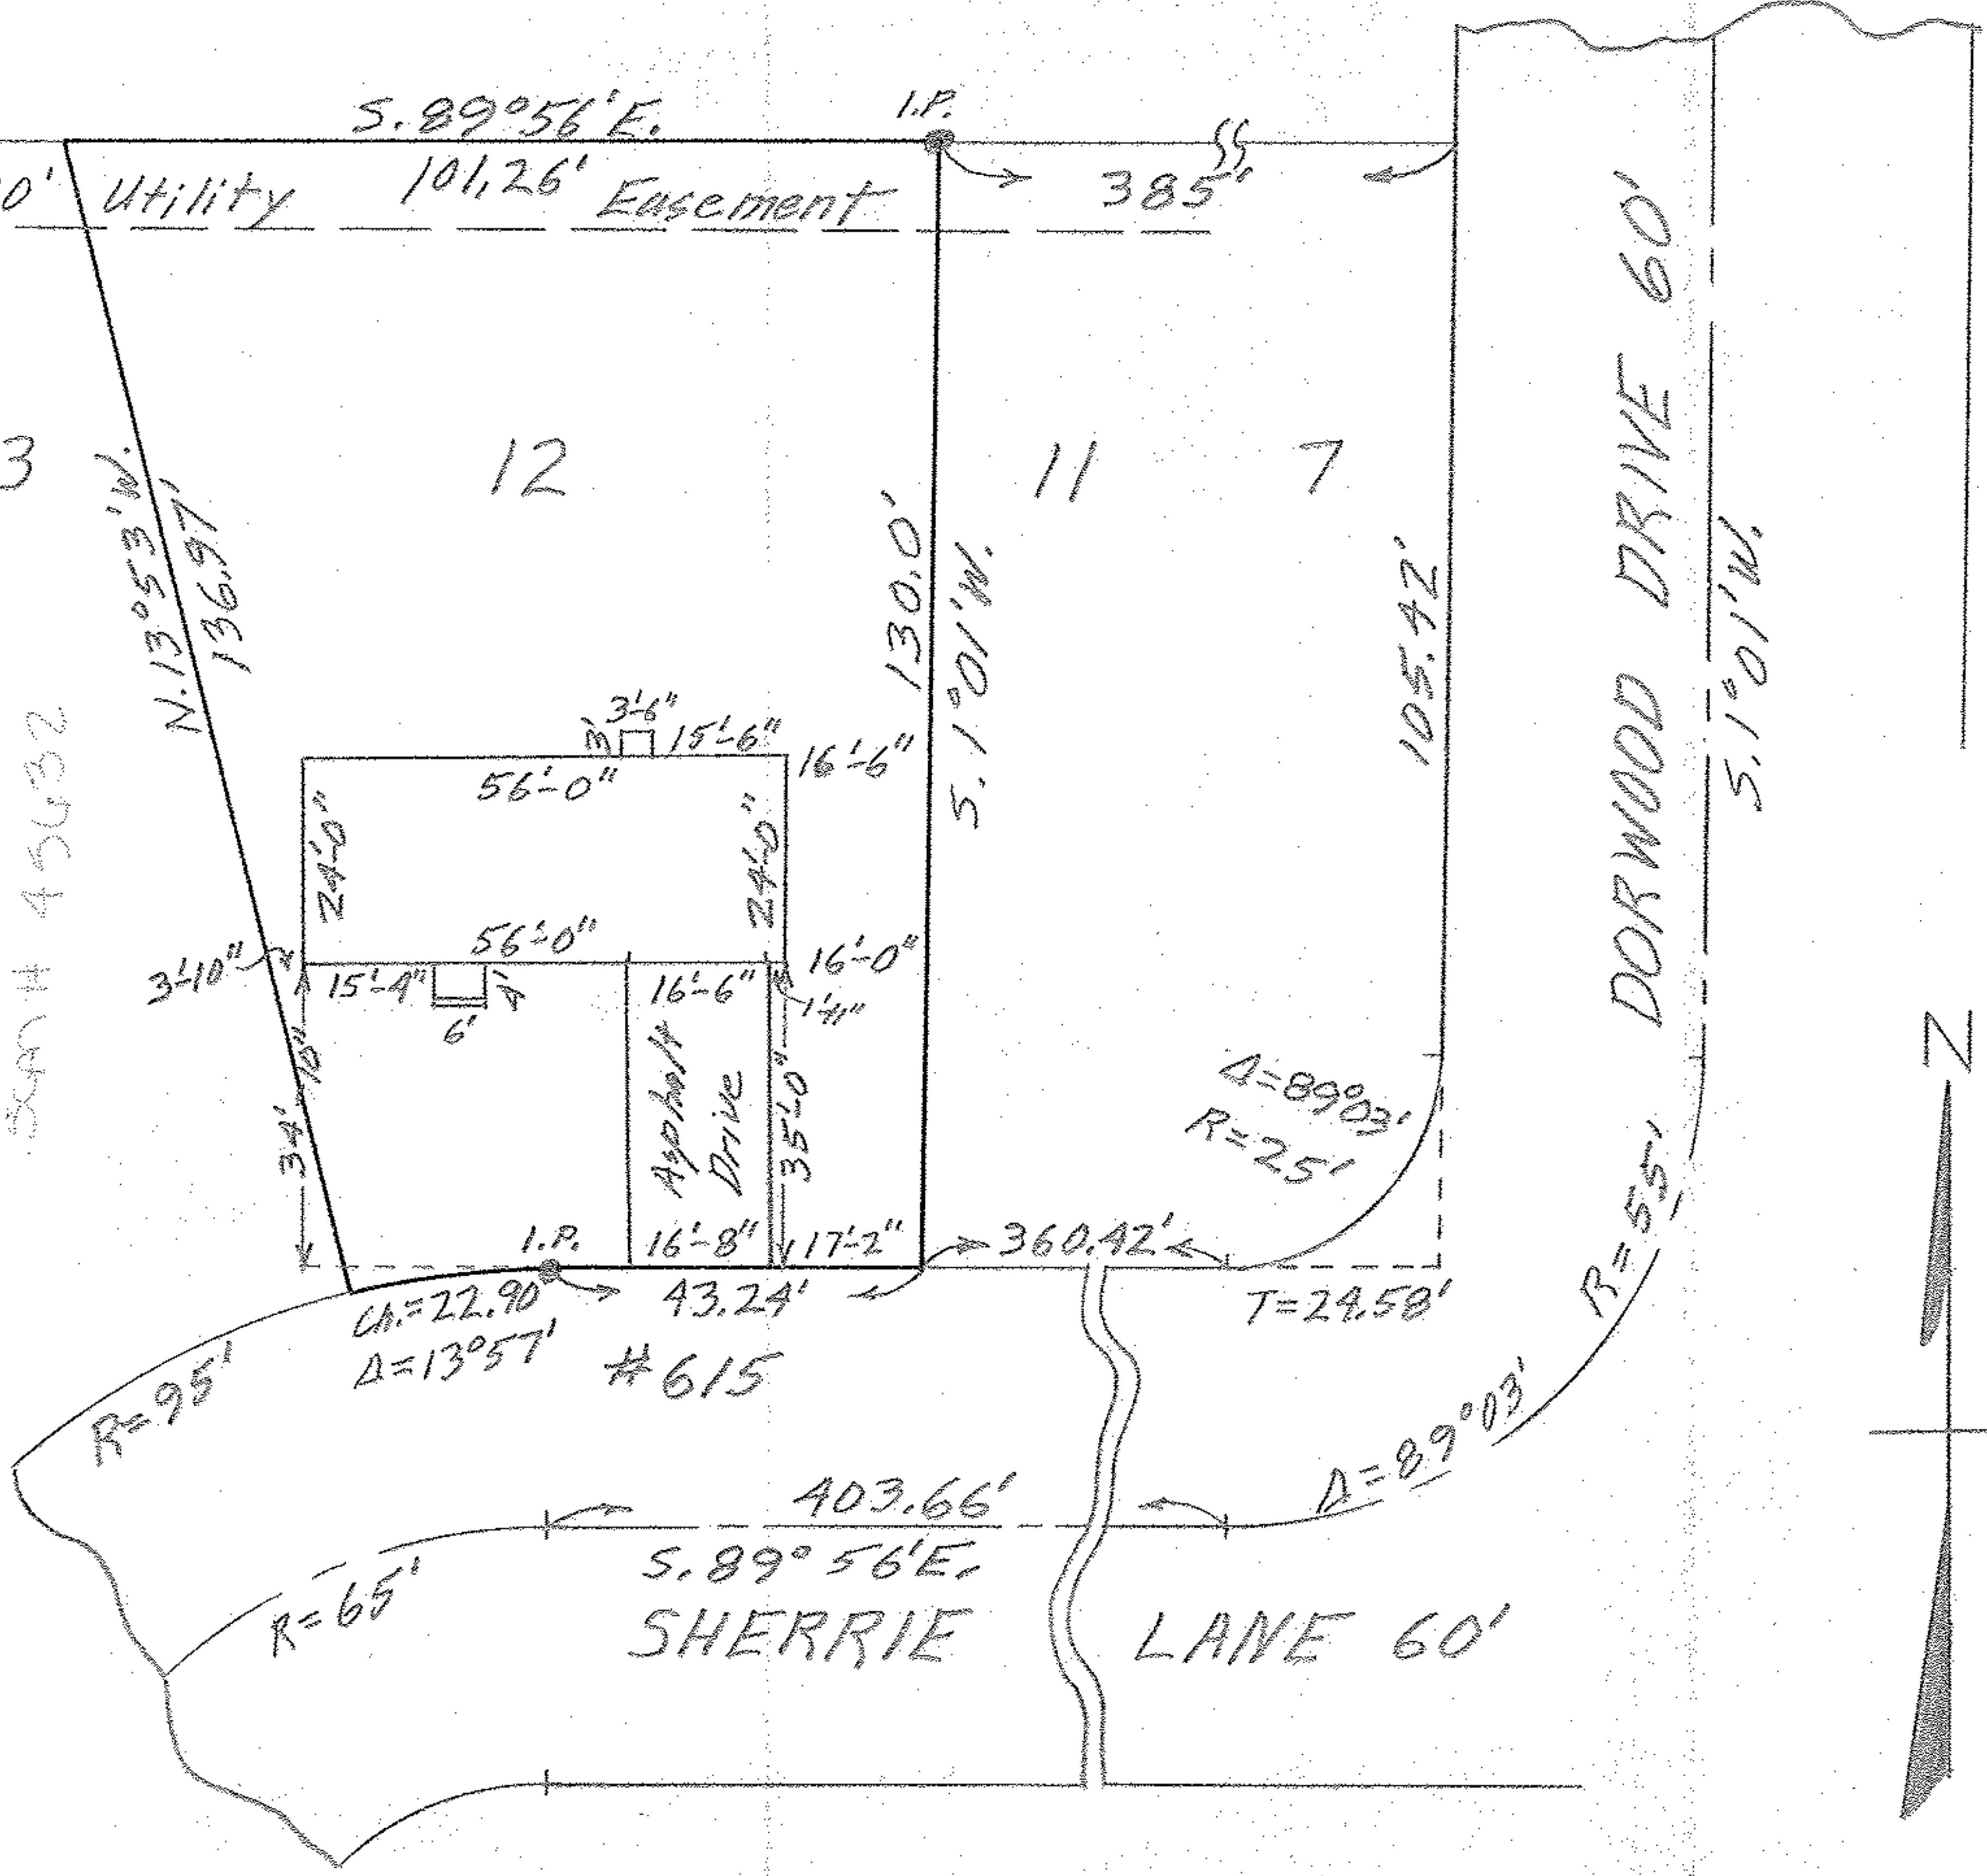

MAP OF SUB-LOT NO. 12
DORWOOD HILL ALL'T. Vol. 20 Pg. 24
ORIG. LOT NO. 80 AMHERST TWP.
LORAIN COUNTY OHIO
SCALE: 1"=30' MAY 25-1965 4:00 P.M.
Gary E. Penfound REG. SURVEYOR

John C. & Mildred Sheridan