



SCAN # 45647  
George & Anna Brezmenik  
D. Vol. 337 Pg. 368

U-5

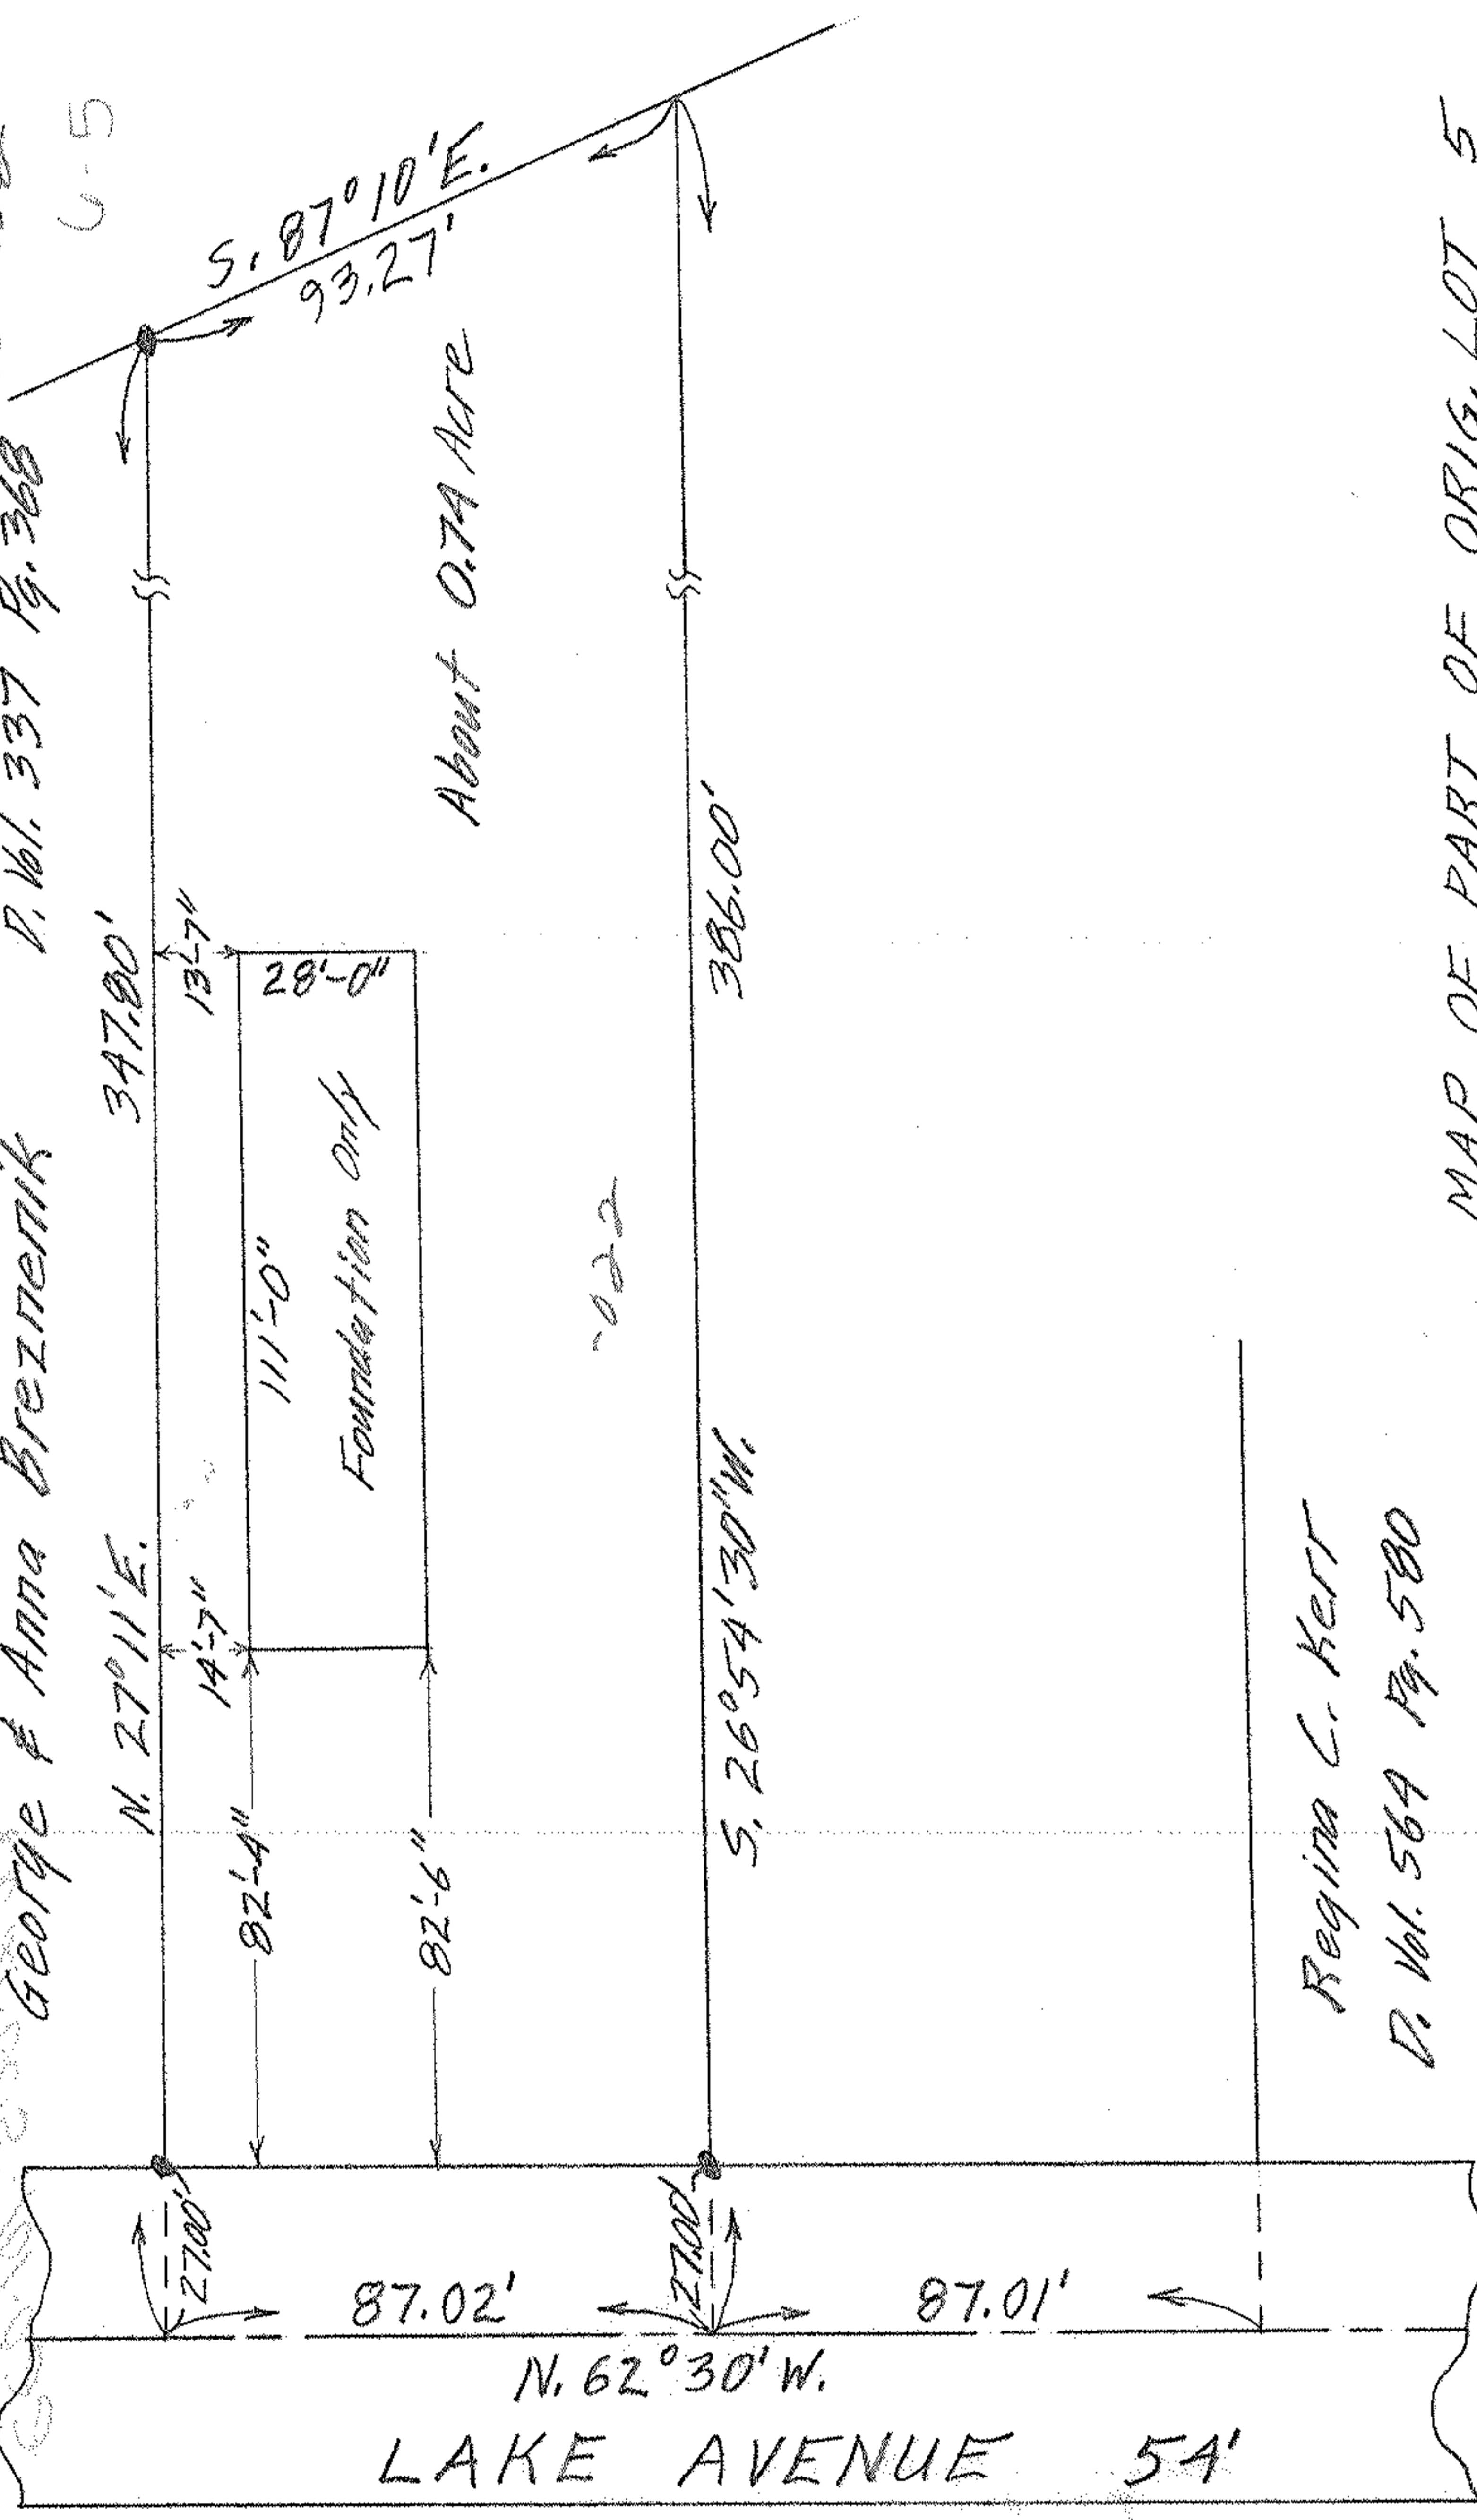

About 0.74 Acre

Regina C. Kerr  
D. Vol. 564 Pg. 580

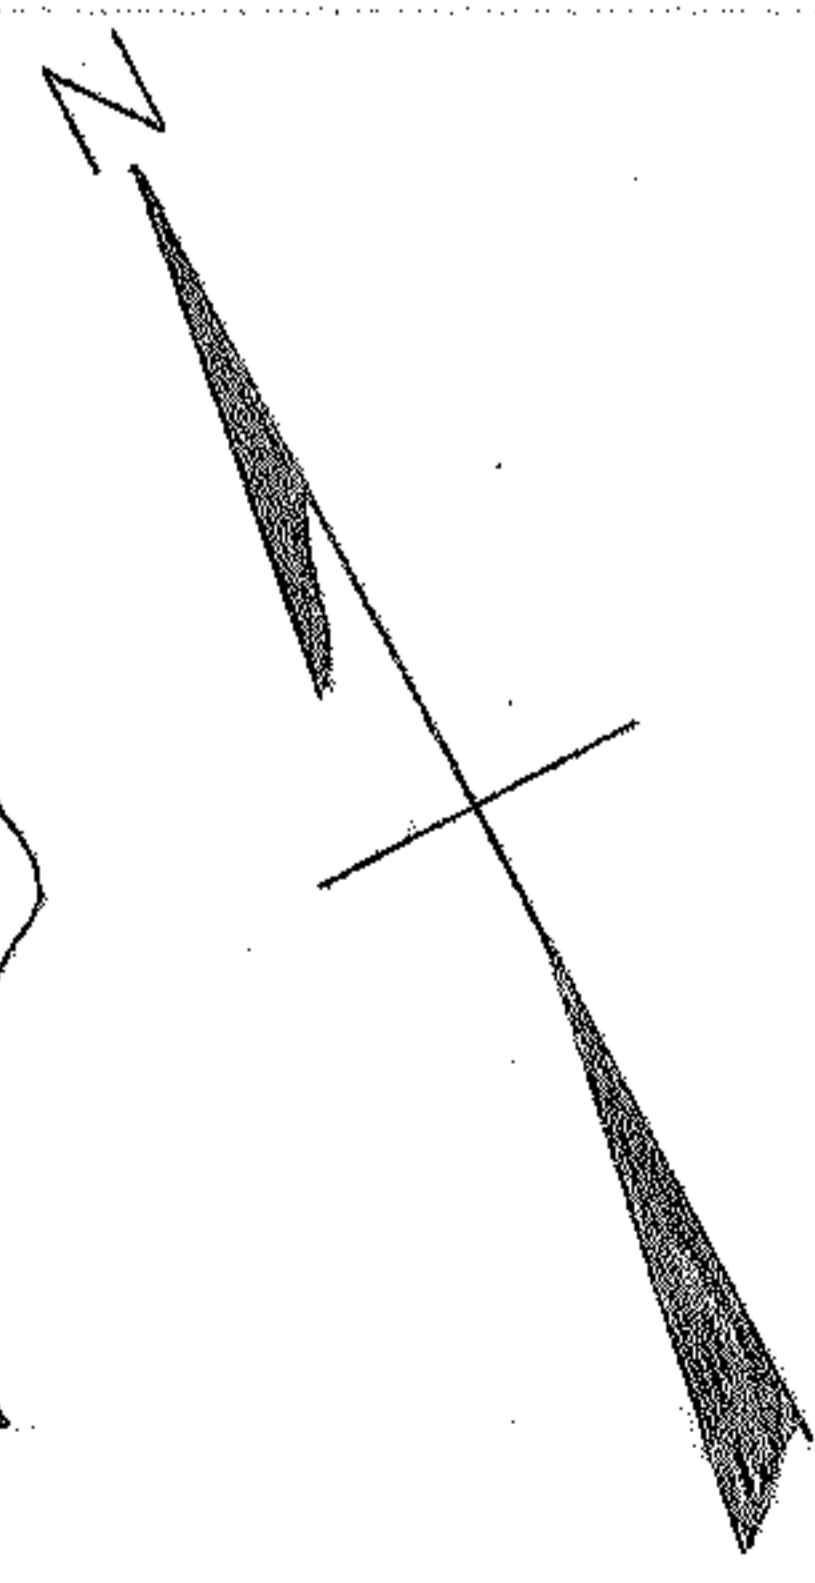

MAP OF PART OF ORIG. LOT 5  
NEWBERRY TRACT ELYRIA TWP.  
LORAIN COUNTY OHIO  
SCALE: 1" = 40' APRIL 4-1962 3:00 P.M.  
Gary E. Penfound REG. SURVEYOR

Gerald E. Garb, Inc. BH