



06-22-008.102-016,017  
SCAN # 45051

947 JUL 13 8 14.0

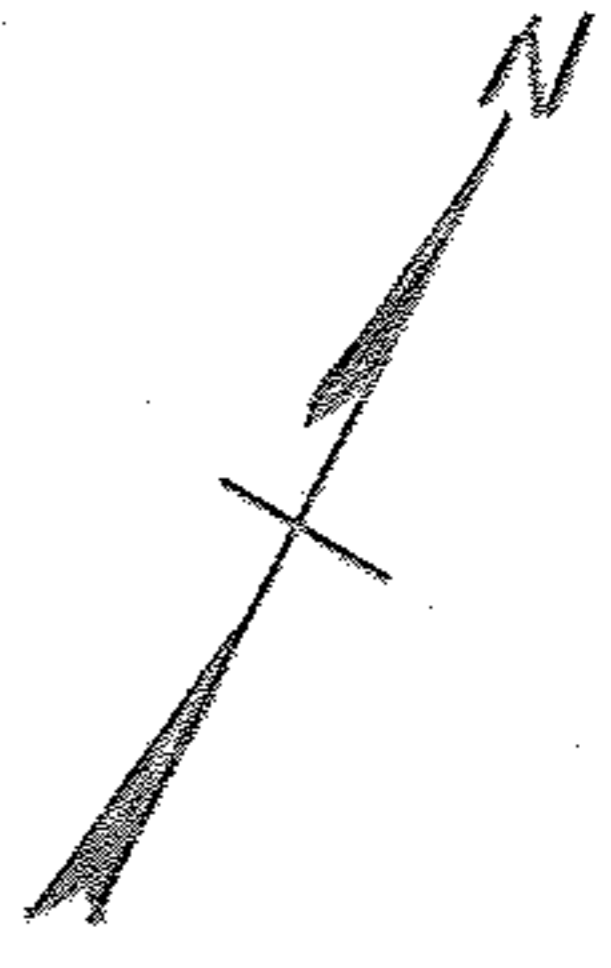

August & Josephine Piazza.

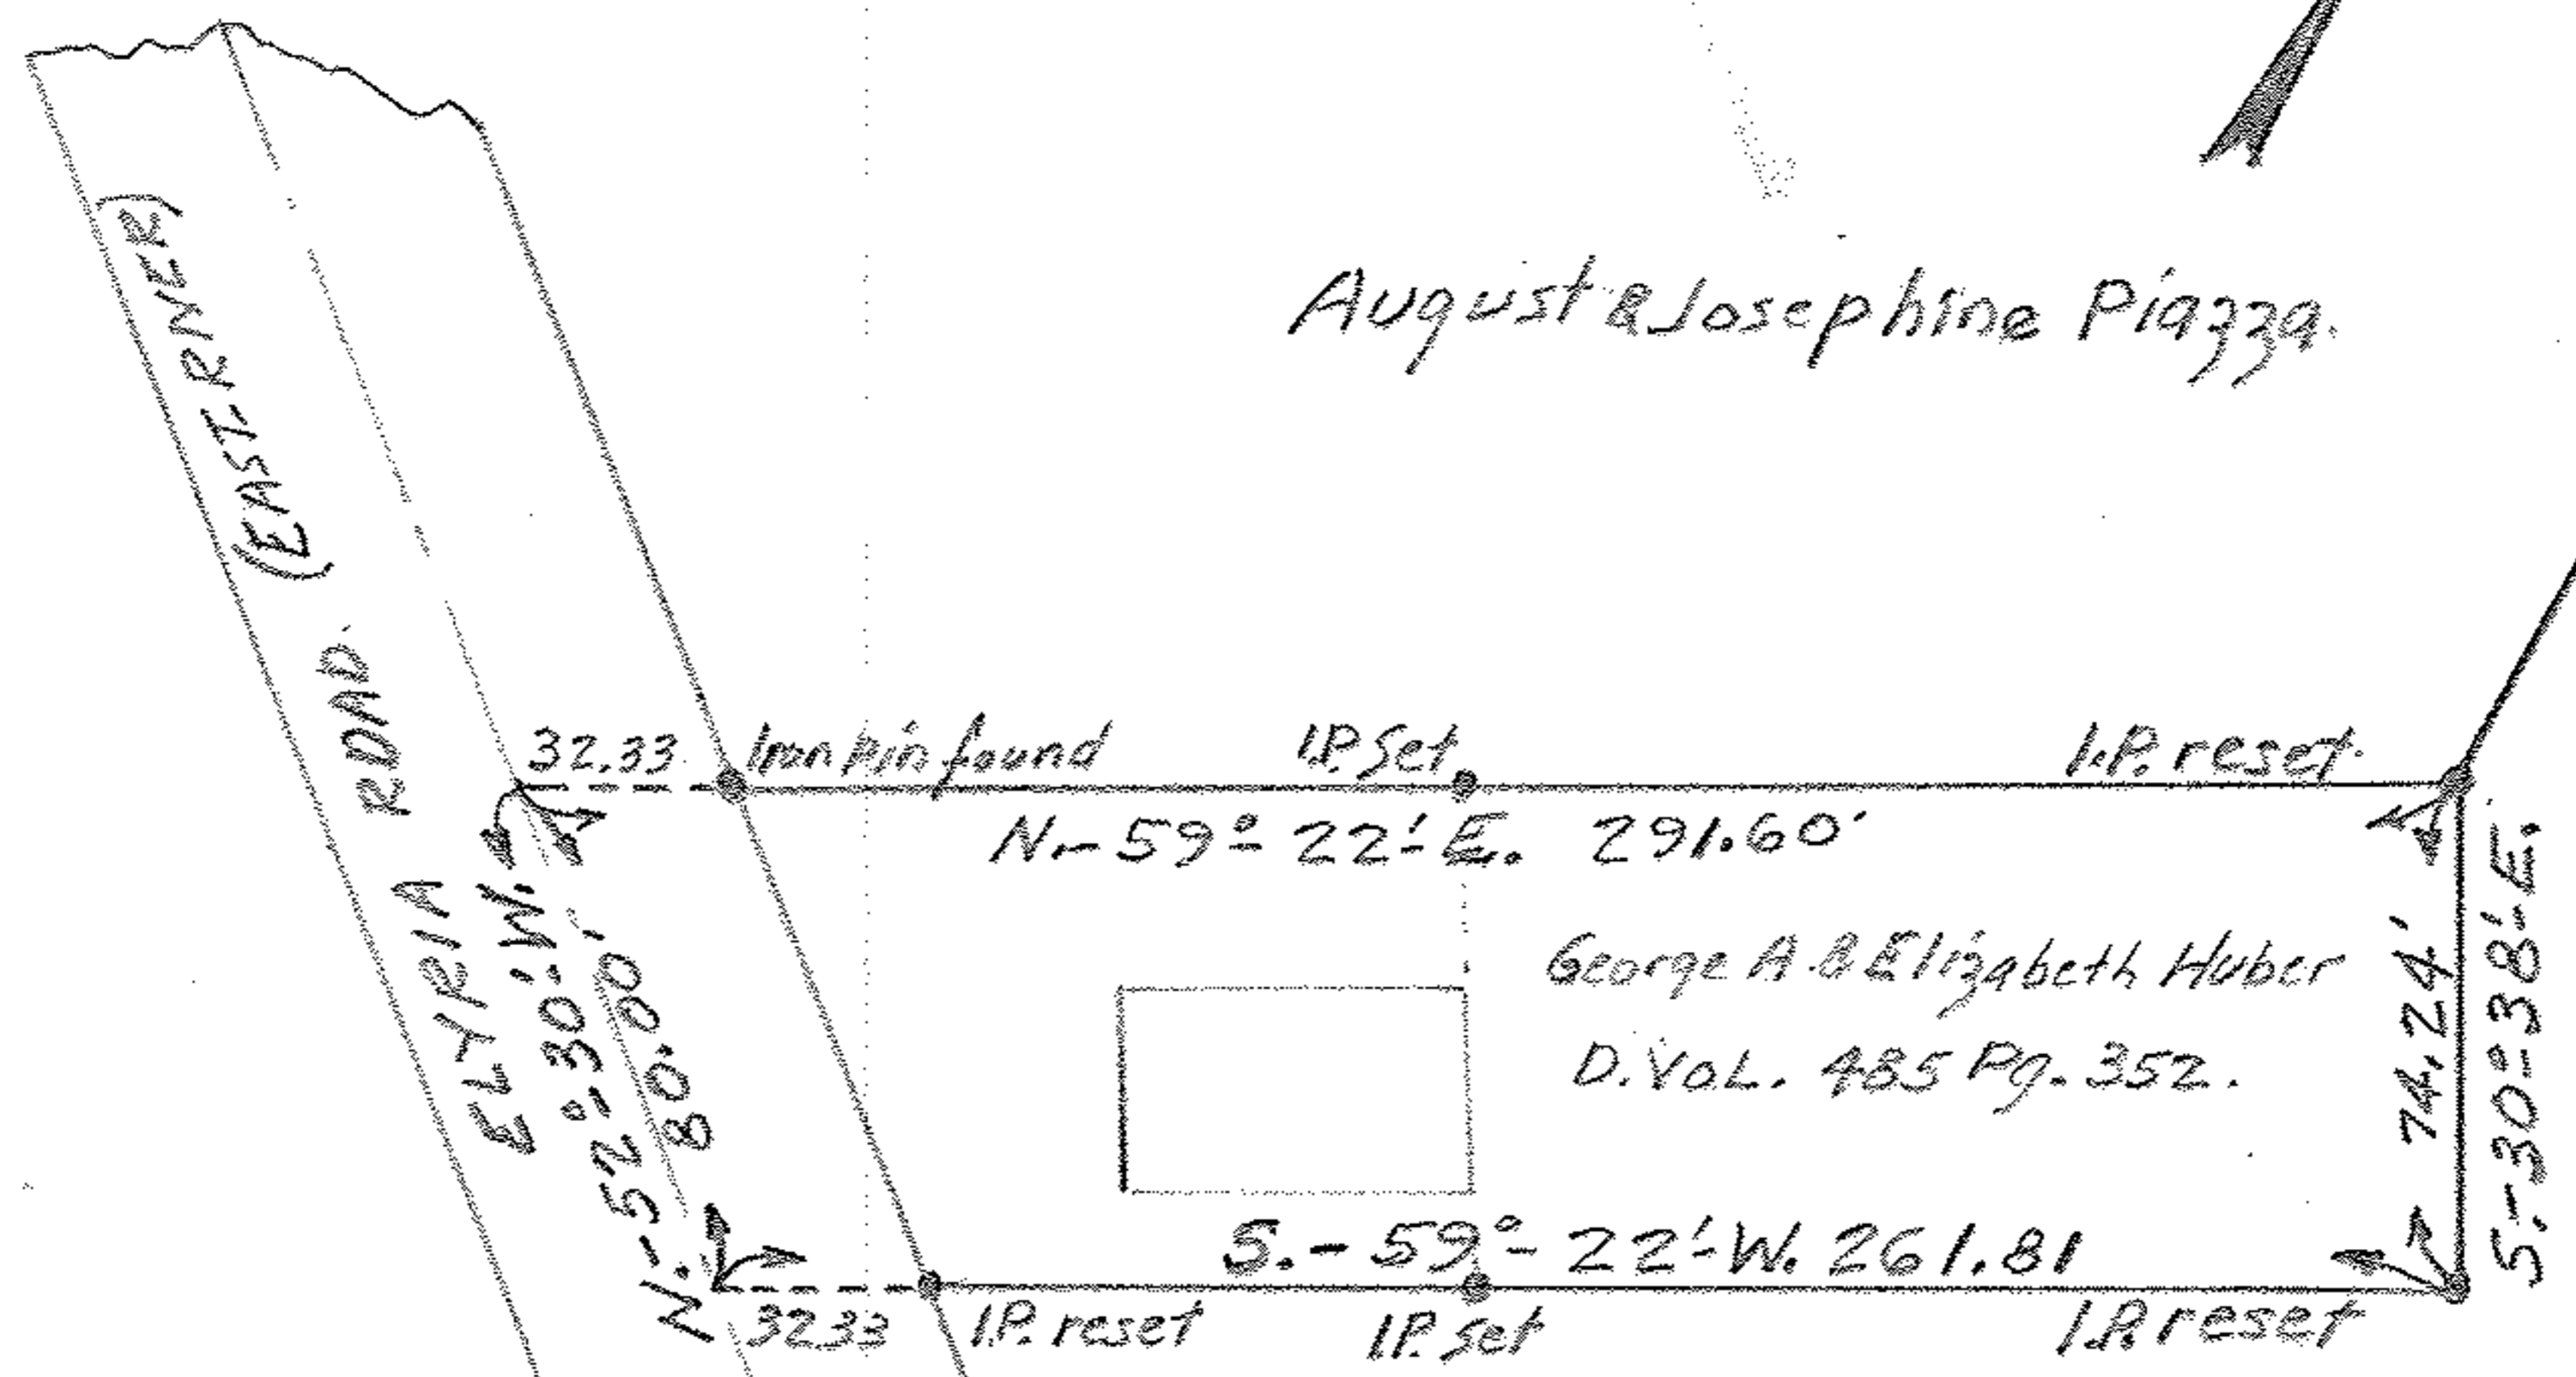

Michael & Antonia Campagna.

LAKE - 475.20'  
SHEFFIELD

MAP OF SURVEY FOR  
 George A. & Elizabeth Huber  
 O.L.B. BURRELL & DAY TRACT  
 ELYRIA TWP. LORAIN CO. OHIO  
 Scale 1" = 60 FT. JULY 13-1951  
 Original Survey by C.T. Biggs - 1946  
 Resurveyed by C.E. Penfound Reg. Surveyor

