

6-41 06-23-007-000-005

MAP OF PART OF ORIG. LOT NO. 7 - BRACE TRACT  
ELYRIA TWP. LORAIN COUNTY OHIO  
SCALE: 1" = 30' APRIL 1-1970 5:30 P.M.

NOTE: There are no encroachments  
on this property. Scan # 45463

Gary E. Penford  
REG. SURVEYOR NO. 9457

Helen E. Lehman D. Vol. 712 Pg. 652

Earl R. & Lorraine J. Wonder  
D. Vol. 386 Pg. 559

Easterly about 119.90'

Northerly about 383.46'

CITY TITLE CO.  
Order No. E-1068-9  
Marie L. Rodman to  
Thomas C. & Sandra S. Miller

383.46'

Joseph R., Jr. & Mary Ann Fenik D. Vol. 760 Pg. 728

MURRAY RIDGE

ROAD

1624.5'  
D. Vol. 712 Pg. 652

N

I.P.


#42356

S. 89°27' W.

119.90'

GRISWOLD ROAD

I.P.

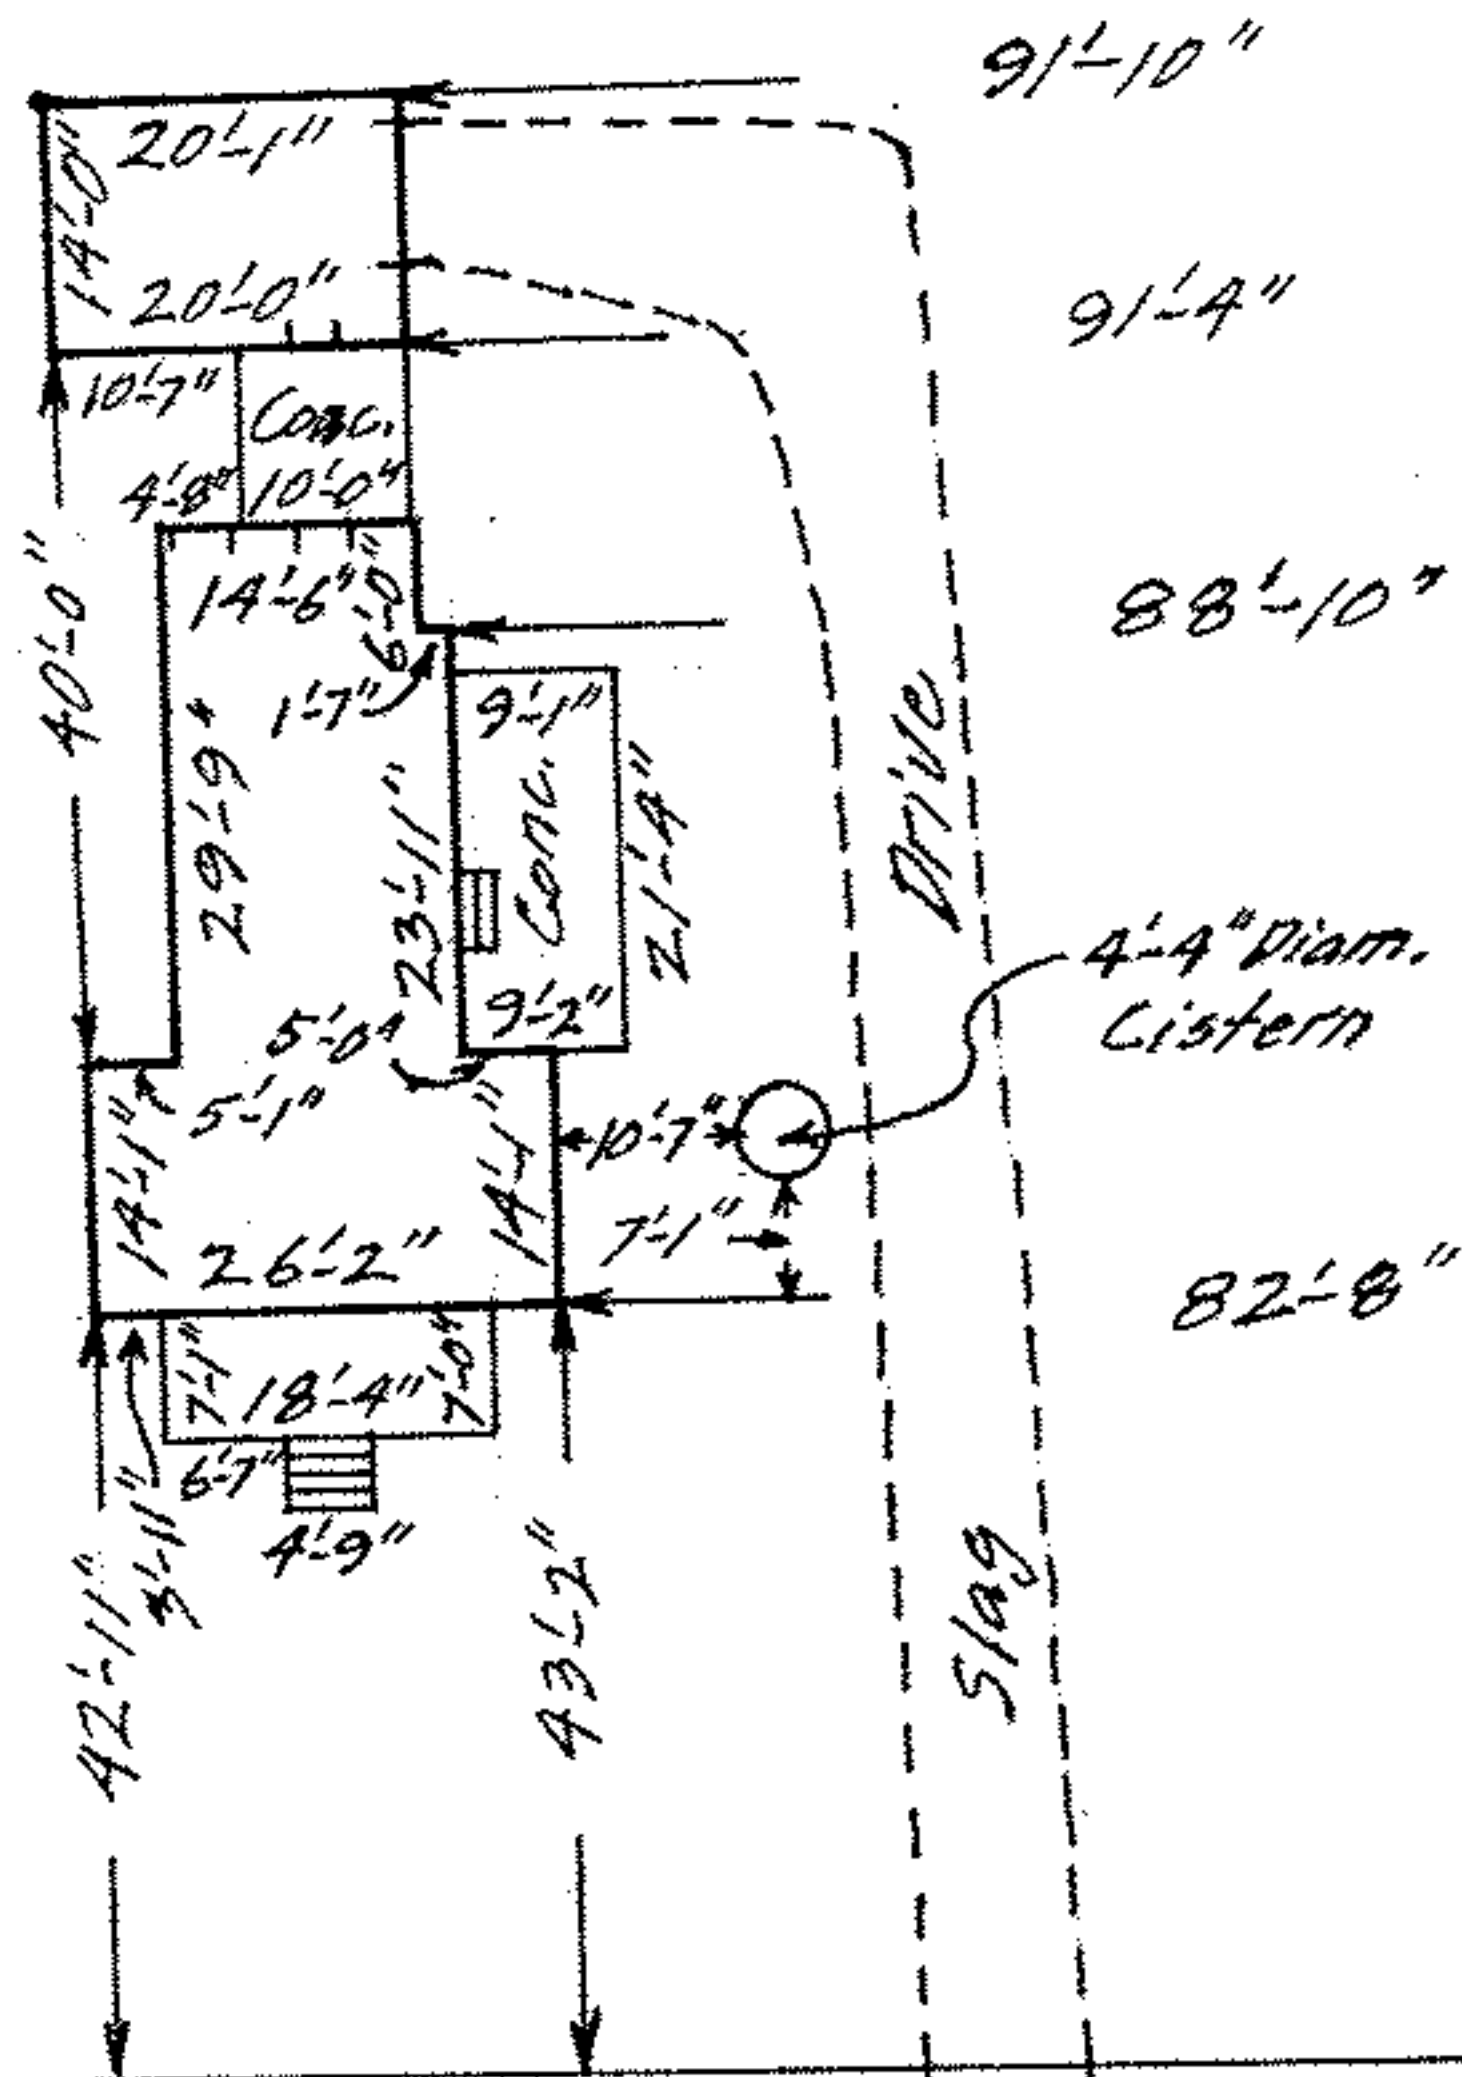

5.0°21' W.

30'