


06-23-017-102-017-020

6-29

SCAN# 45672

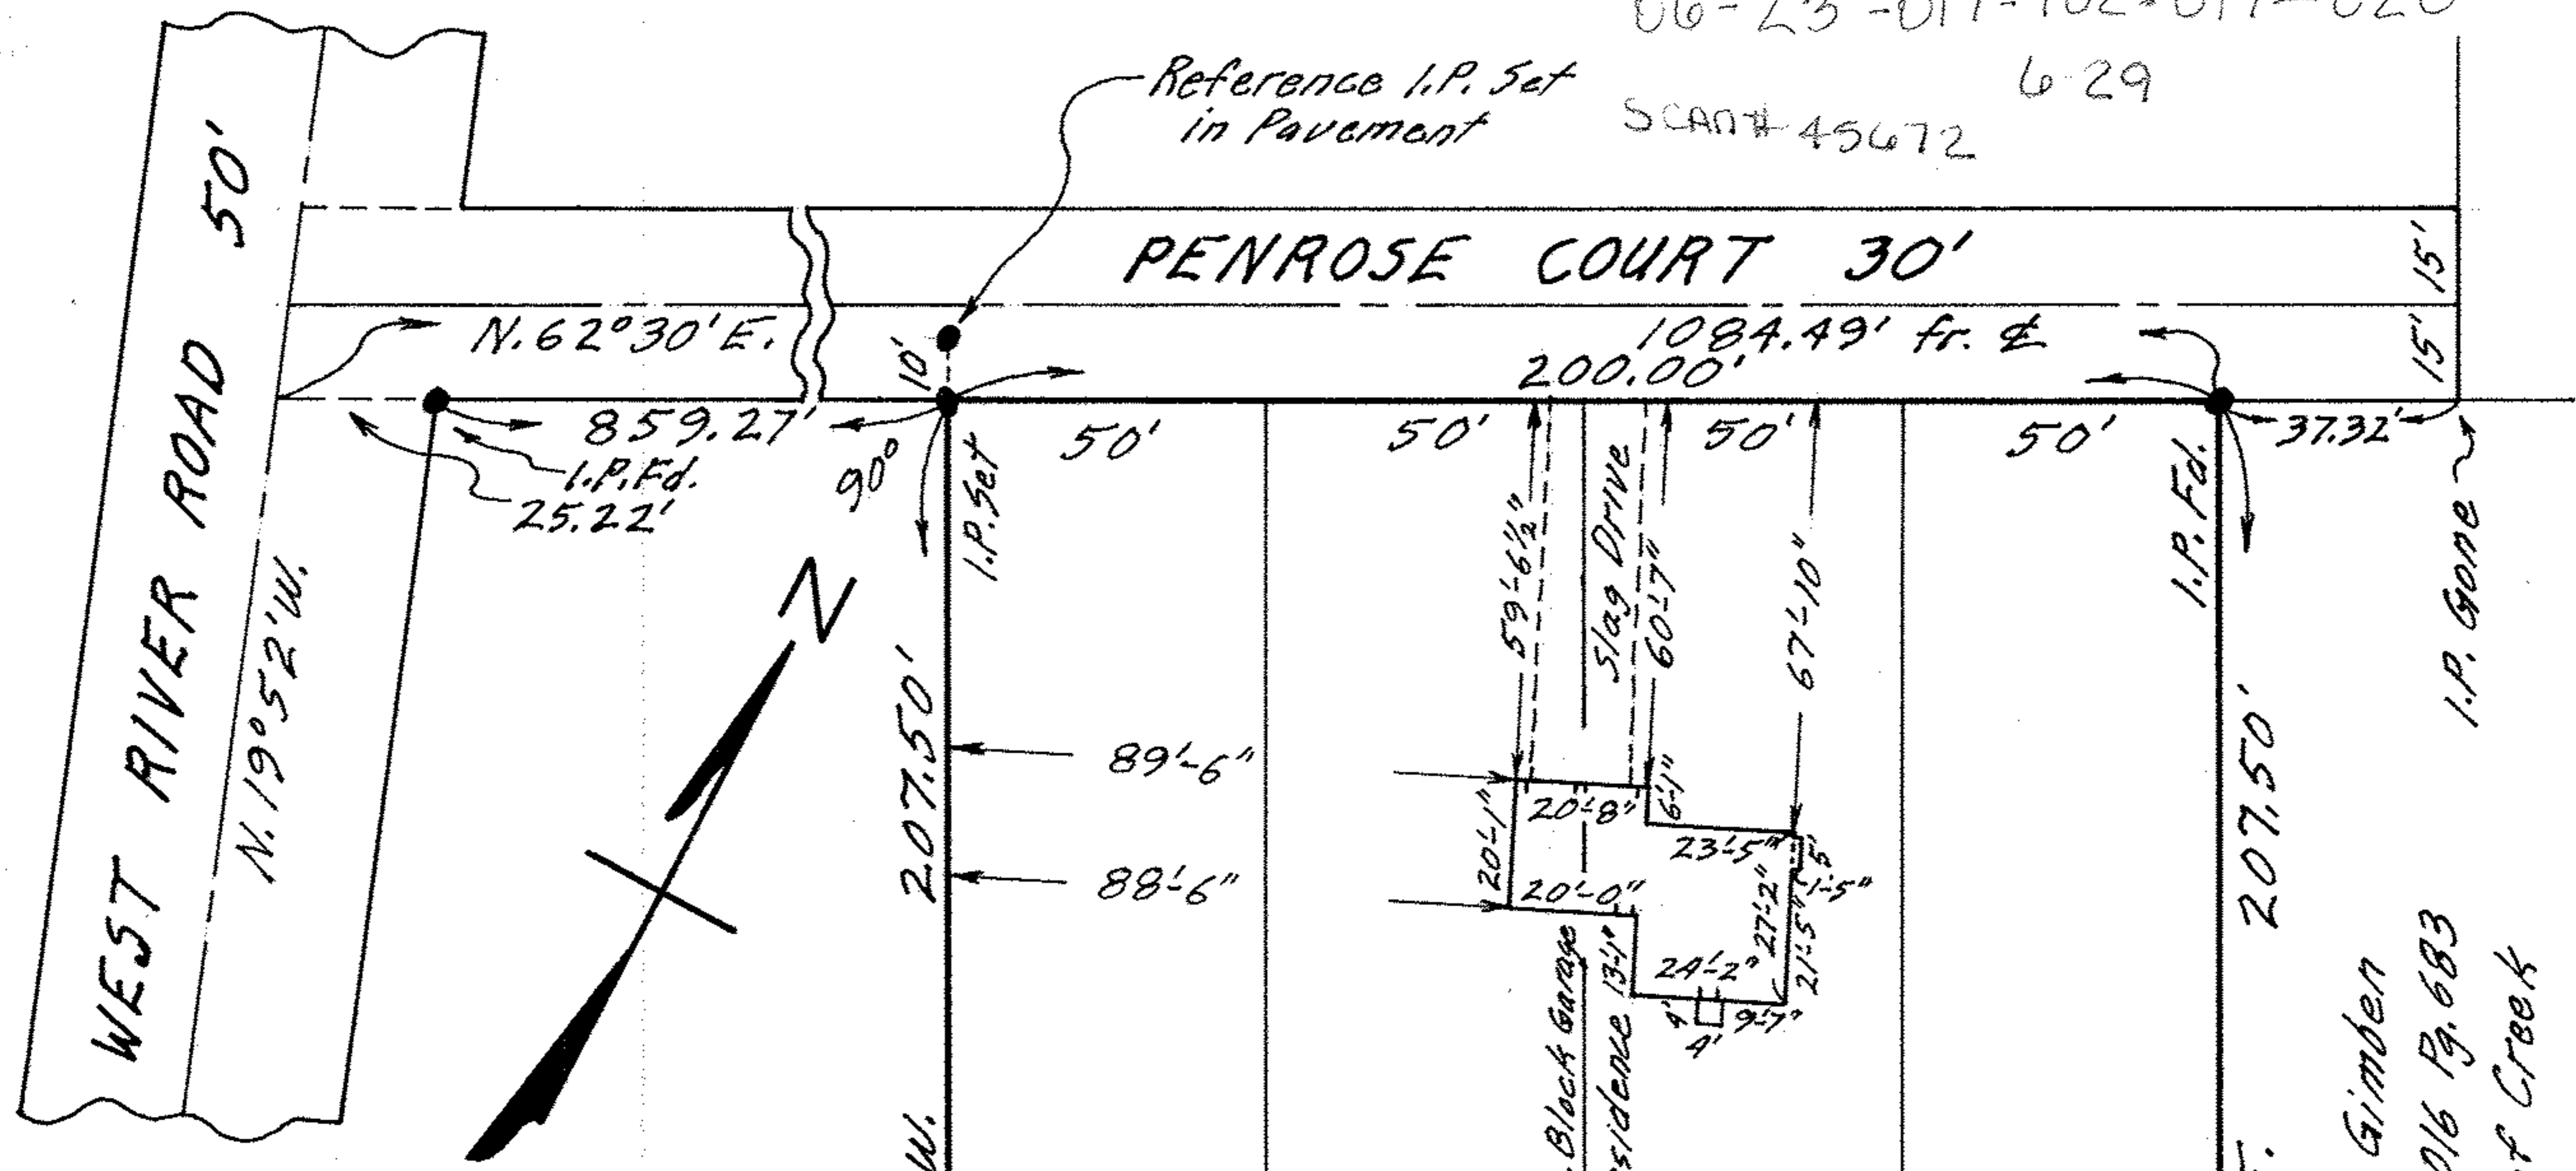

PLAT OF SURVEY FOR  
 MIKE & BERNICE GIMBEN  
 SUB-LOTS 20-21-22 & 23 OF  
 PENROSE ALLOTMENT  
 VOL. 13 PG. 6 PLATS  
 ORIG. LOT 17 - BRACE TRACT  
 ELYRIA TWP. - ELYRIA CITY  
 LORAIN COUNTY - OHIO  
 SCALE: 1" = 40' JAN. 16 - 1973

Gary E. Penfound

Reg. Surveyor No. 4457

Mike & Bernice Gimben  
 Pl. No. 2 D. Vol. 1016 Pg. 683  
 Easterly to & of Creek