


06.23.025.104.007, 008
6-50 SCAN # 45674

06.23.025.104.007, 008
6-50 SCAN # 45674

CRESTVIEW DRIVE 60'
N. 1°12'30"E.

BUCKINGHAM DRIVE 60' R=98.45'
N. 88°47'30"W.

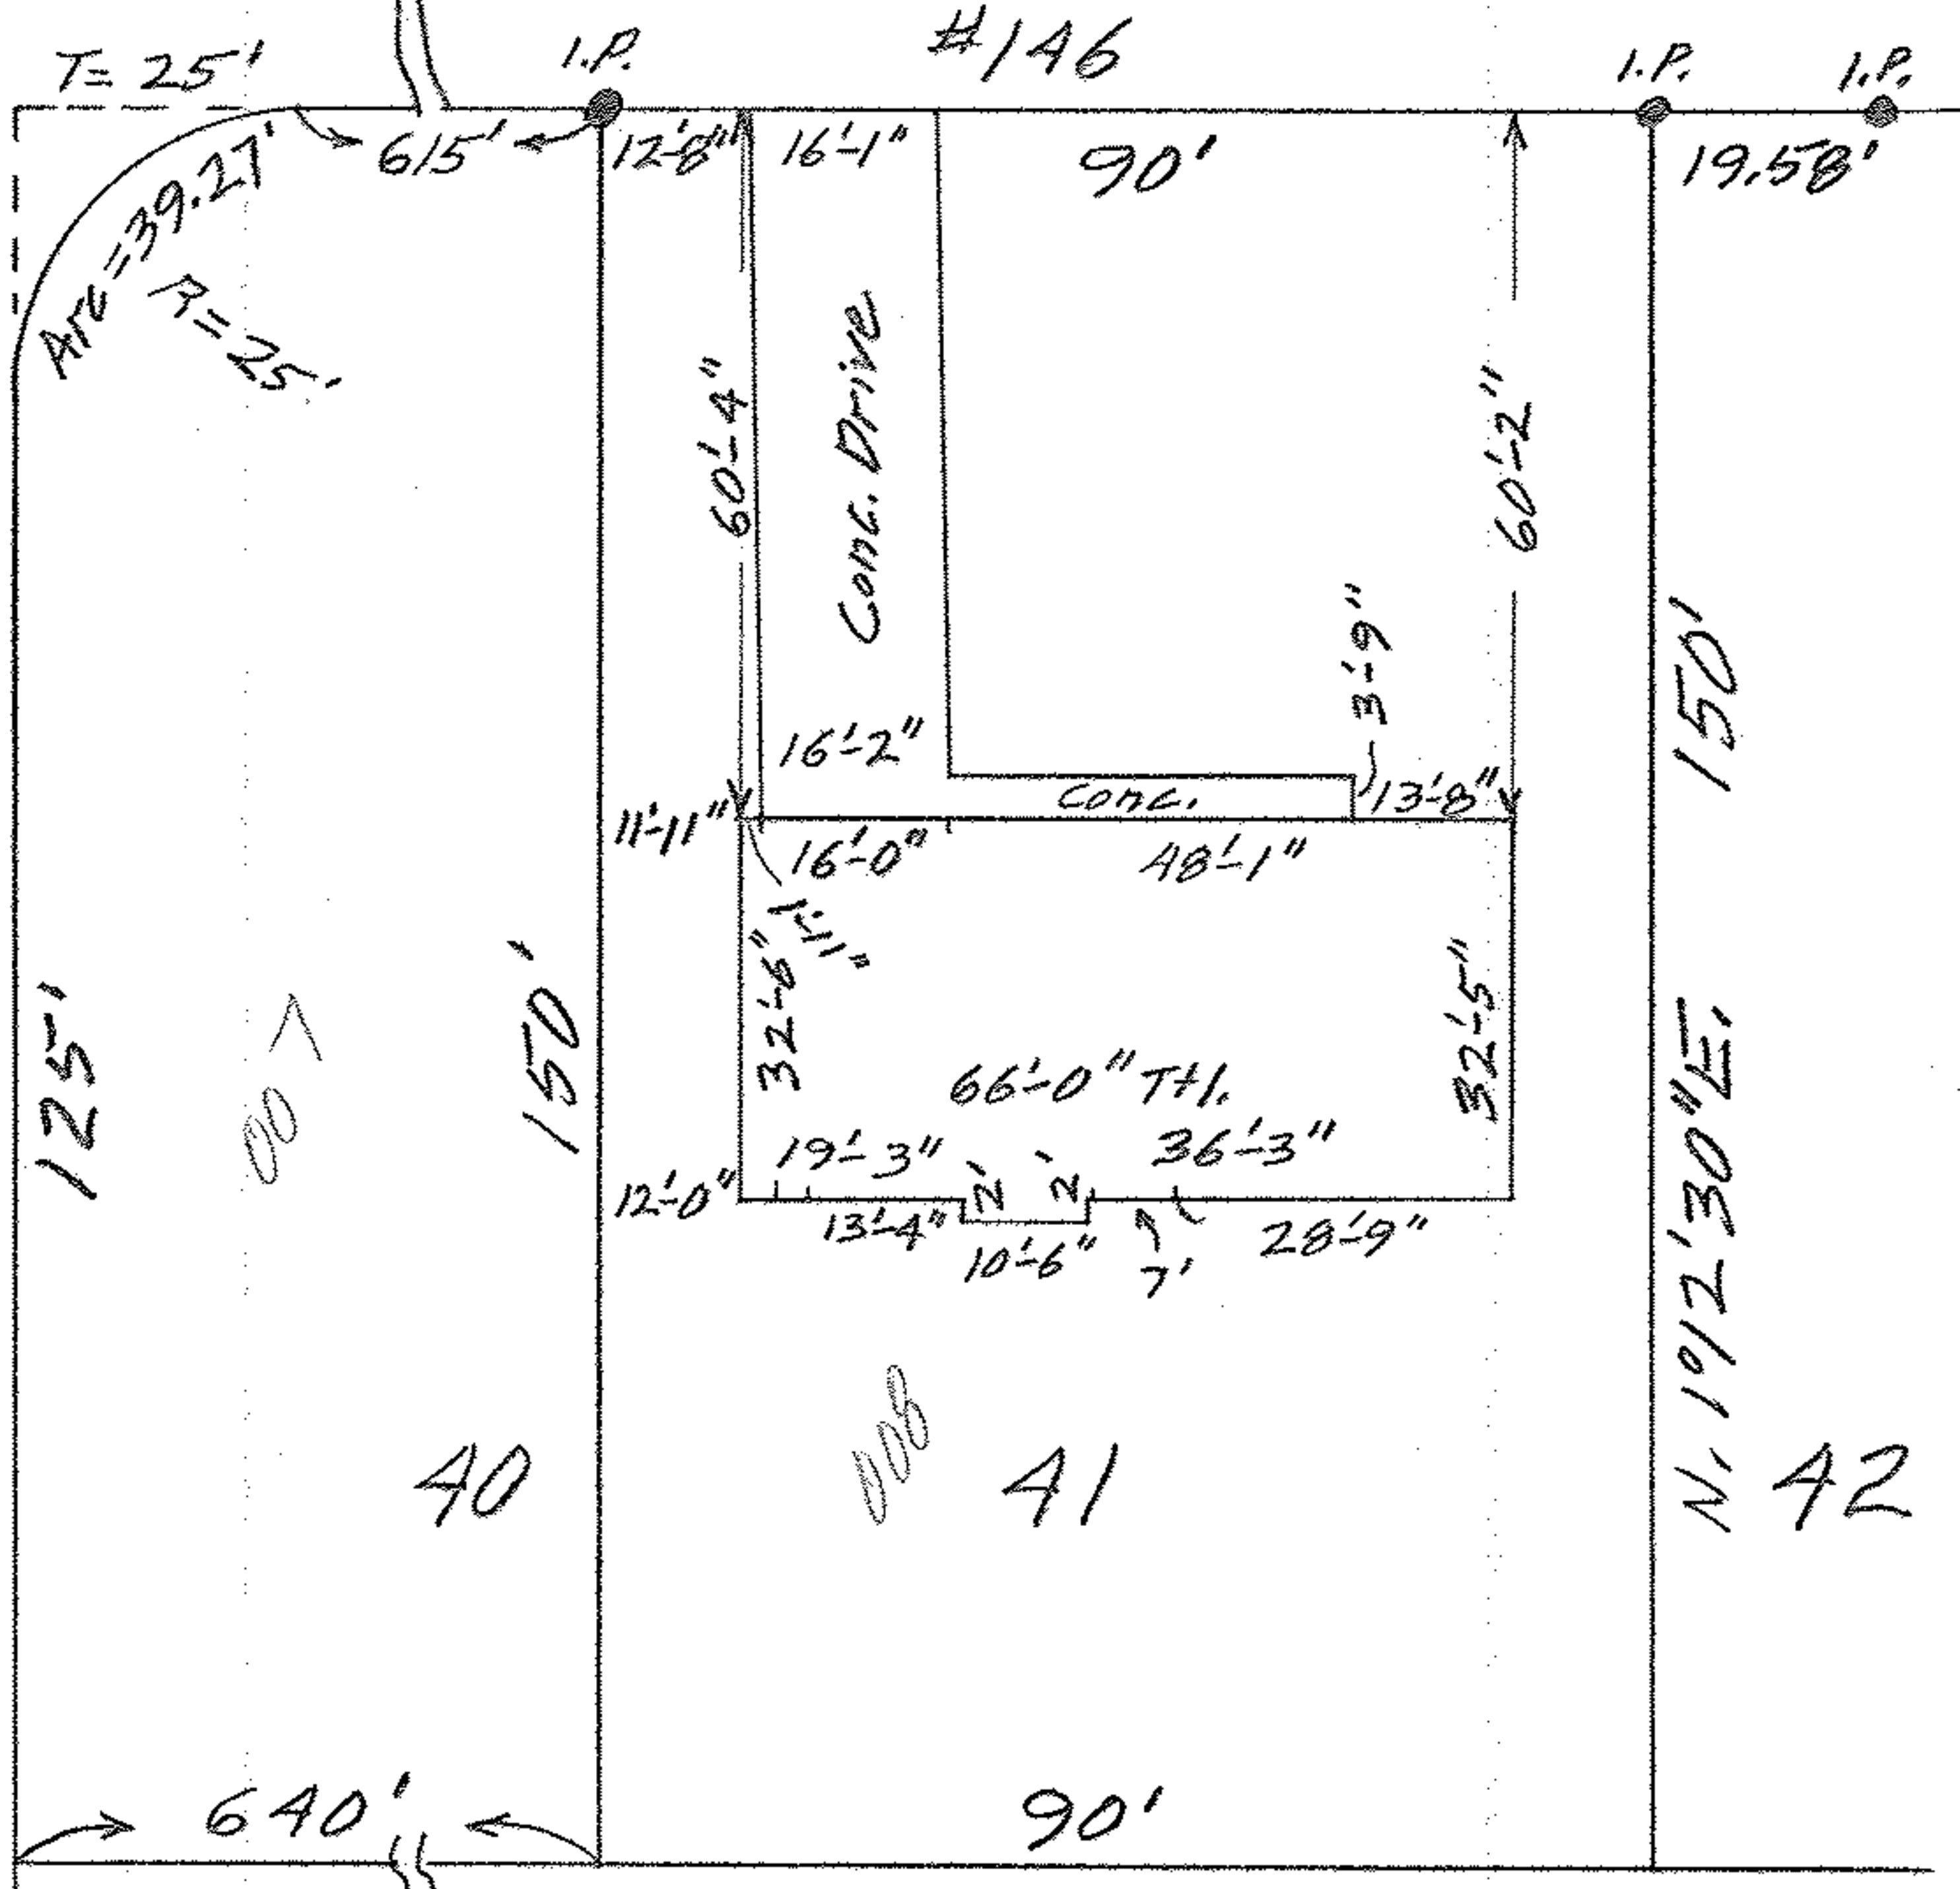

MAP OF SUB-LOT NO. 41
 SPRING VALLEY ESTATES VOL. 19 P. 2
 O.L. 25 BRACE TRACT ELYRIA TWP.
 ELYRIA CITY - LORAIN CO. - OHIO
 SCALE: 1"=30' OCT. 10-1964 4:00 P.M.
 Gary E. Penfound REG. SURVEYOR
 Charles J. & Barbara L. Karpus