


SCAN# 45703 06-24-025-102-031 6-78

MAP OF PART OF ORIG. LOT NO. 25 - WEST OF BLACK RIVER
ELYRIA TWP. - ELYRIA CITY - LORAIN COUNTY - OHIO
SCALE: 1" = 30' OCTOBER 26 - 1969 6:00 P.M.

NOTE: There are no encroachments on this property.
Gary E. Penfound REG. SURVEYOR NO. 4457

CITY TITLE CO. Order
No. E-901-2
David & Yvonne Muck
to Arthur Broadhurst

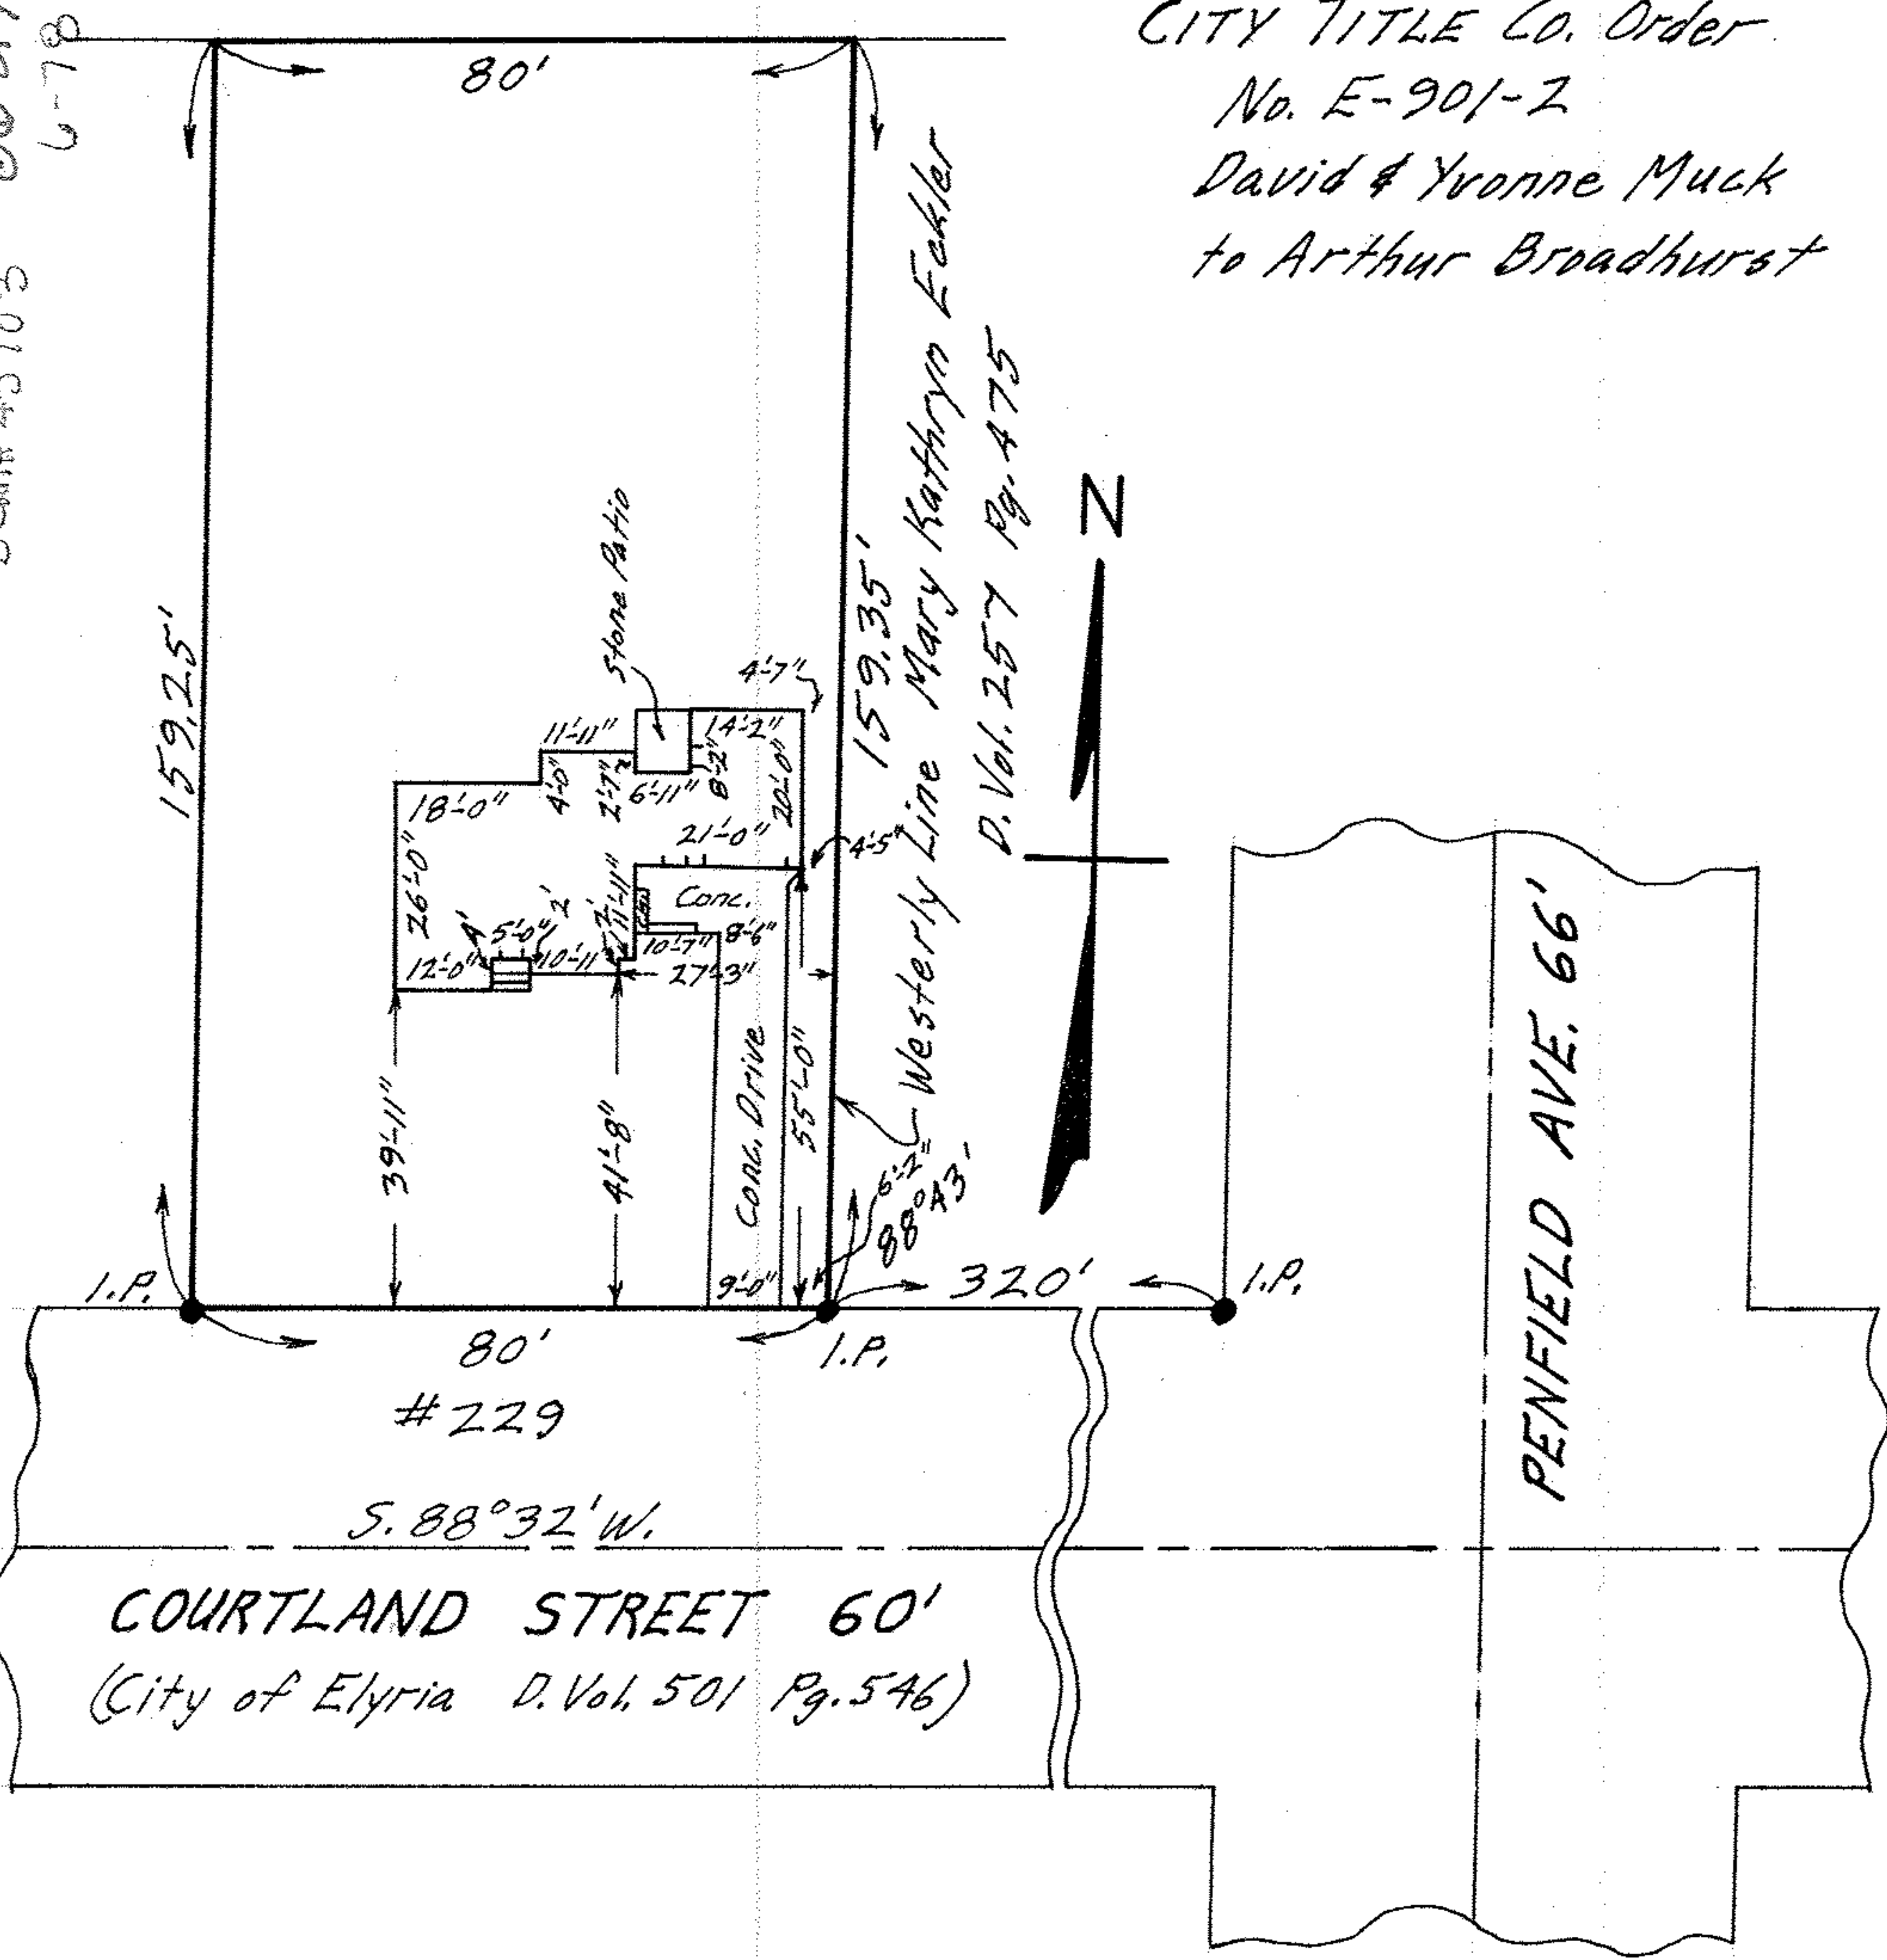

D. Vol. 257 Pg. A75