


00-24-030.09.002,003  
6-79  
Scan # 45708

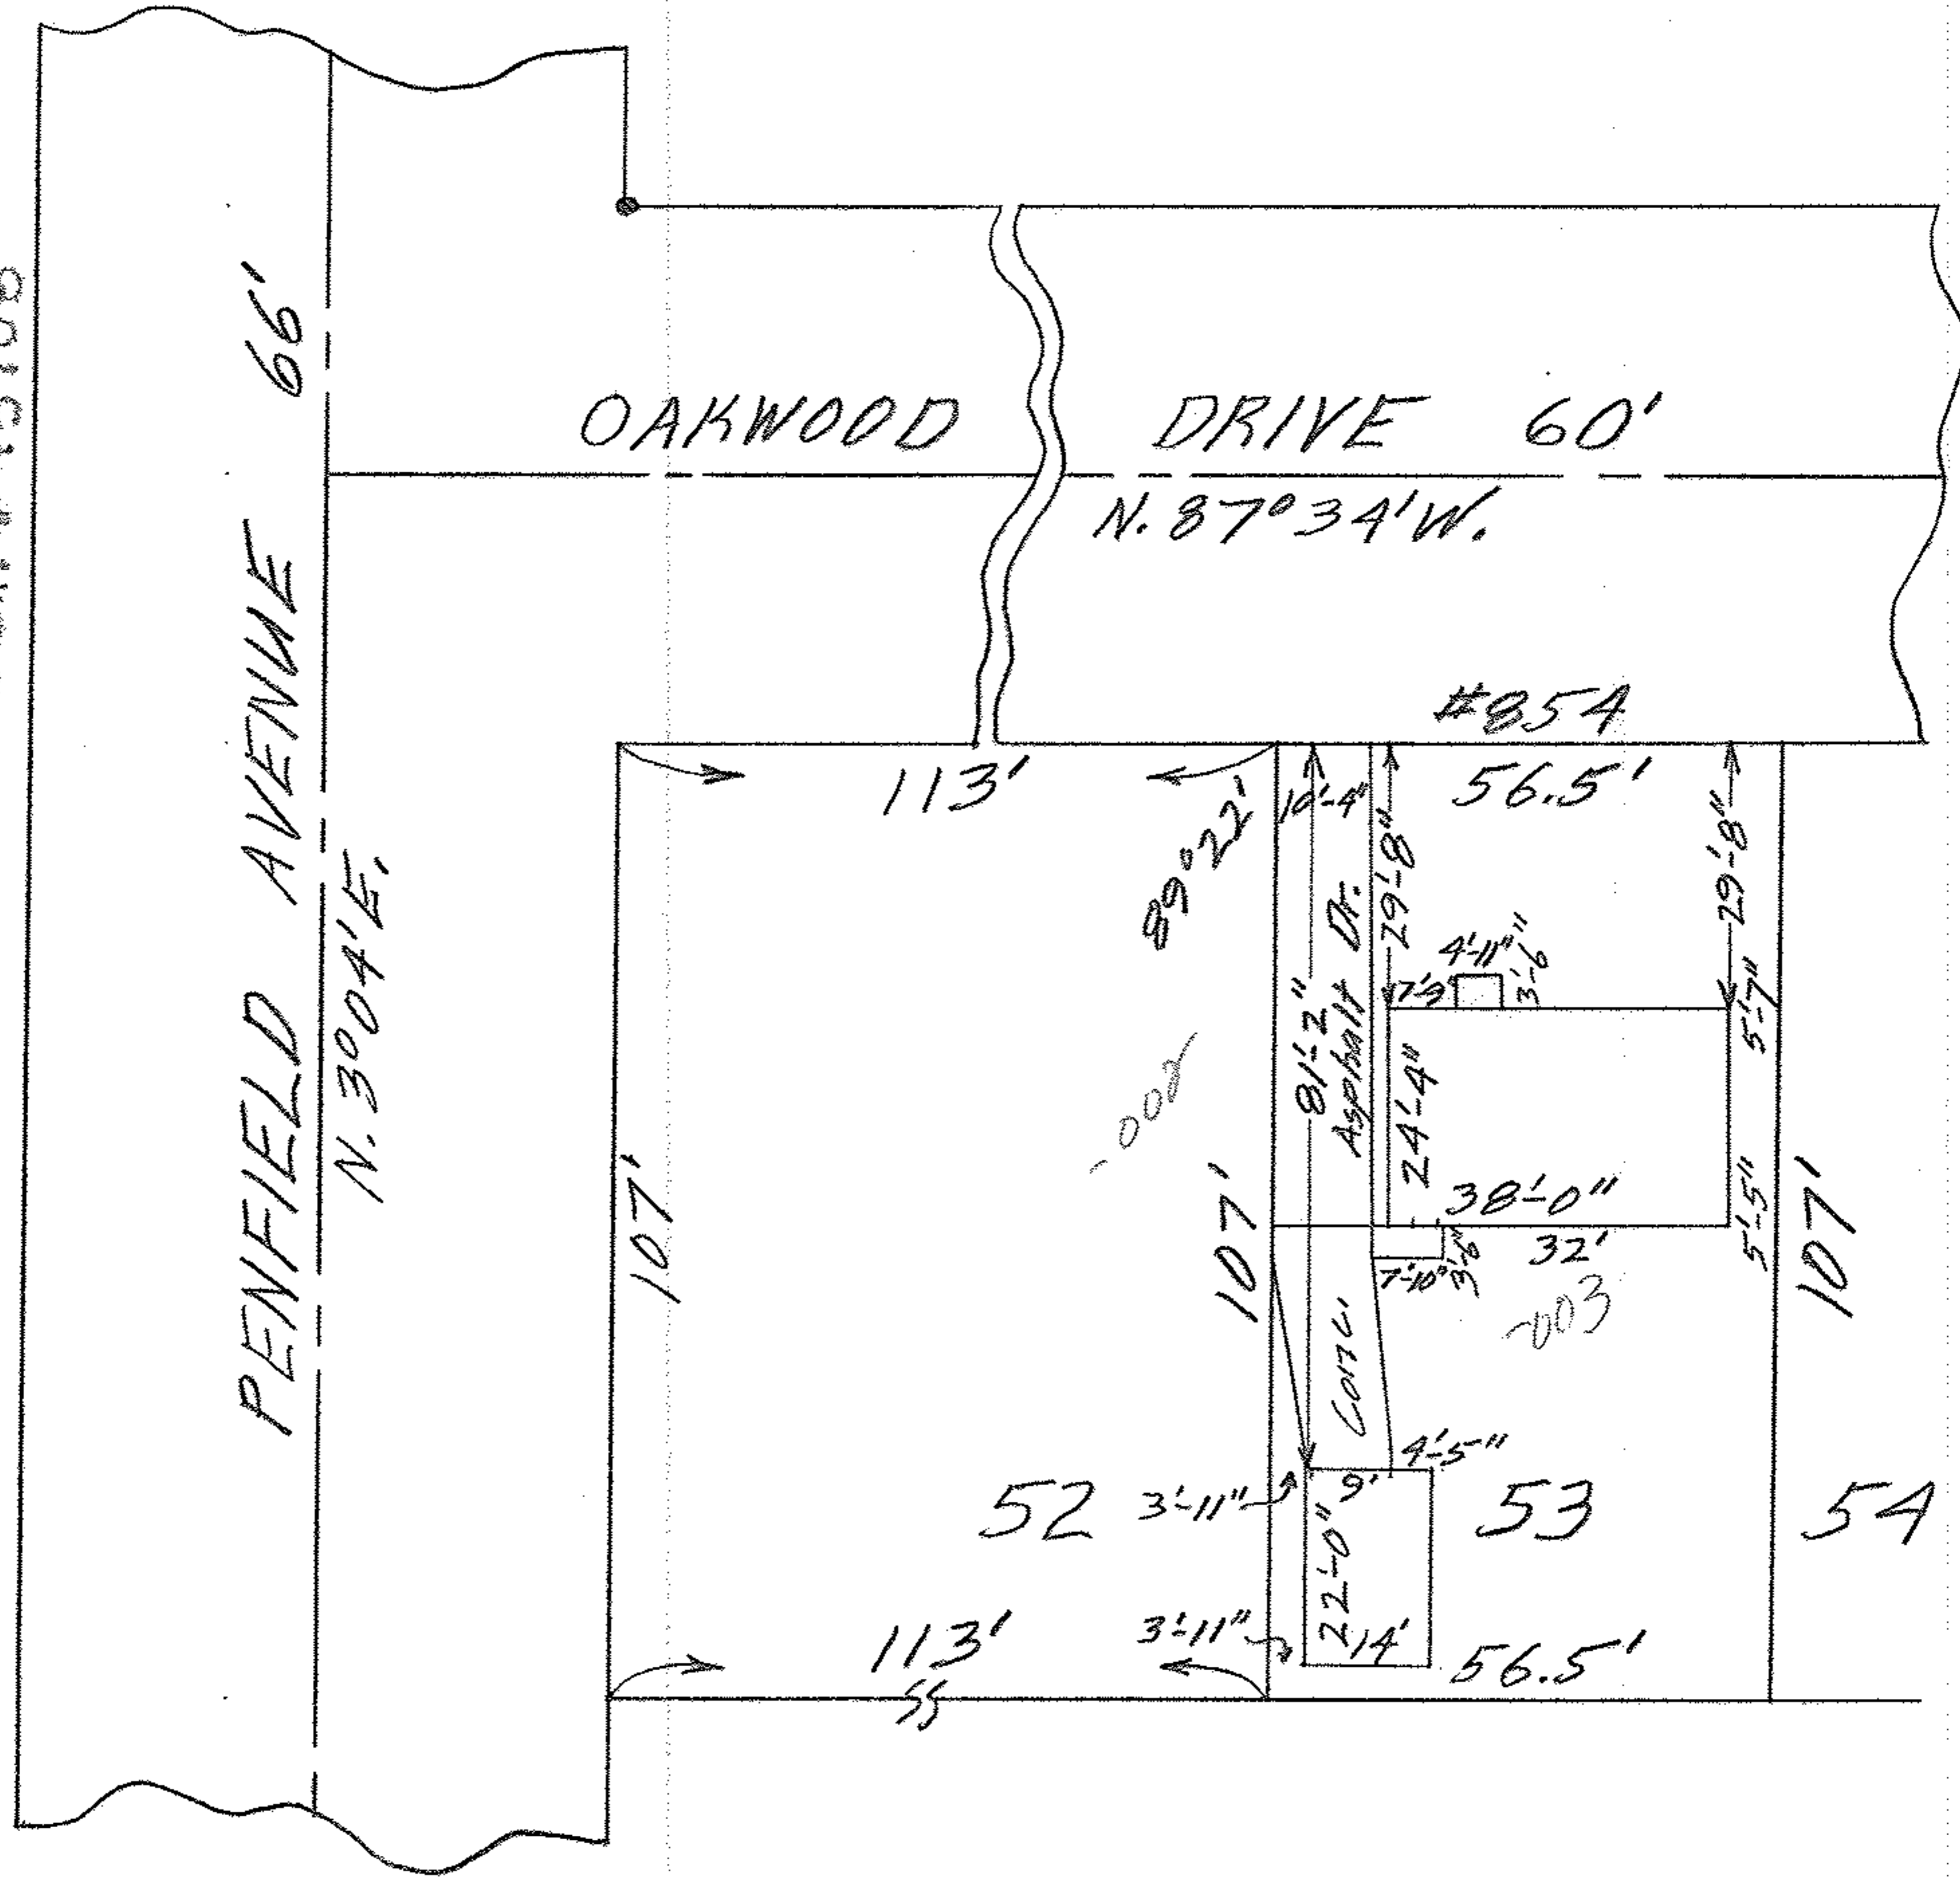

MAP OF SUB-LOT NO. 53  
 OAKWOOD PARK SUB'N. NO. 1 VOL. 17 PG. 44  
 O. L. 26 - WEST OF RIVER - ELYRIA TWP.  
 ELYRIA CITY - LORAIN COUNTY - OHIO  
 SCALE: 1" = 30' JAN. 6 - 1964 2:15 P.M.  
 Gary E. Penfound REG. SURVEYOR

H & R Builders, Inc.

WW

000,000,000,000