


06-24-036.109.004,005
6-79
Scan # 45709

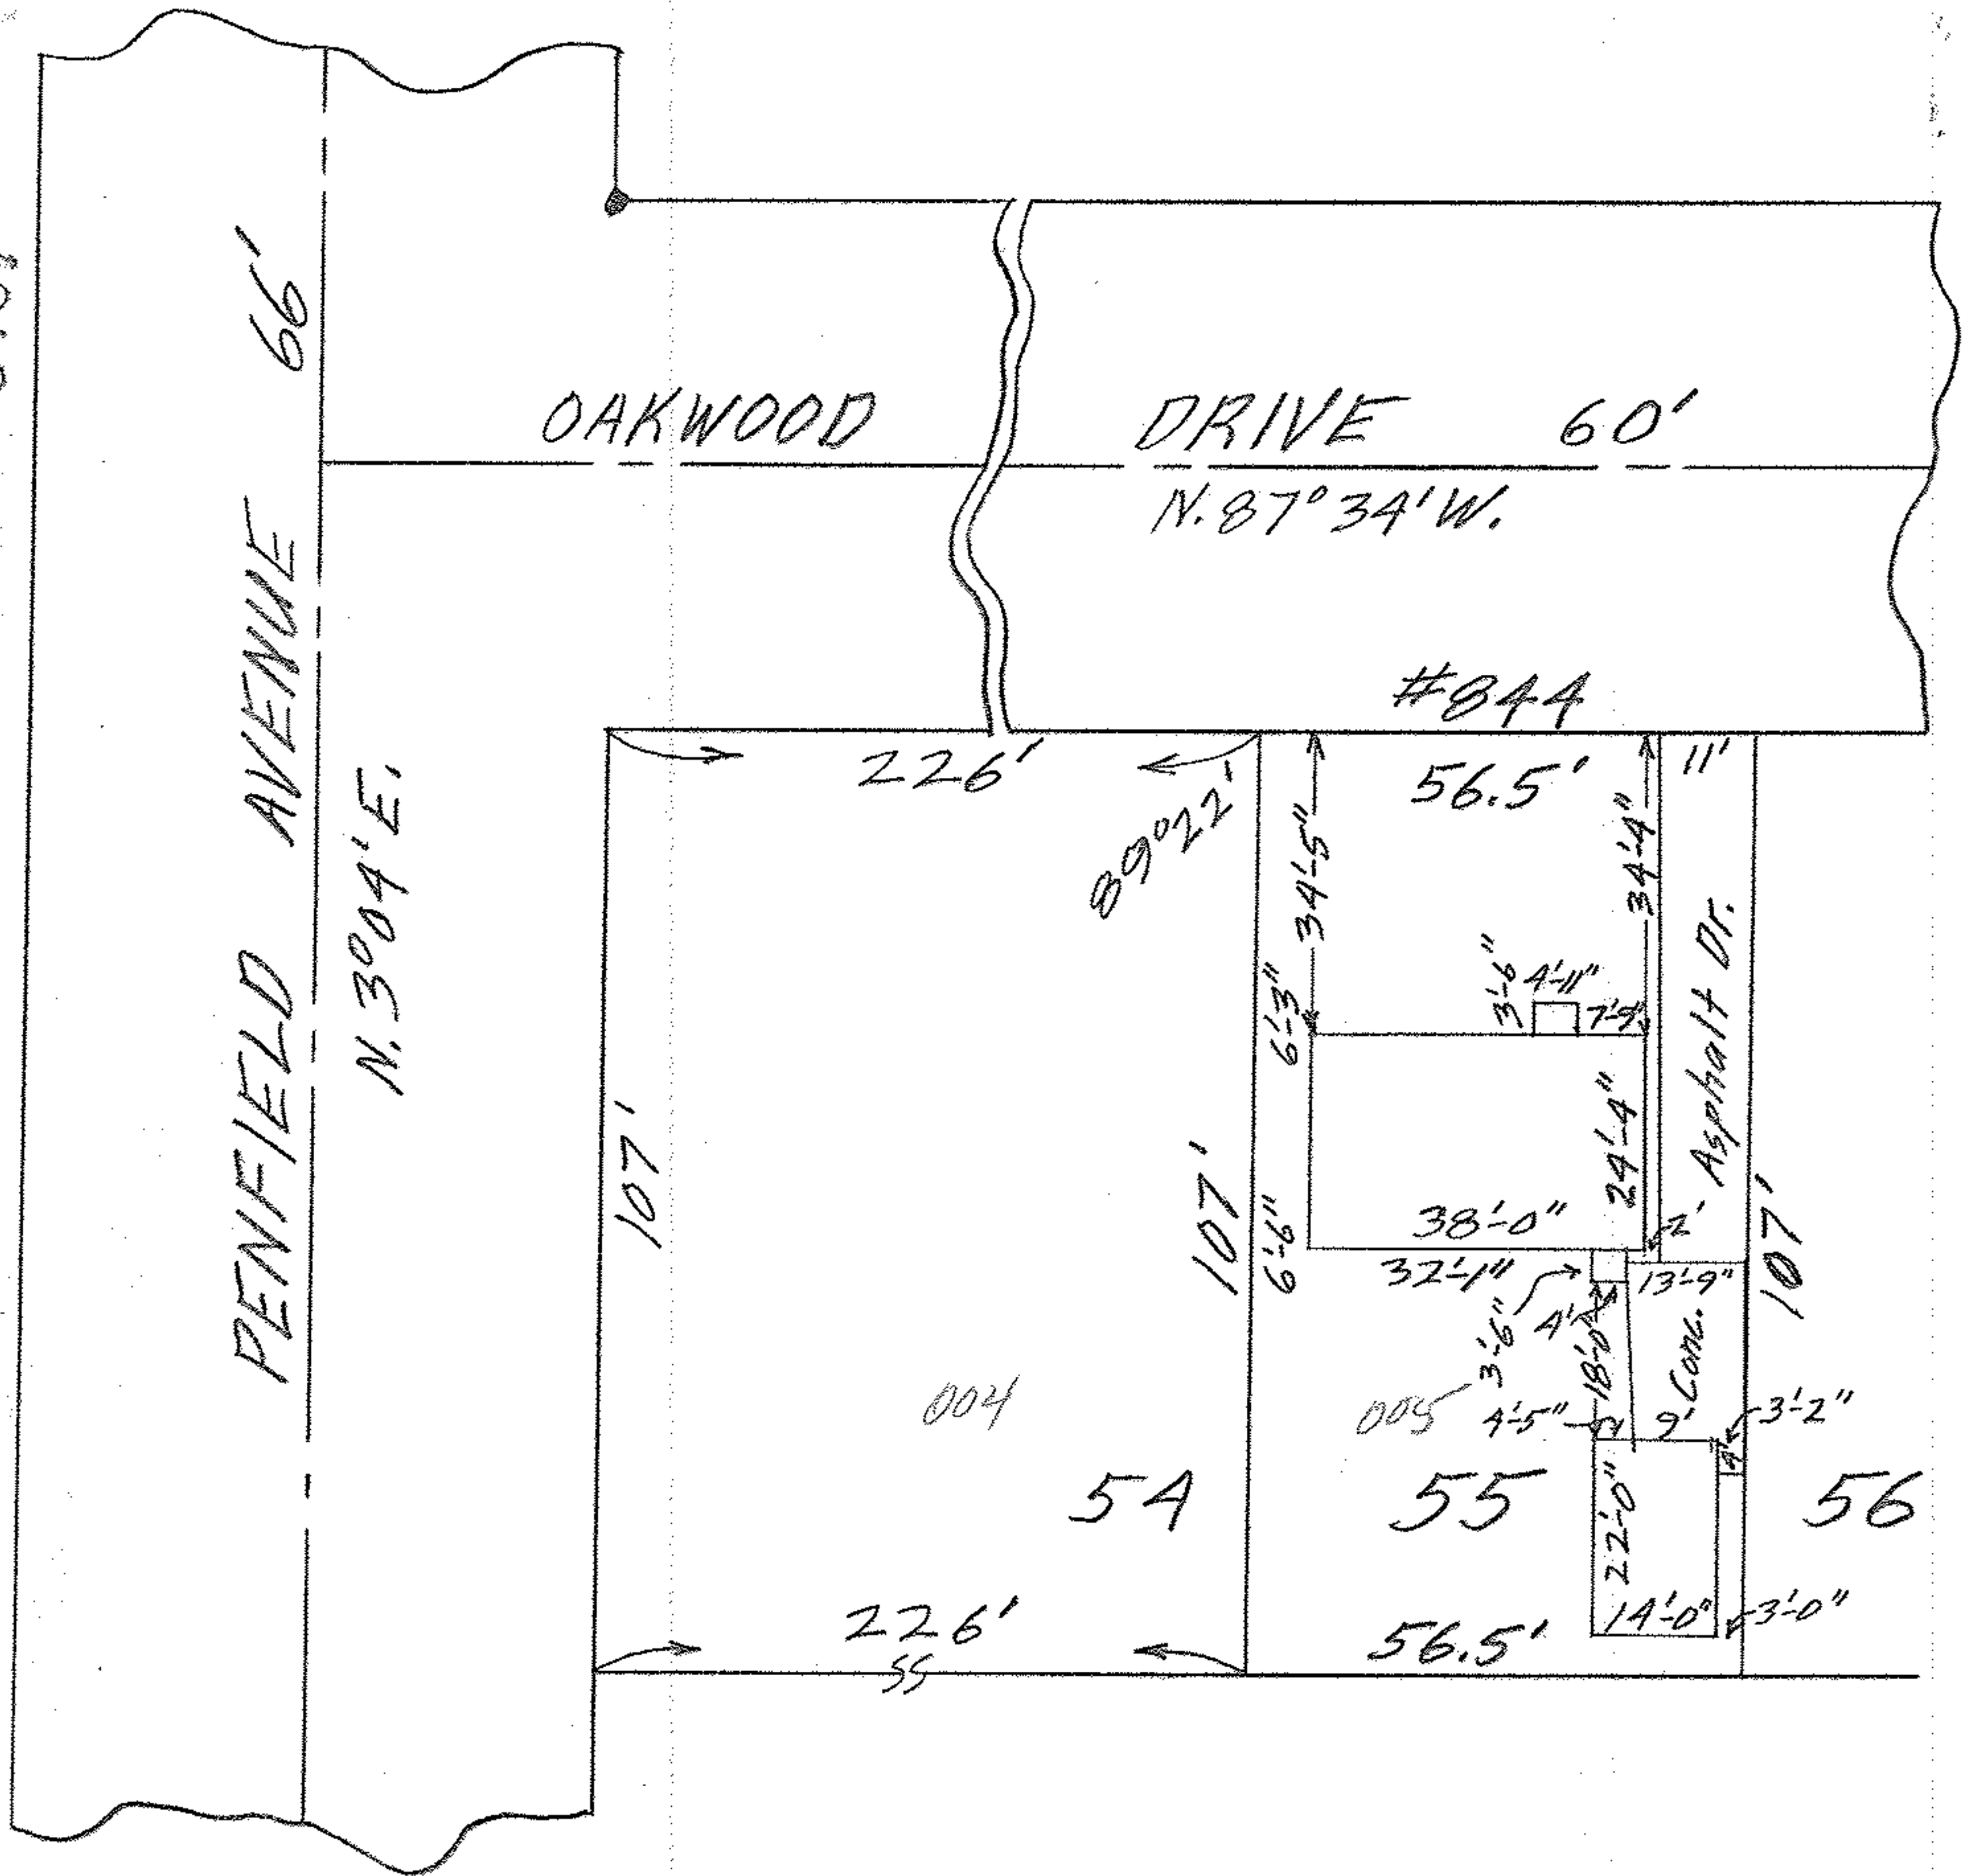

MAP OF SUB-LOT NO. 55
 OAKWOOD PARK SUB'D. NO. 1 Vol. 17 Pg. AA
 O.L. 26 - WEST OF RIVER - ELYRIA TWP.
 ELYRIA CITY - LORAIN COUNTY - OHIO
 SCALE: 1" = 30' MAY 25 - 1964 6:00 P.M.
 Gary E. Penfound REG. SURVEYOR

Carl W. Sutphin

1204 901 050 148 09

WW