


06-24-028-106-004

SCAN # 45722

28-9

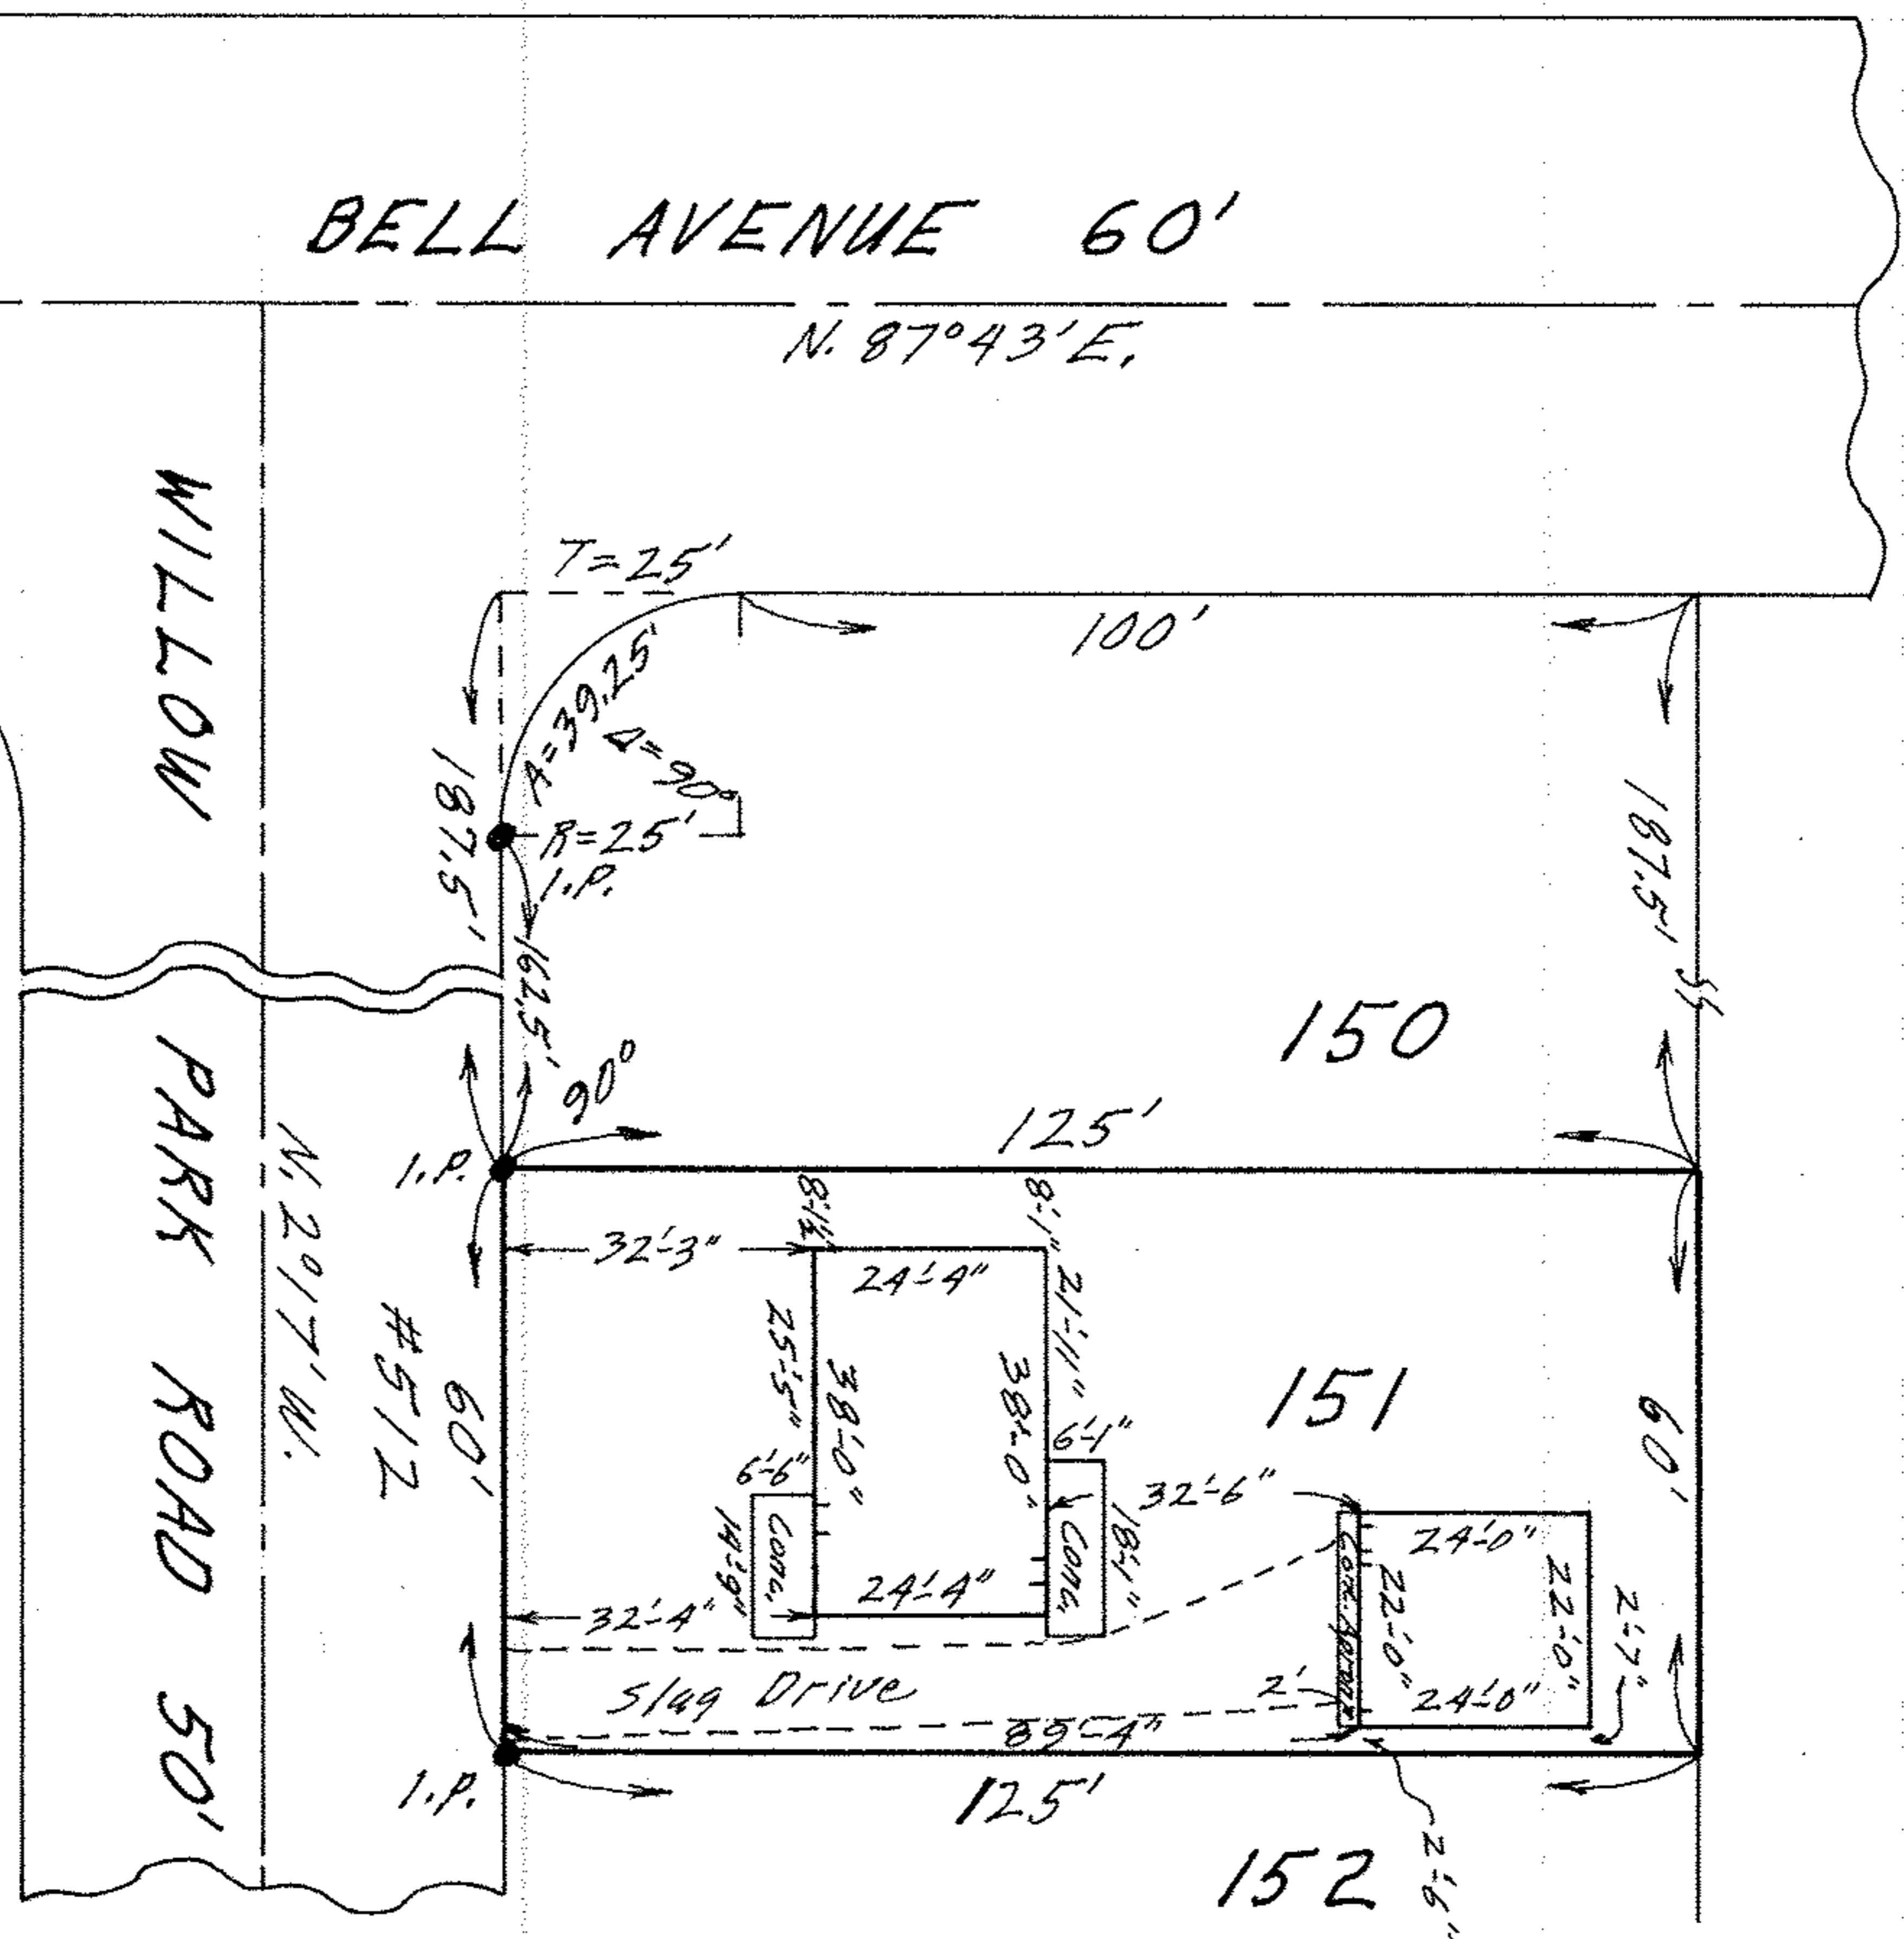

MAP OF SUB-LOT NO. 151

CASCADE COLONY SUB'N. RESUBDIVIDED VOL. 18 P. 15  
ORIG. LOT 28 - WEST OF BLACK RIVER - ELYRIA TWP.  
ELYRIA CITY LORAIN COUNTY OHIO

SCALE: 1" = 30' SEPT. 24-1970 7:00 P.M.

NOTE: There are no encroachments on this property.  
Gary E. Penfound REG. SURVEYOR NO. 4457

CITY TITLE Co. Order No. E-1316-7  
Drage to Wahl