


06-24-028-108-039
6-83 SCAN # 45723

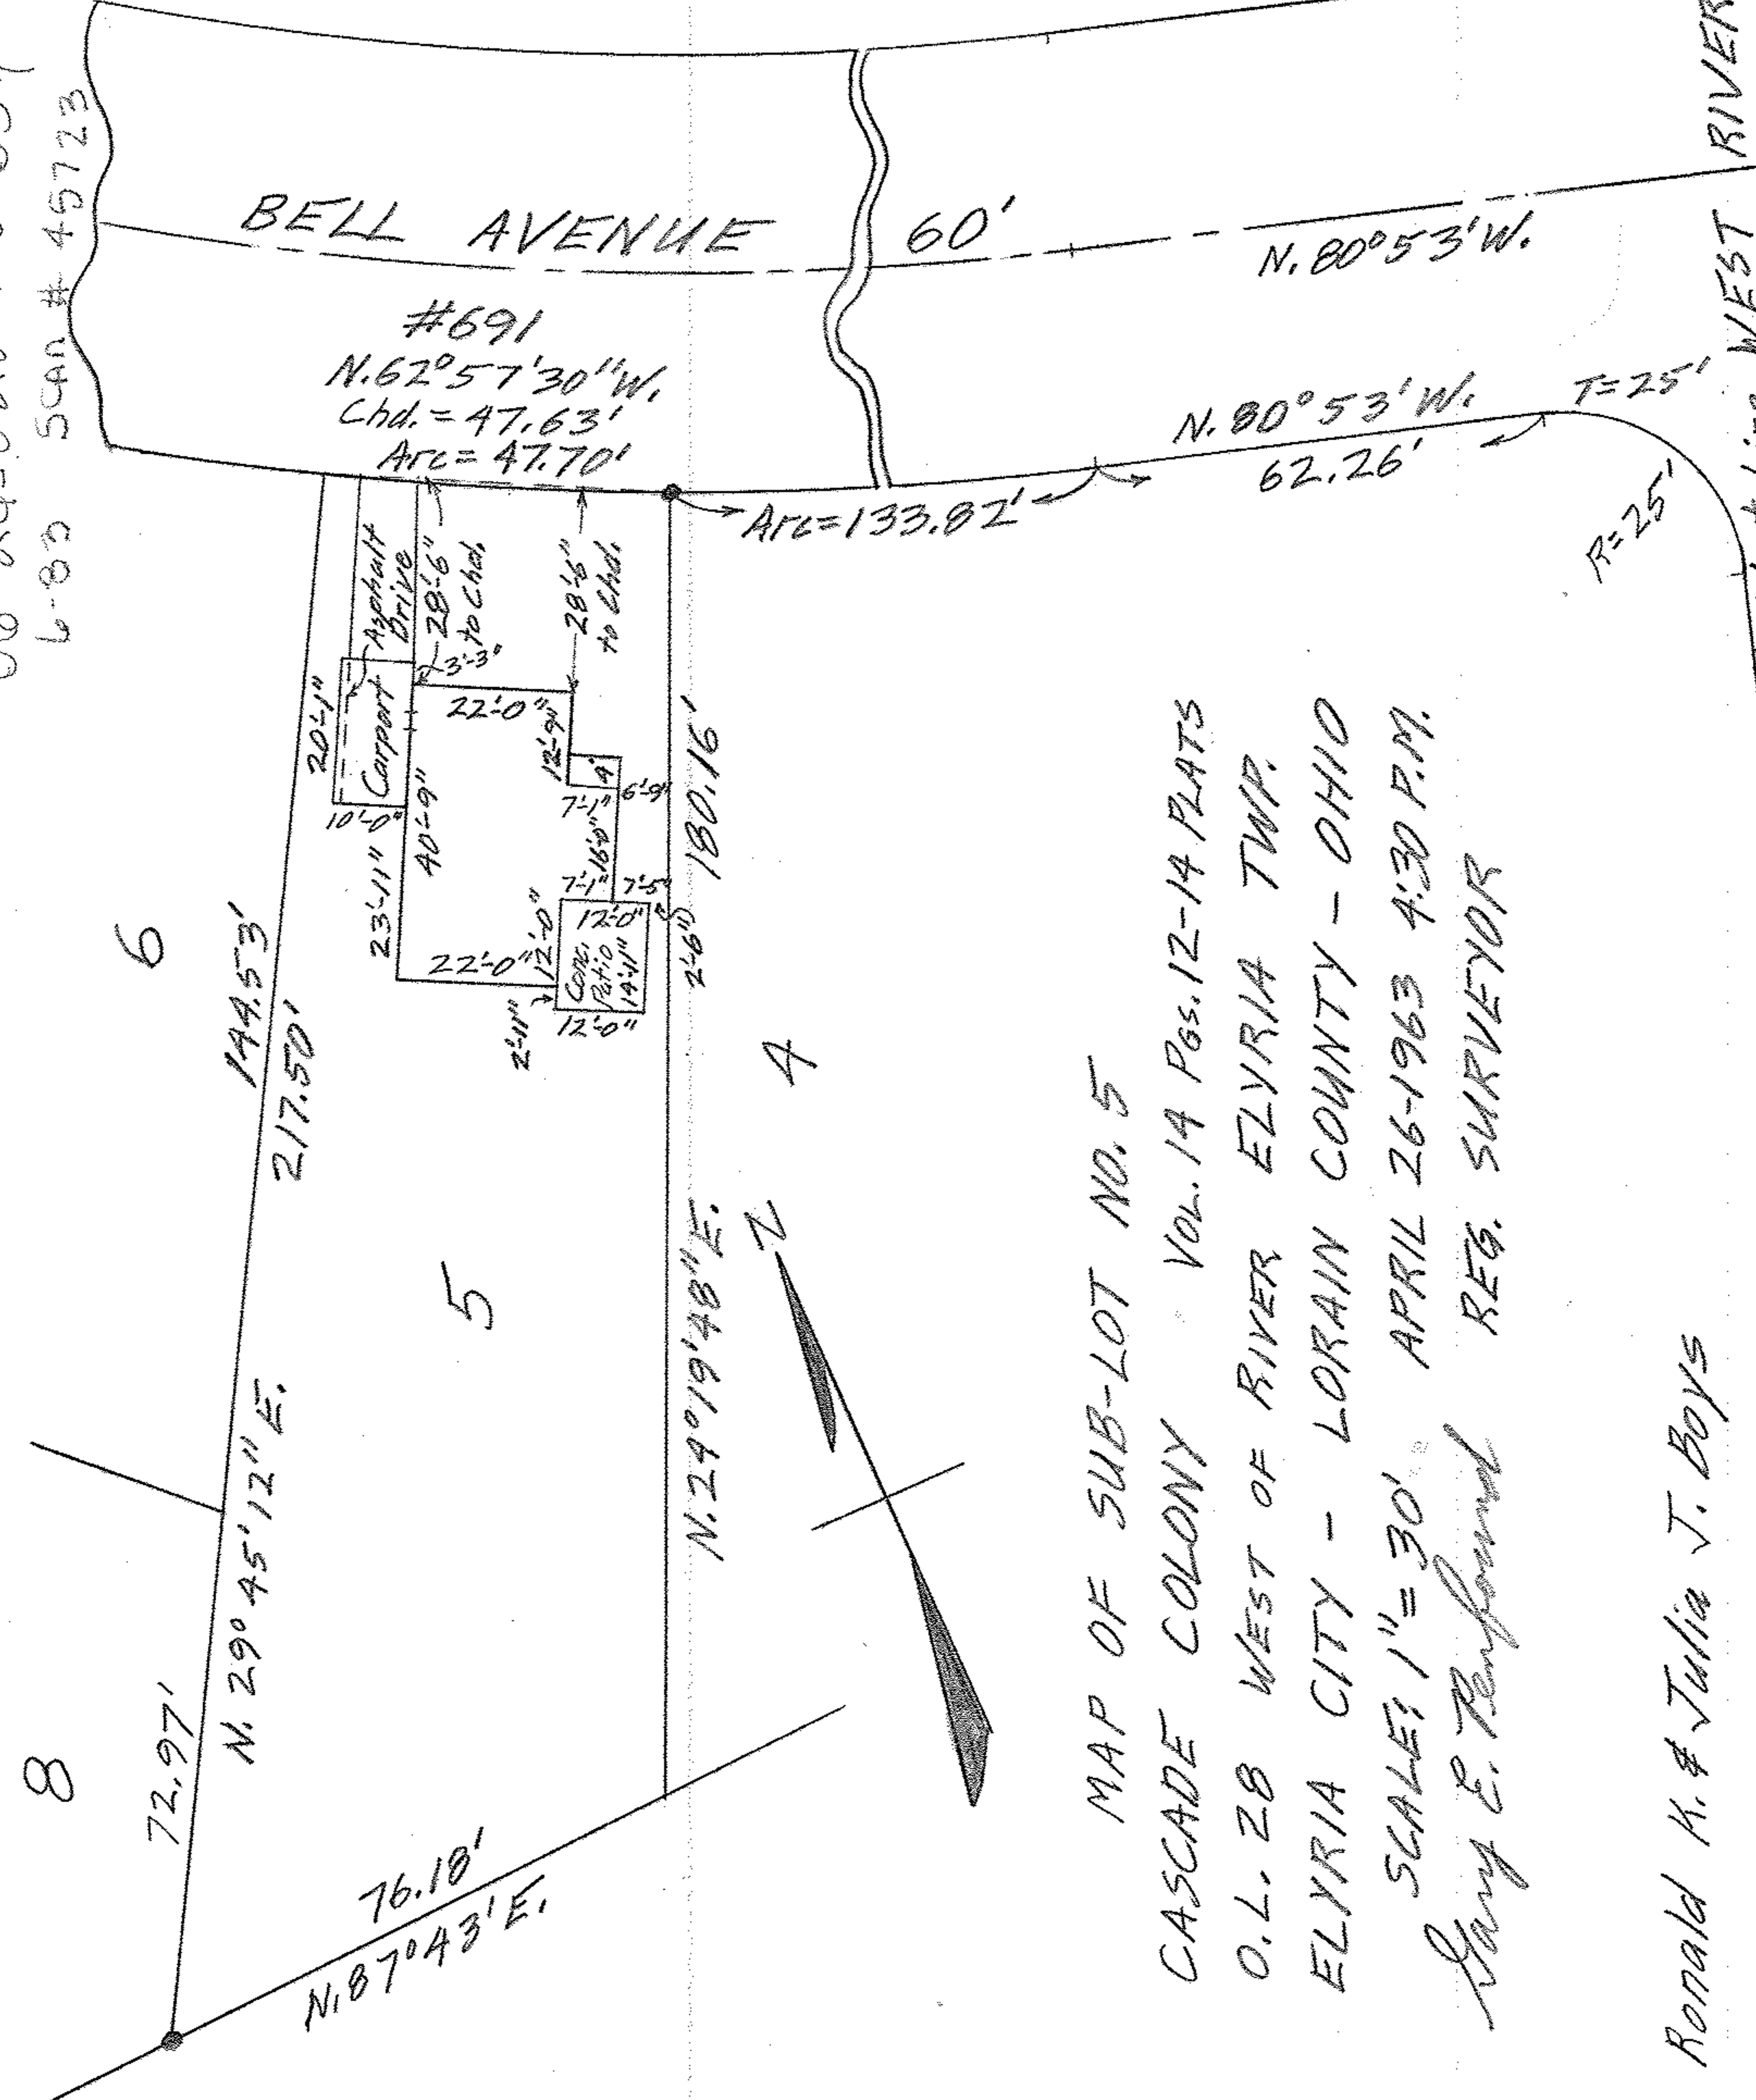

MAP OF SUB-LOT NO. 5
 CASCADE COLONY VOL. 14 PGS. 12-14 PLATS
 O.L. 28 WEST OF RIVER ELYRIA TWP.
 ELYRIA CITY - LORAIN COUNTY - OHIO
 SCALE: 1" = 30' APRIL 26-1963 4:30 P.M.
 Gary E. Penfound REG. SURVEYOR

Ronald H. & Julia J. Boys