


06-74-028-108.044 6-83  
 Scan # 45724

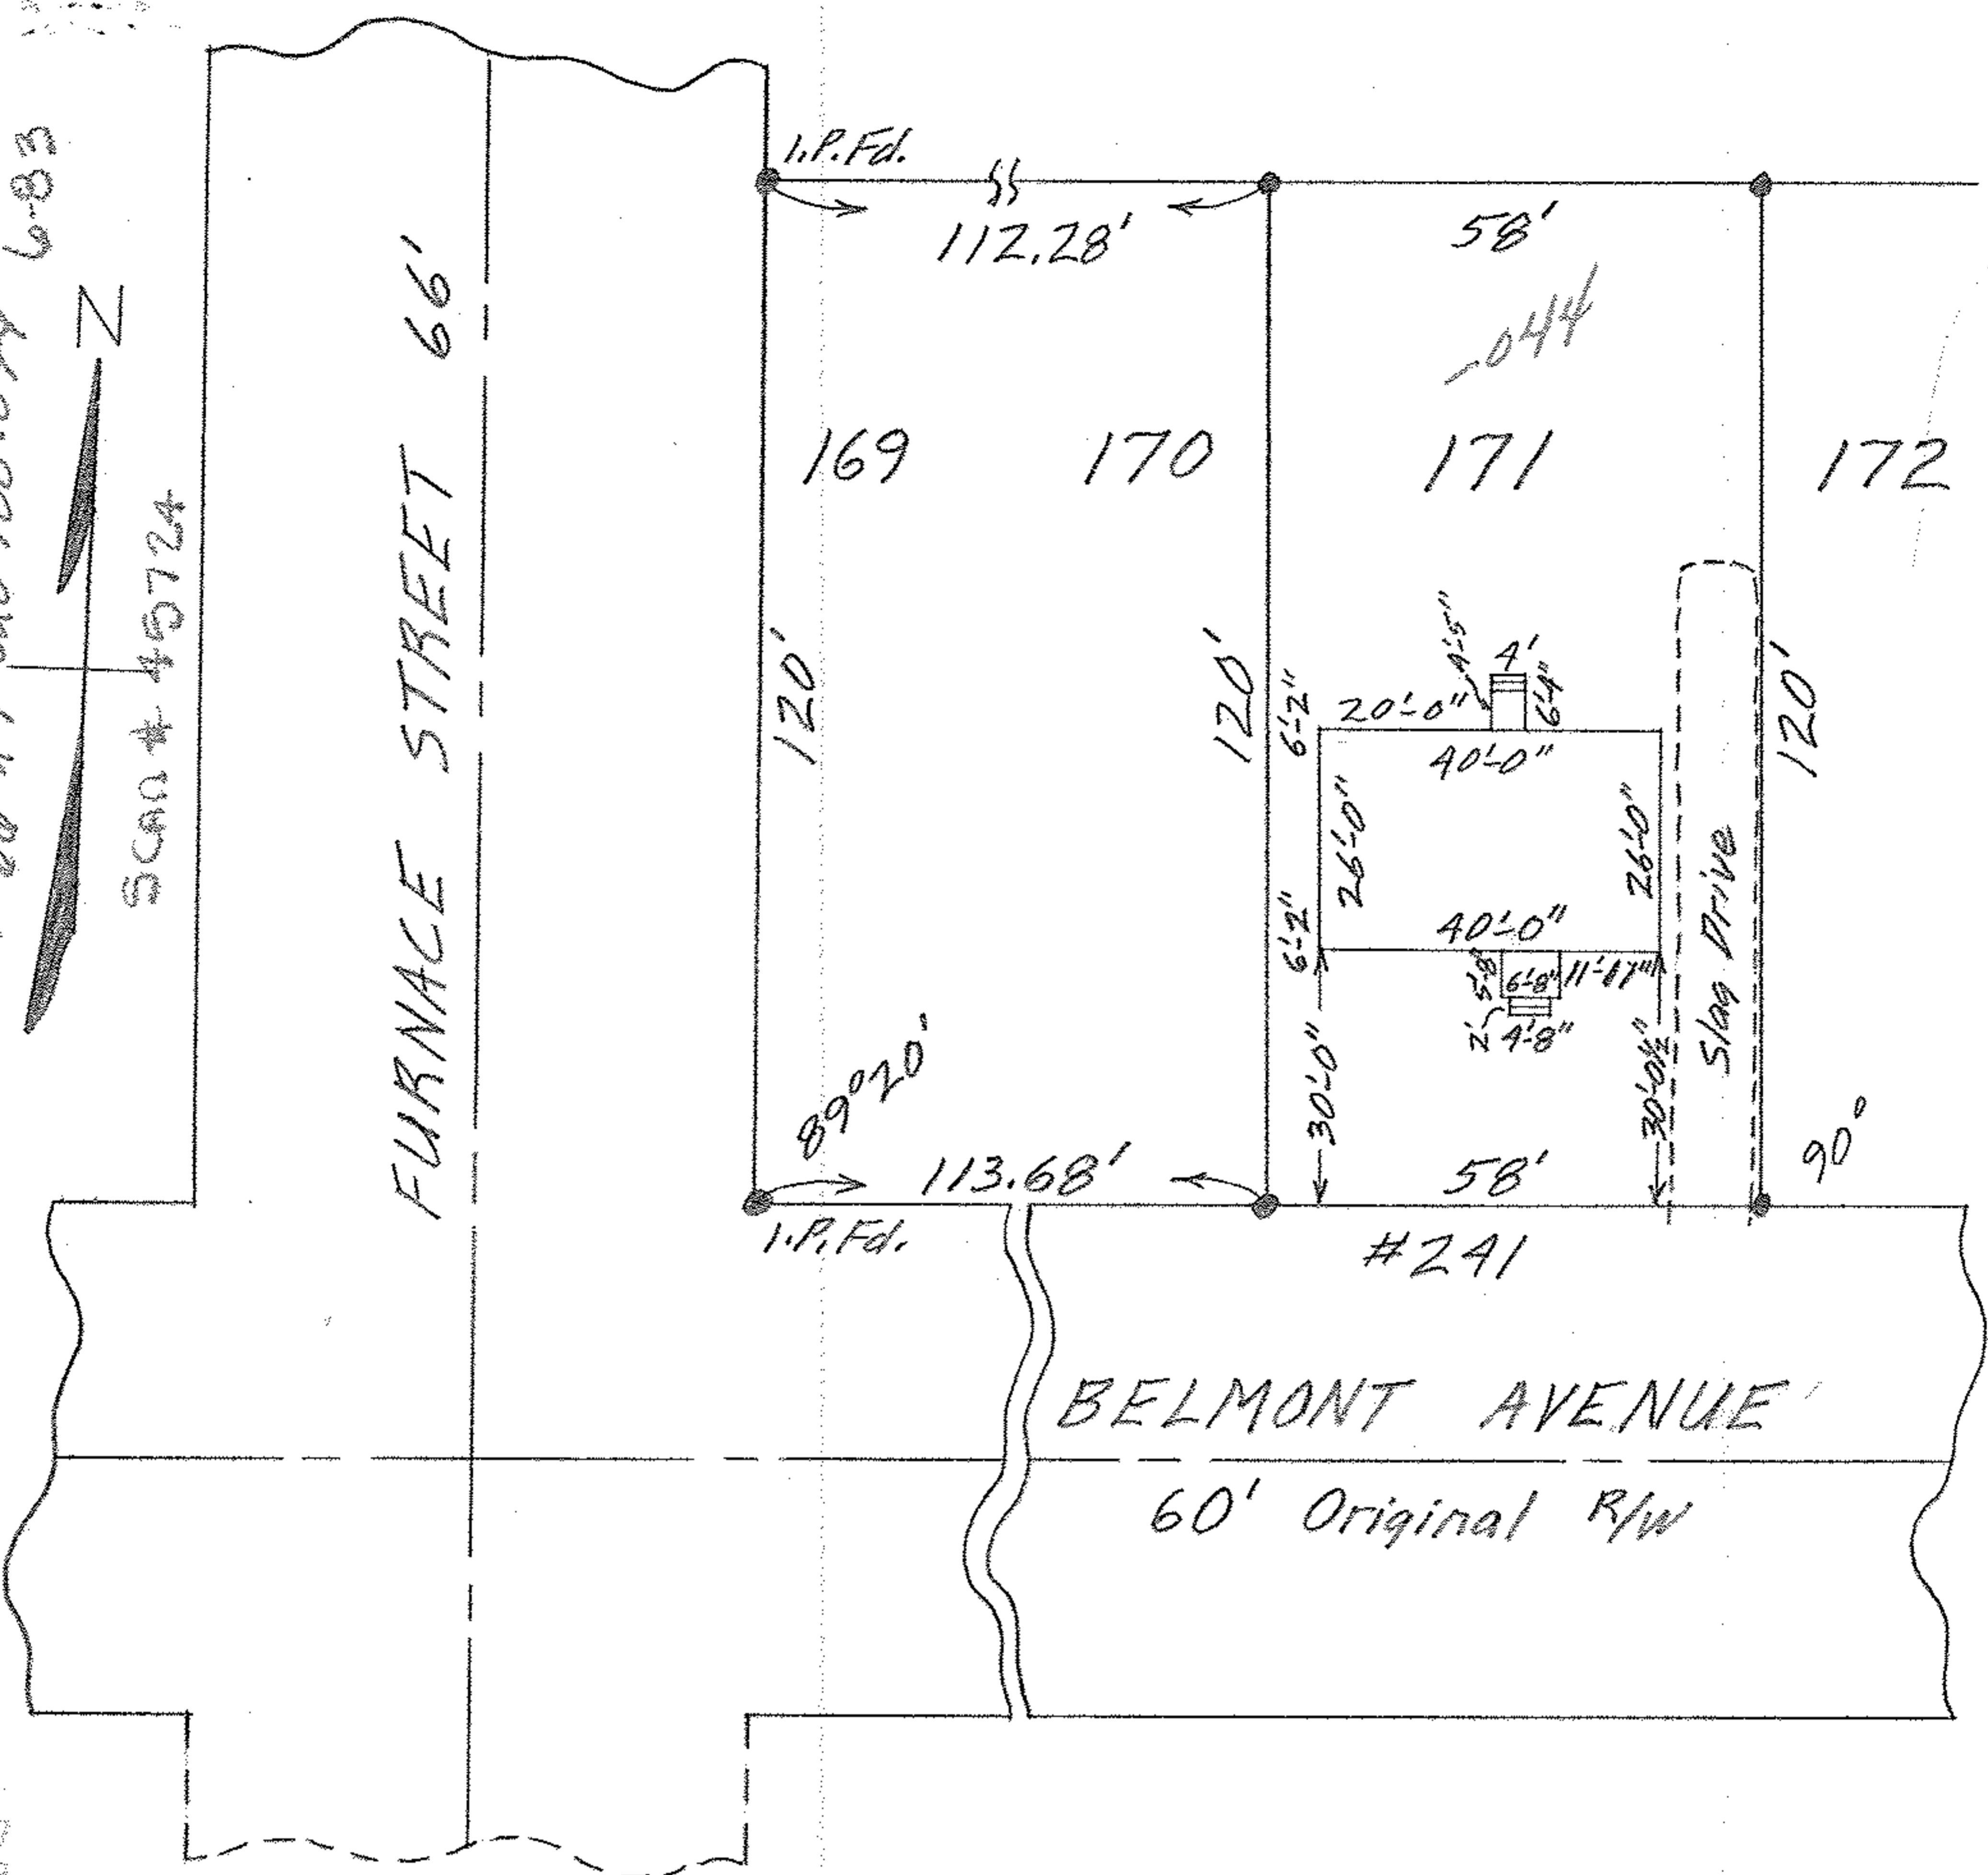

MAP OF SURVEY OF SUB-LOT NO. 171  
 CLOVERDALE ALL'T. Vol. 6 Pgs. 29 & 30 PLATS  
 ELYRIA TOWNSHIP ELYRIA CITY  
 LORAIN COUNTY OHIO  
 SCALE: 1" = 30' NOV. 17-1964 5:15 P.M.  
 Gary E. Penfound REG. SURVEYOR NO. 4457

NOTE: ● indicates iron pin  
 found or set.

P.O. Raymond E. & Frances Zacharias

06-74-028-108.044 6-83