


06-24-029. 104.007, 008  
 6-21-03 SCAN # 45729

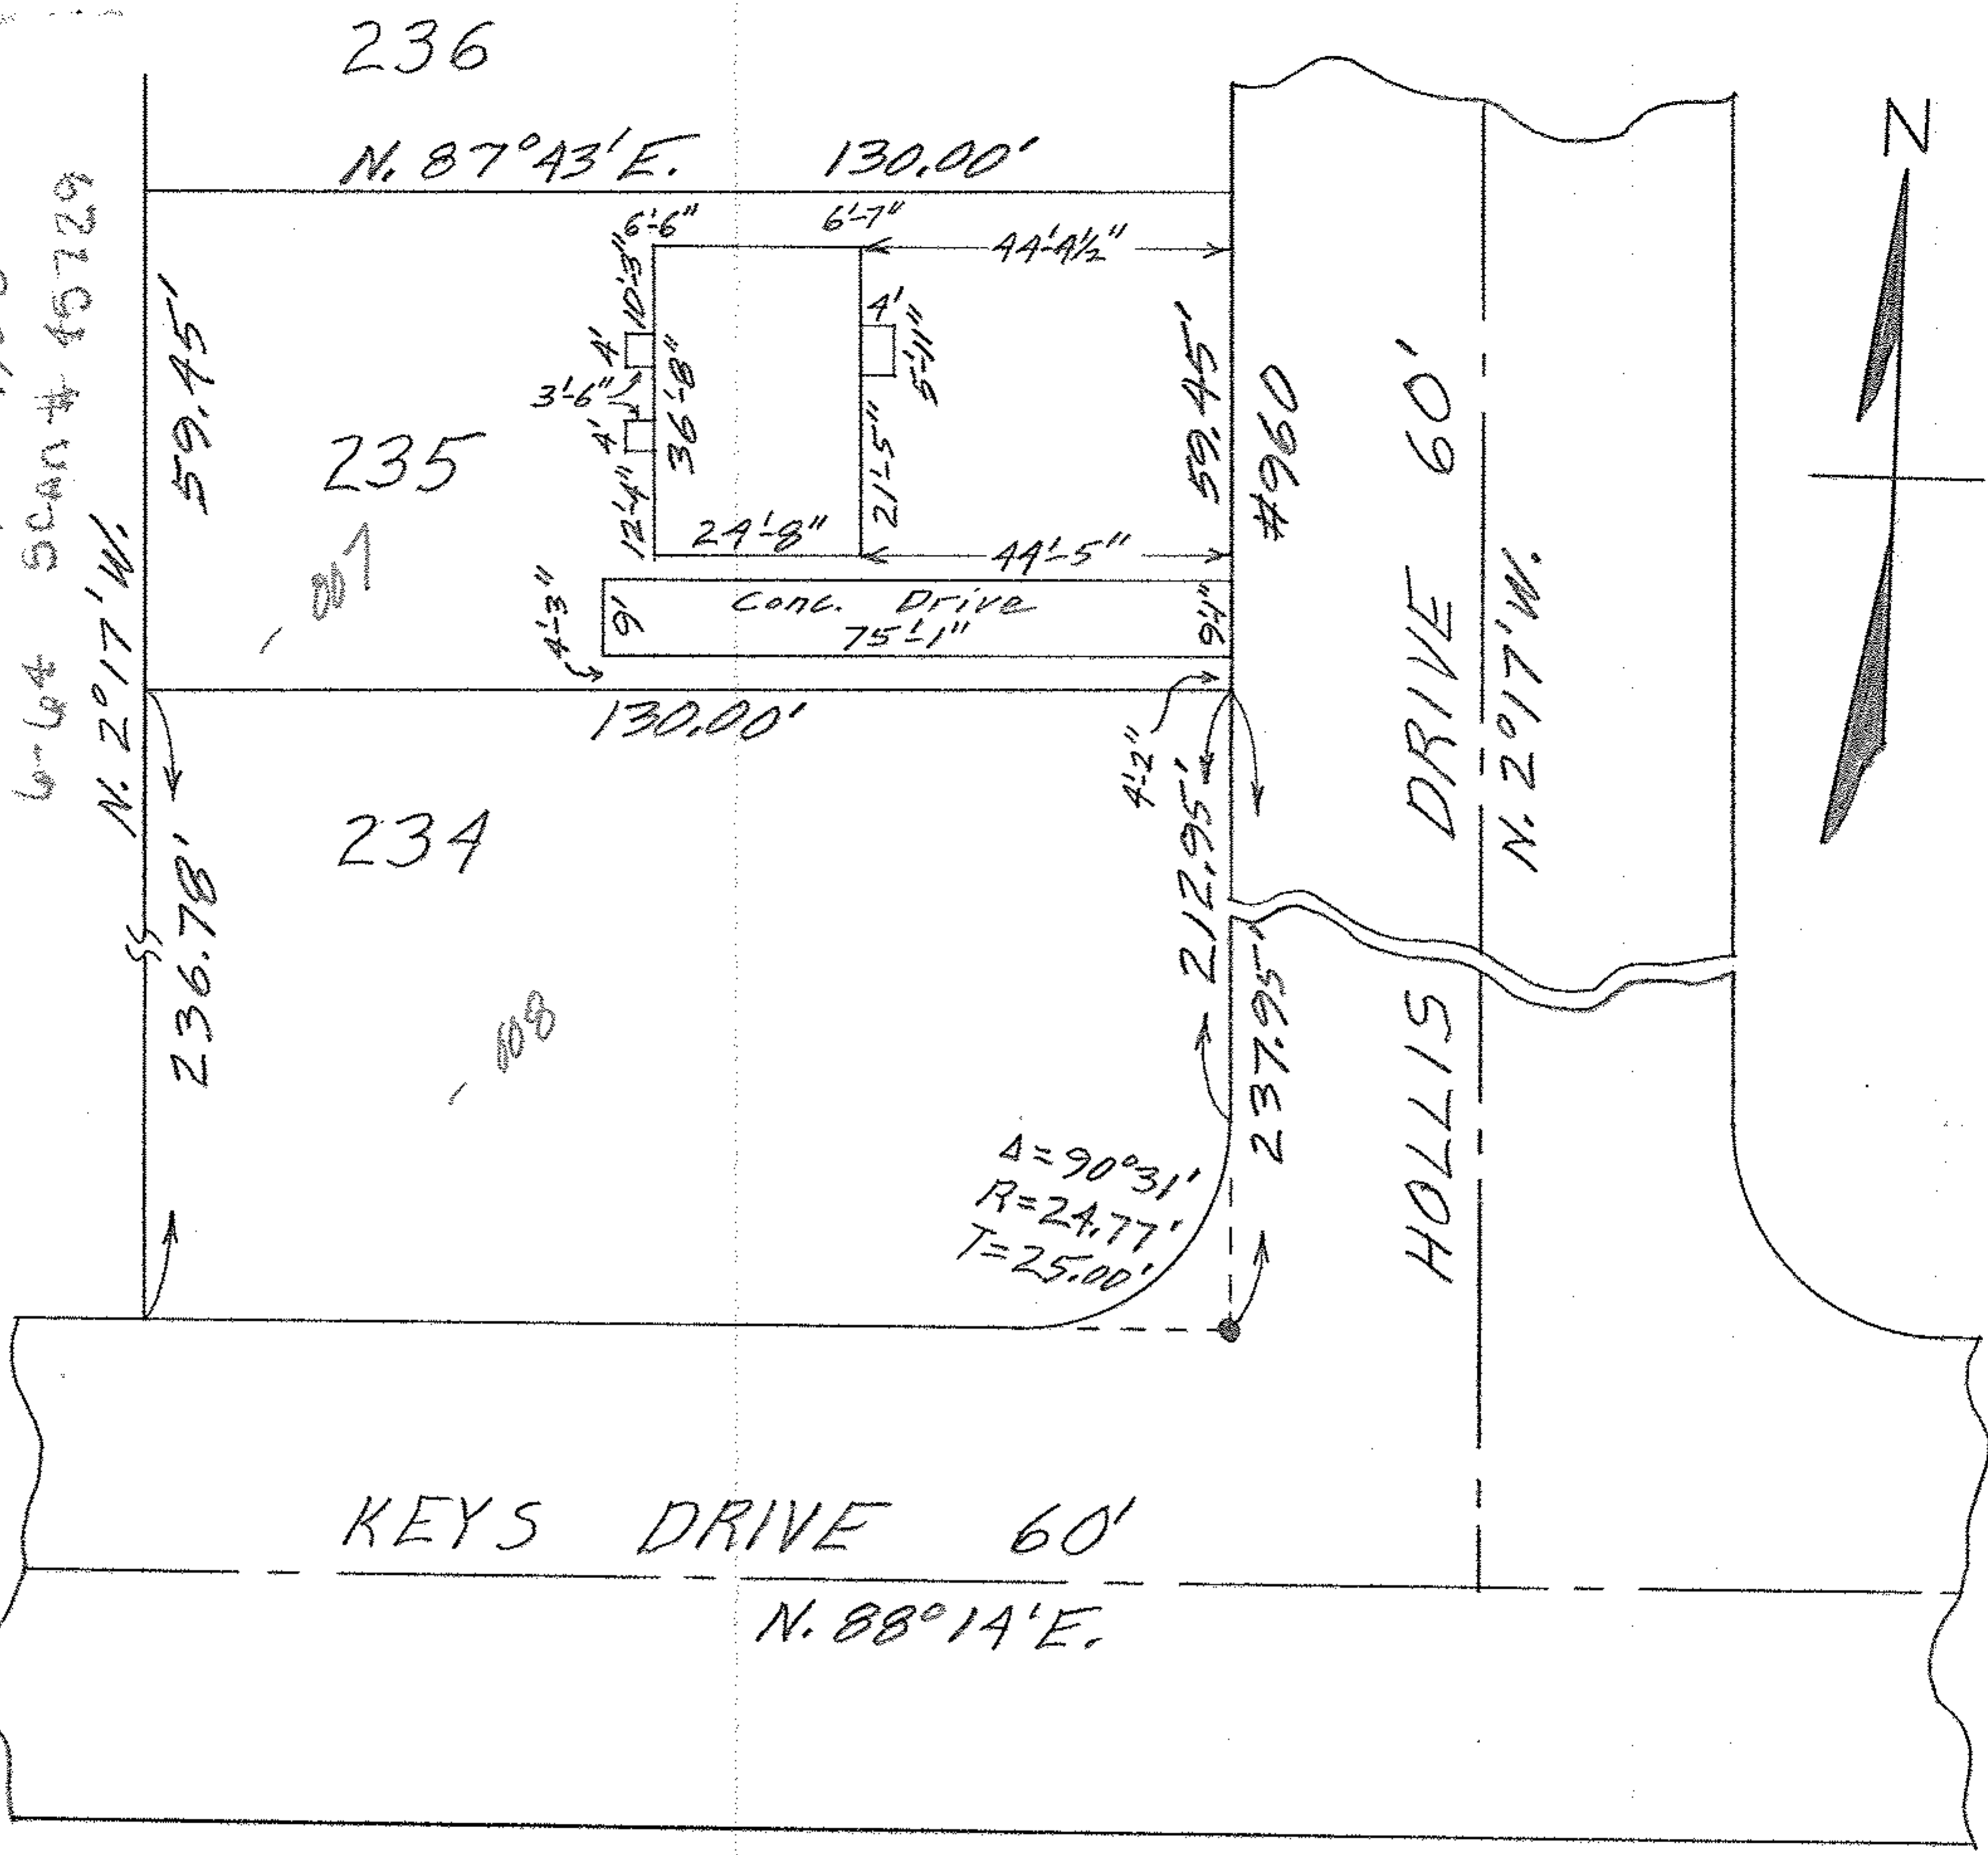

06-24-029. 104.007, 008  
 6-21-03 SCAN # 45729

MAP OF SUB-LOT NO. 235  
 CASCADE COLONY SUB'D. NO. 4 VOL. 22 PG. 21  
 ORIG. LOT 29 WEST OF RIVER ELYRIA TWP.  
 ELYRIA CITY LORAIN COUNTY OHIO  
 SCALE: 1"=30' MAY 2-1964 2:00 P.M.  
 Gary E. Penfound REG. SURVEYOR

Richard A. & Breanna S. Adams