


Db. 24.029.104.006,007
 6-64 SCAN # 45737

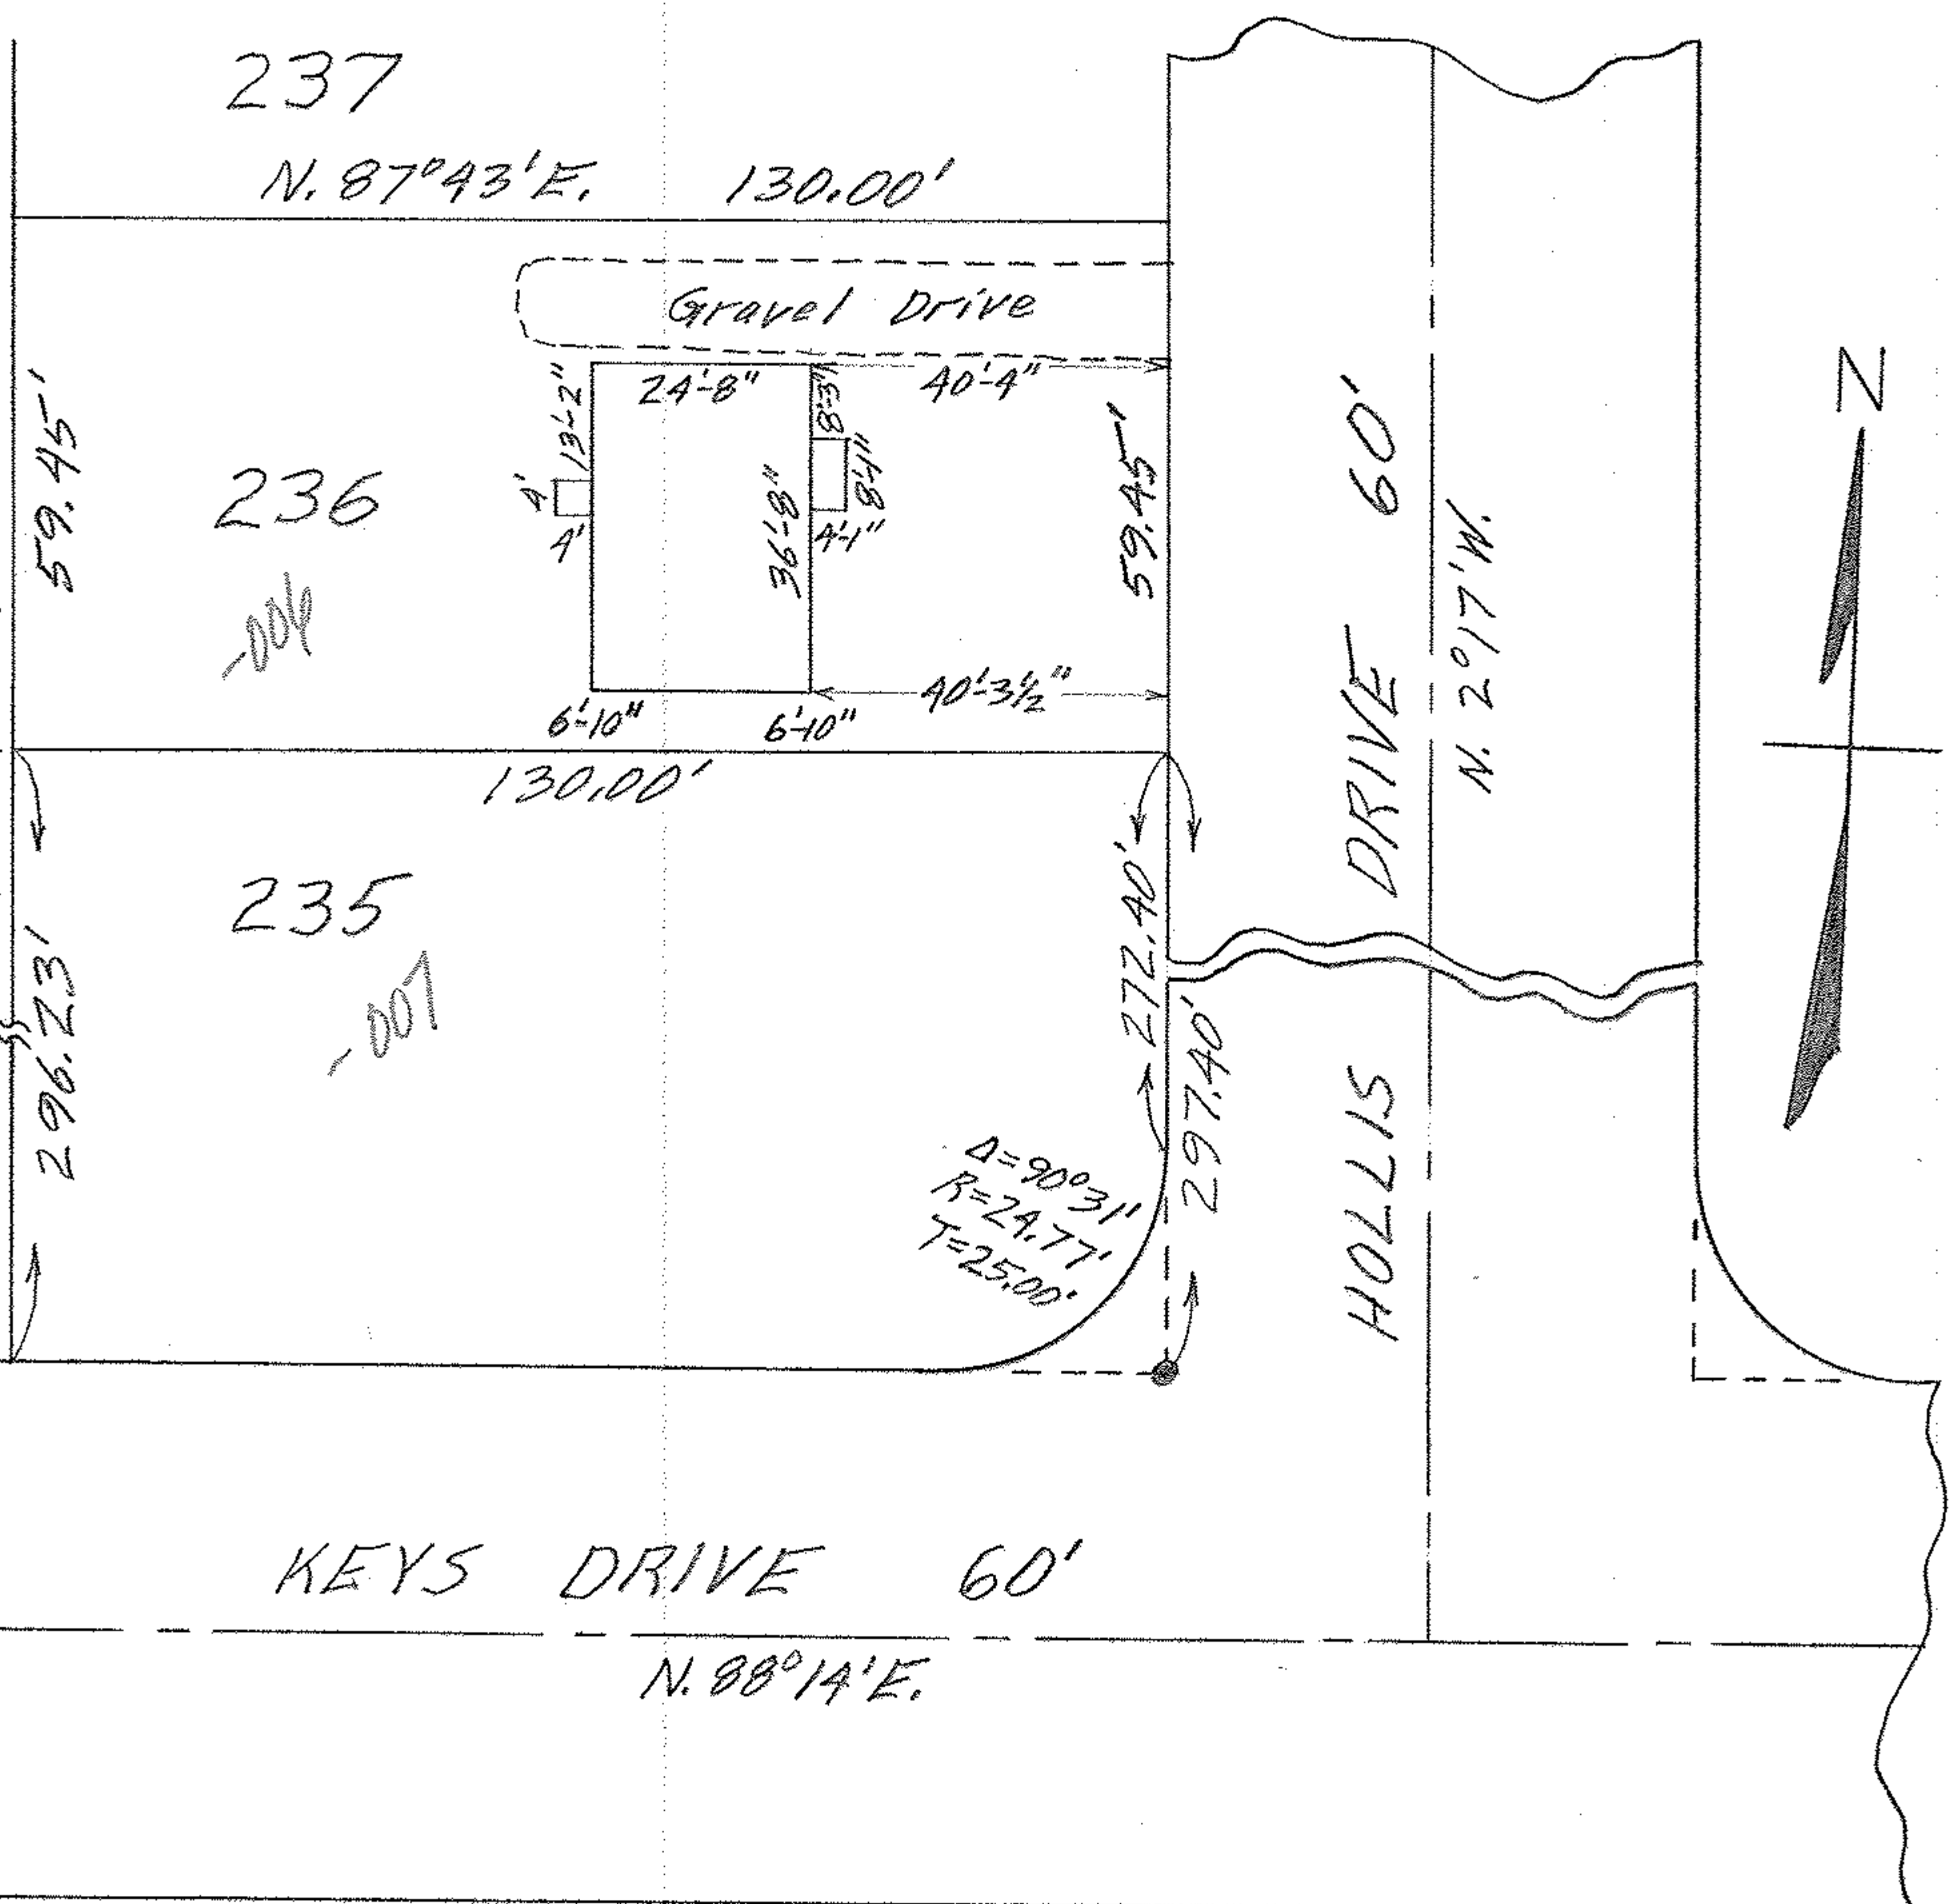

Map of Sub-Lot No. 236

MAP OF SUB-LOT NO. 236

CASCADE COLONY SUB'D. NO. 4 VOL. 22 PG. 21
 ORIG. LOT 29 WEST OF RIVER ELYRIA TWP.
 ELYRIA CITY LORAIN COUNTY OHIO

SCALE: 1"=30' APRIL 20-1963 4:15 P.M.

Gary E. Penfound REG. SURVEYOR

Robert A. & Faith A. Burkel