

06-24-036.105-050-051-004  
6-60 SCAN # 45748


EMERSON COURT 50 FT.

500.0' Rec. & Meas.

N-89°-09'-W. 60.0'

60.0'

S-71°-09'-W 131.33'

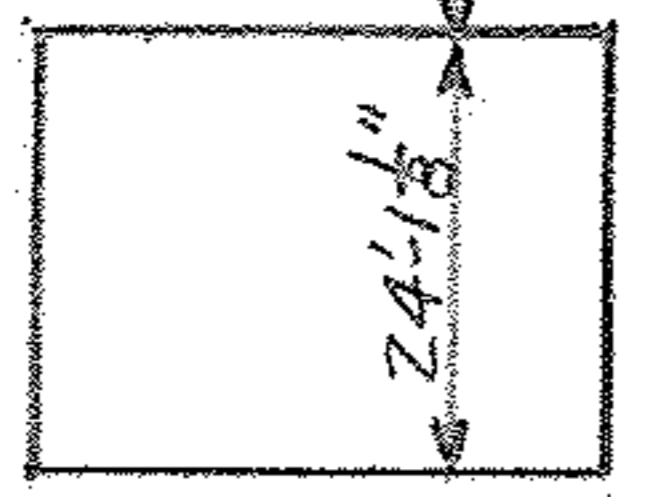

14'-0" 32'-1 1/2" 13'-10 1/2"

N-71°-09'-E. 131.33'

Winifred E. Kessler  
D.S.O. NO. 158

Anna Yourk-vitch  
D.VOL. 448 PG. 466 AUG 23-194

N-1°-09'-E. 131.33'  
Joseph & Macel Rehm

ROBERT ST. 66 FT.

S-89°-02'-E. 60.0'

60.0'

Ella Baker  
D.VOL. 137 PG. 130 April 3-1915

MAP OF SURVEY FOR  
THE H. MEISTER CO. & Winifred E. Kessler  
ELYRIA TOWNSHIP LORAIN CO. OHIO  
Scale 1" = 30 FT. JULY 8-1950  
C.E. Penfound Registered Surveyor.