

06-24-037.104.003
6-42
SCAN # 45751

CITY TITLE Co. Order
No. E-916-17
Theodore M. & Mildred Reynolds
to Frederick Price



HICKORY LANE 50'

90°
ADELBERT
(Formerly DELBERT
I.P. 349.63'
N. 88°53'E.


STREET 60'
AVENUE)

#41985
60'

MAP OF SUB-LOT NO. 61
ORCHARD GROVE ALL'T. Vol. 6 Pg. 43
ORIG. LOT 37 WEST OF BLACK RIVER
ELYRIA TOWNSHIP
LORAIN COUNTY OHIO
SCALE: 1" = 30' NOV. 2-1969 2:30 P.M.

NOTE: There are no encroachments
on this property.

Gary E. Penfound
REG. SURVEYOR NO. 4457

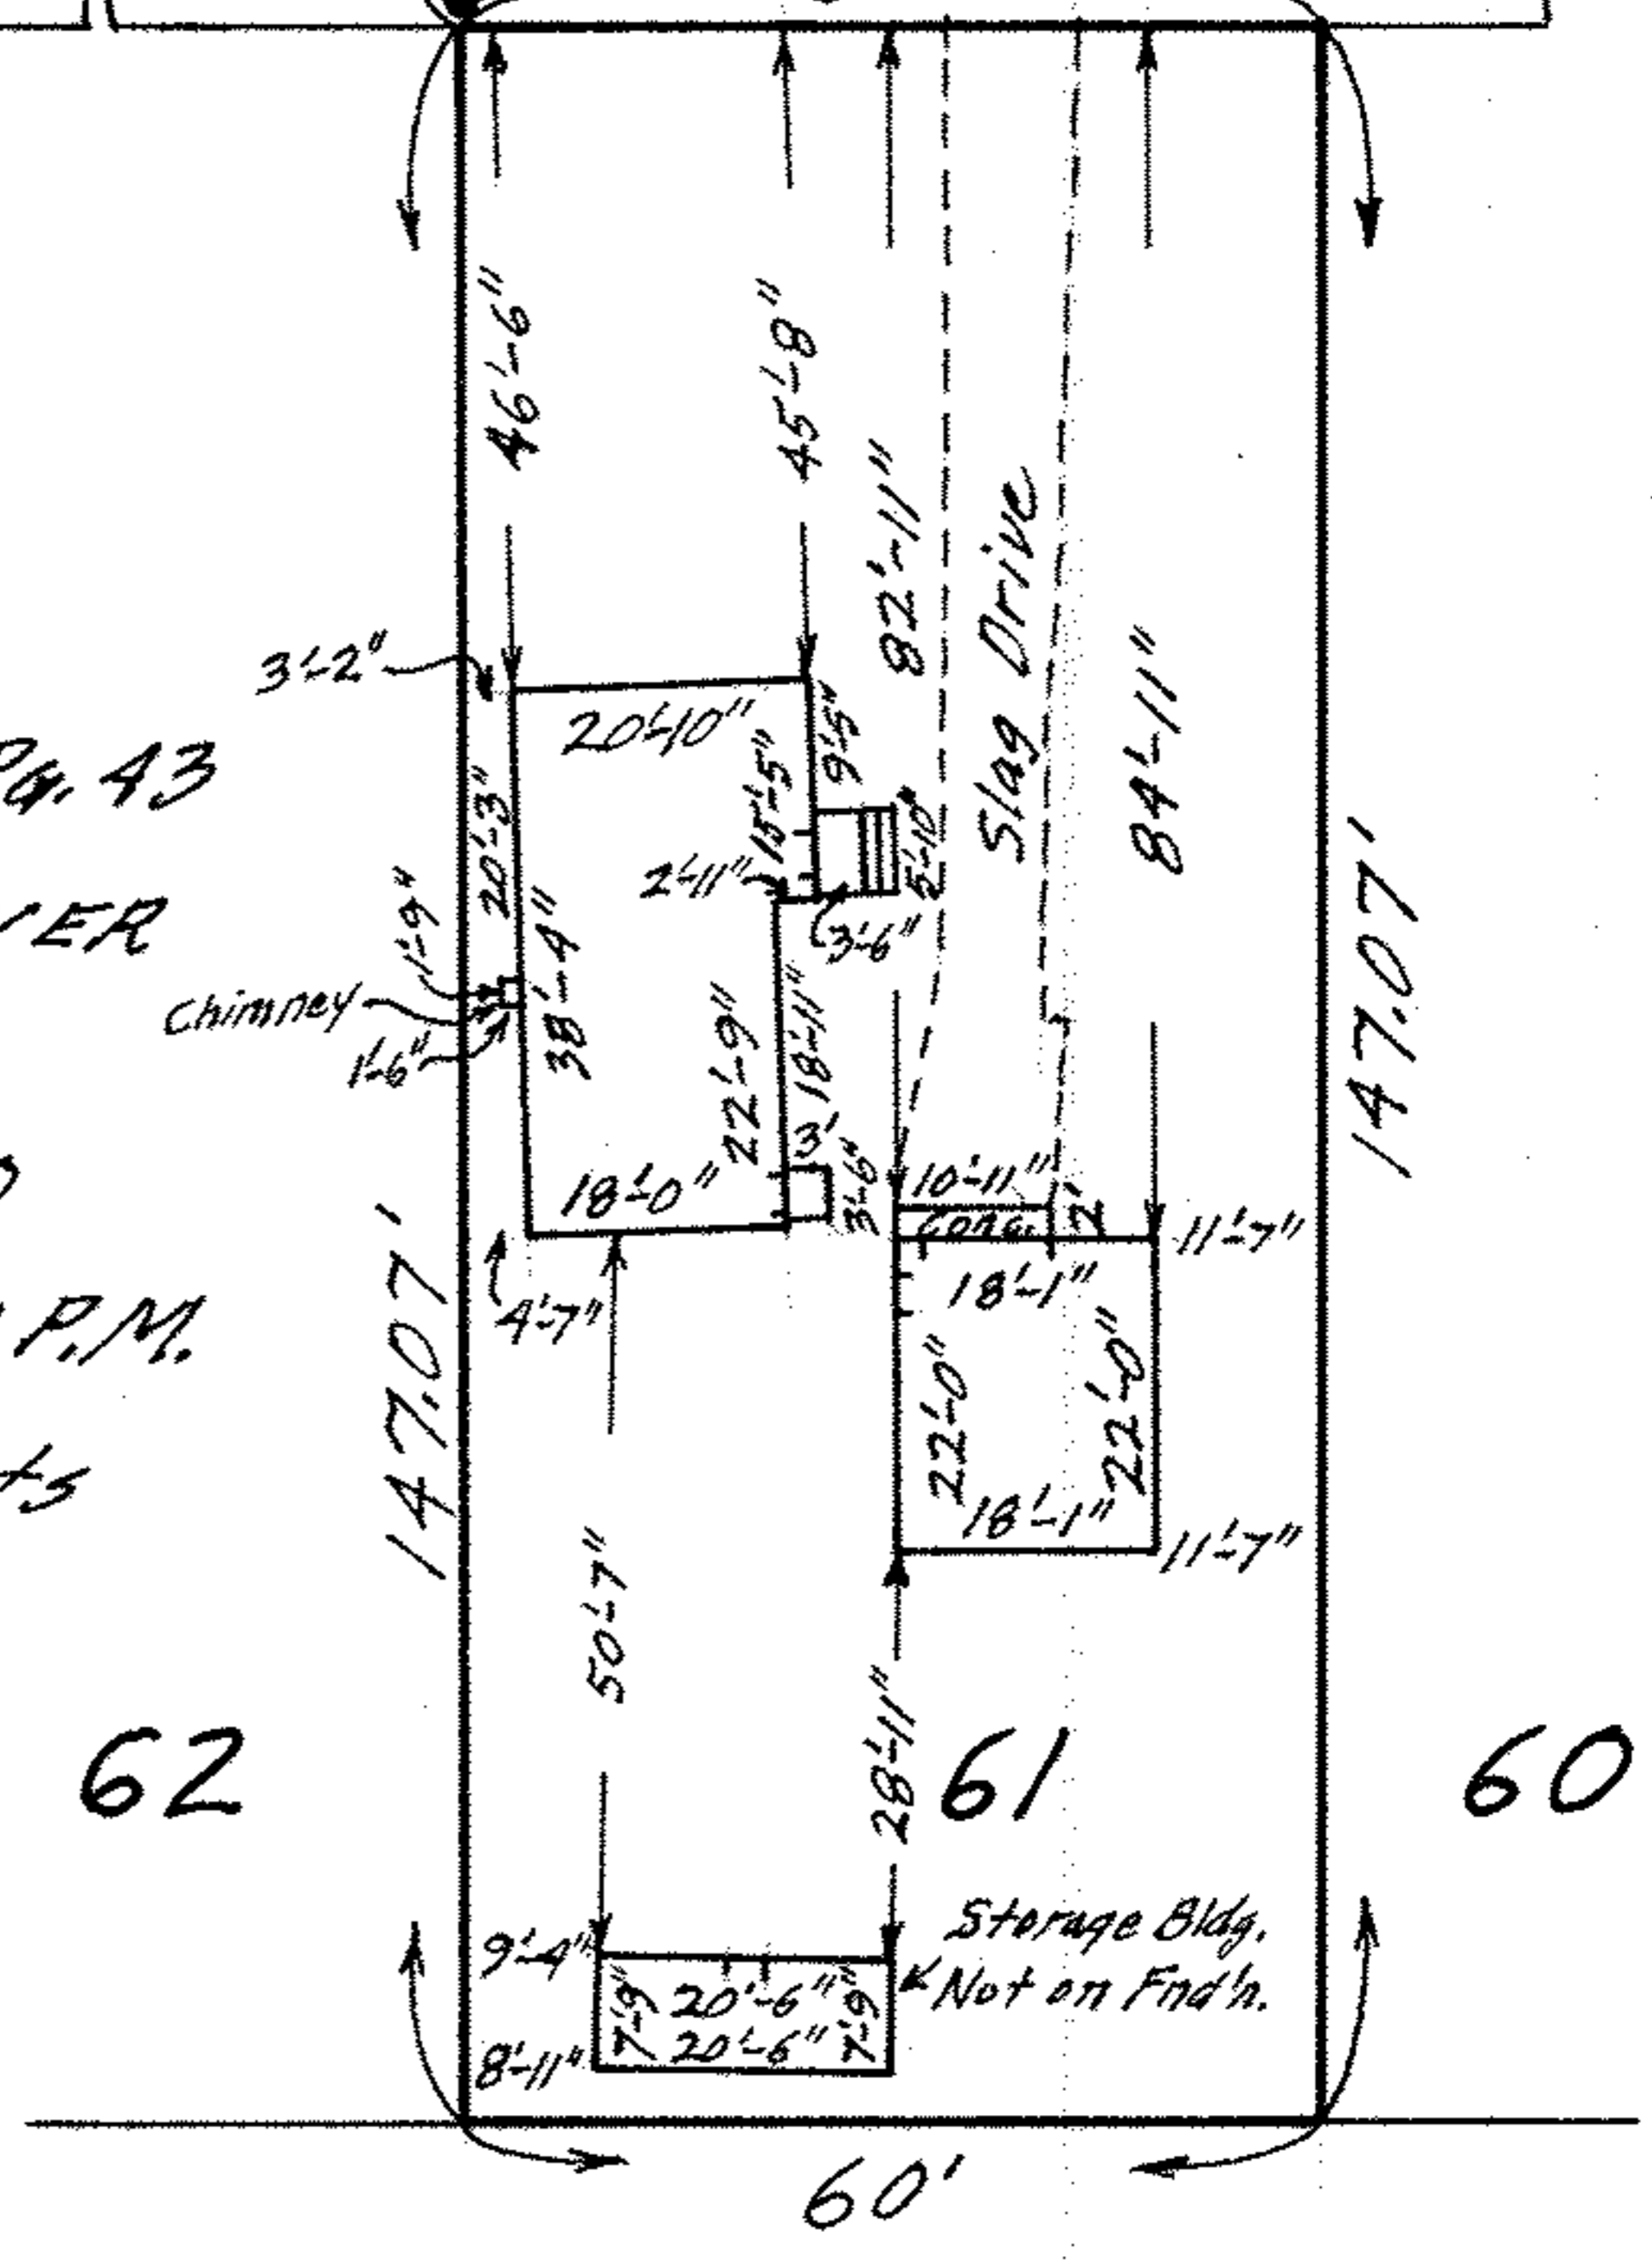

06-24-037.104.003