


28-9 010.3.01640.42.40
SCAN # 45761

JACKSON AVENUE 60'

301

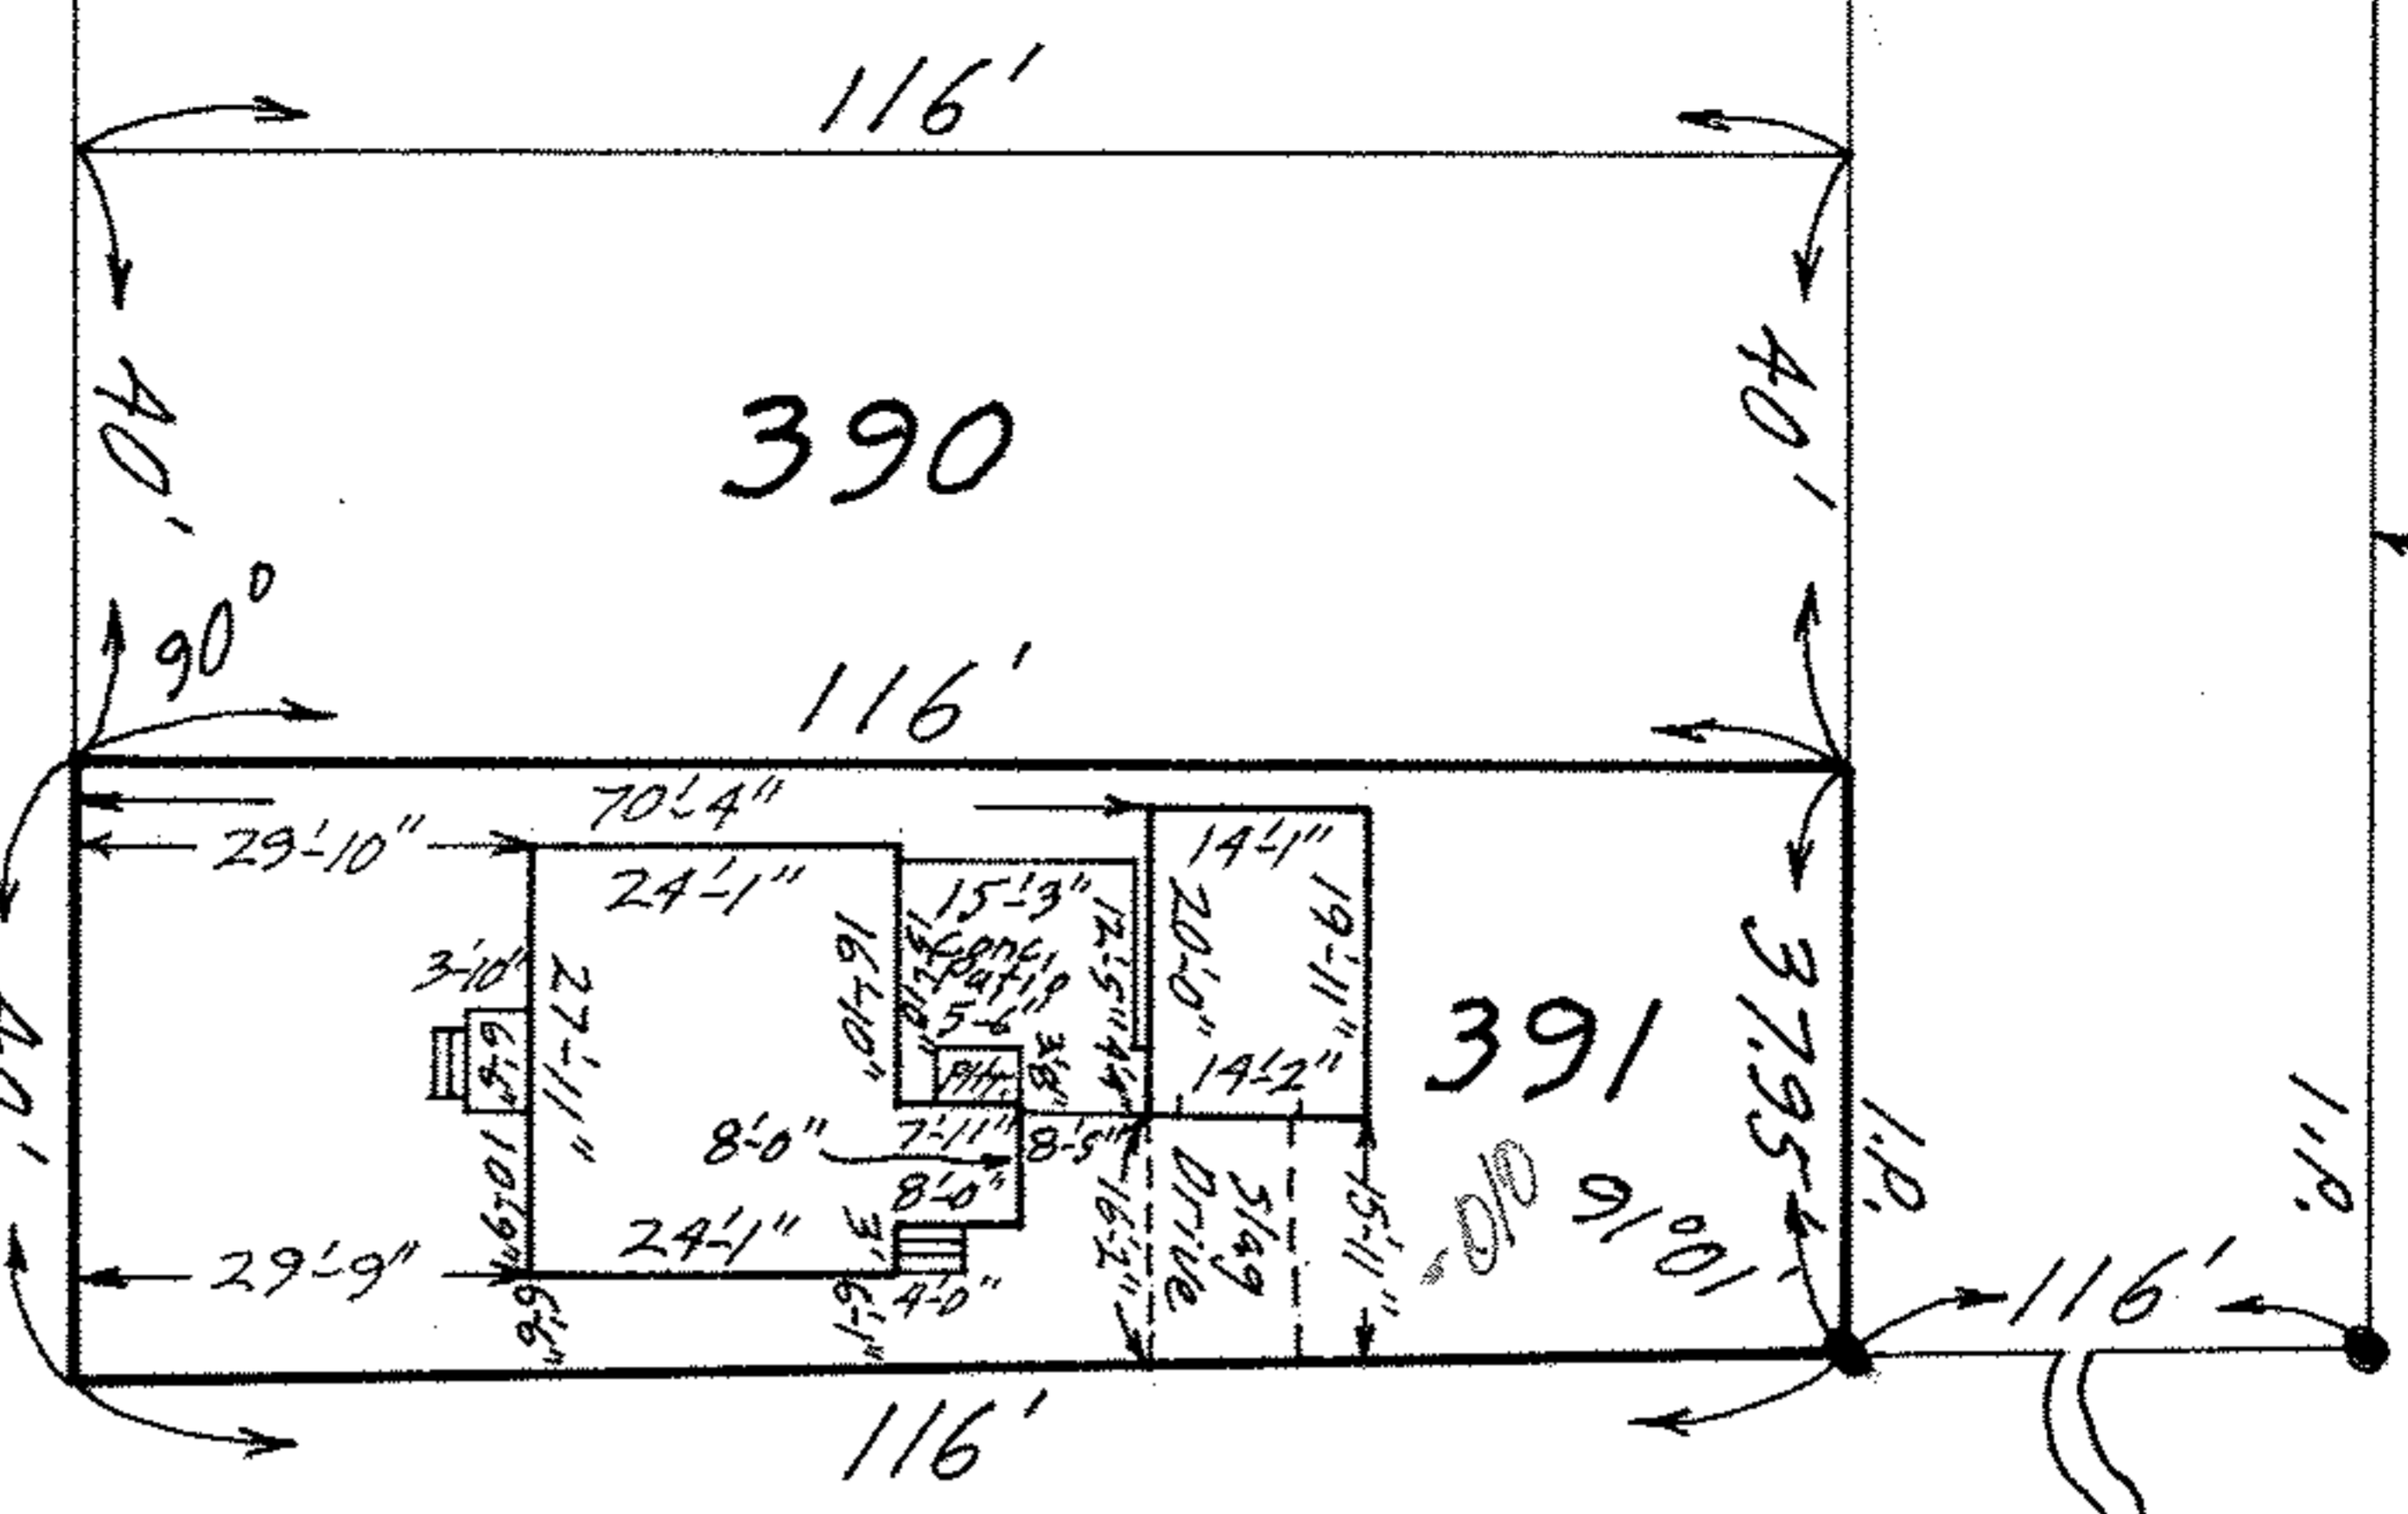

West Line GARFIELD AVENUE 60'

BOND STREET 66'

MAP OF SUB-LOT NO. 391

S. MENDELSON'S SUB'N. VOL. 7 Pg. 23

ORIG. LOTS 49 & 50 - WEST OF BLACK RIVER
ELYRIA TWP. ELYRIA CITY
LORAIN COUNTY OHIO

SCALE: 1" = 30' MAY 22-1970 7:15 P.M.

NOTE: There are no encroachments on this property.

Gary E. Penfound REG. SURVEYOR NO. 4457

CITY TITLE Co. Order No. E-1133-A

Ralph W. & Nell Muoio to
David W., Jr. & Linda K. Hawke



010.3.01640.42.40