
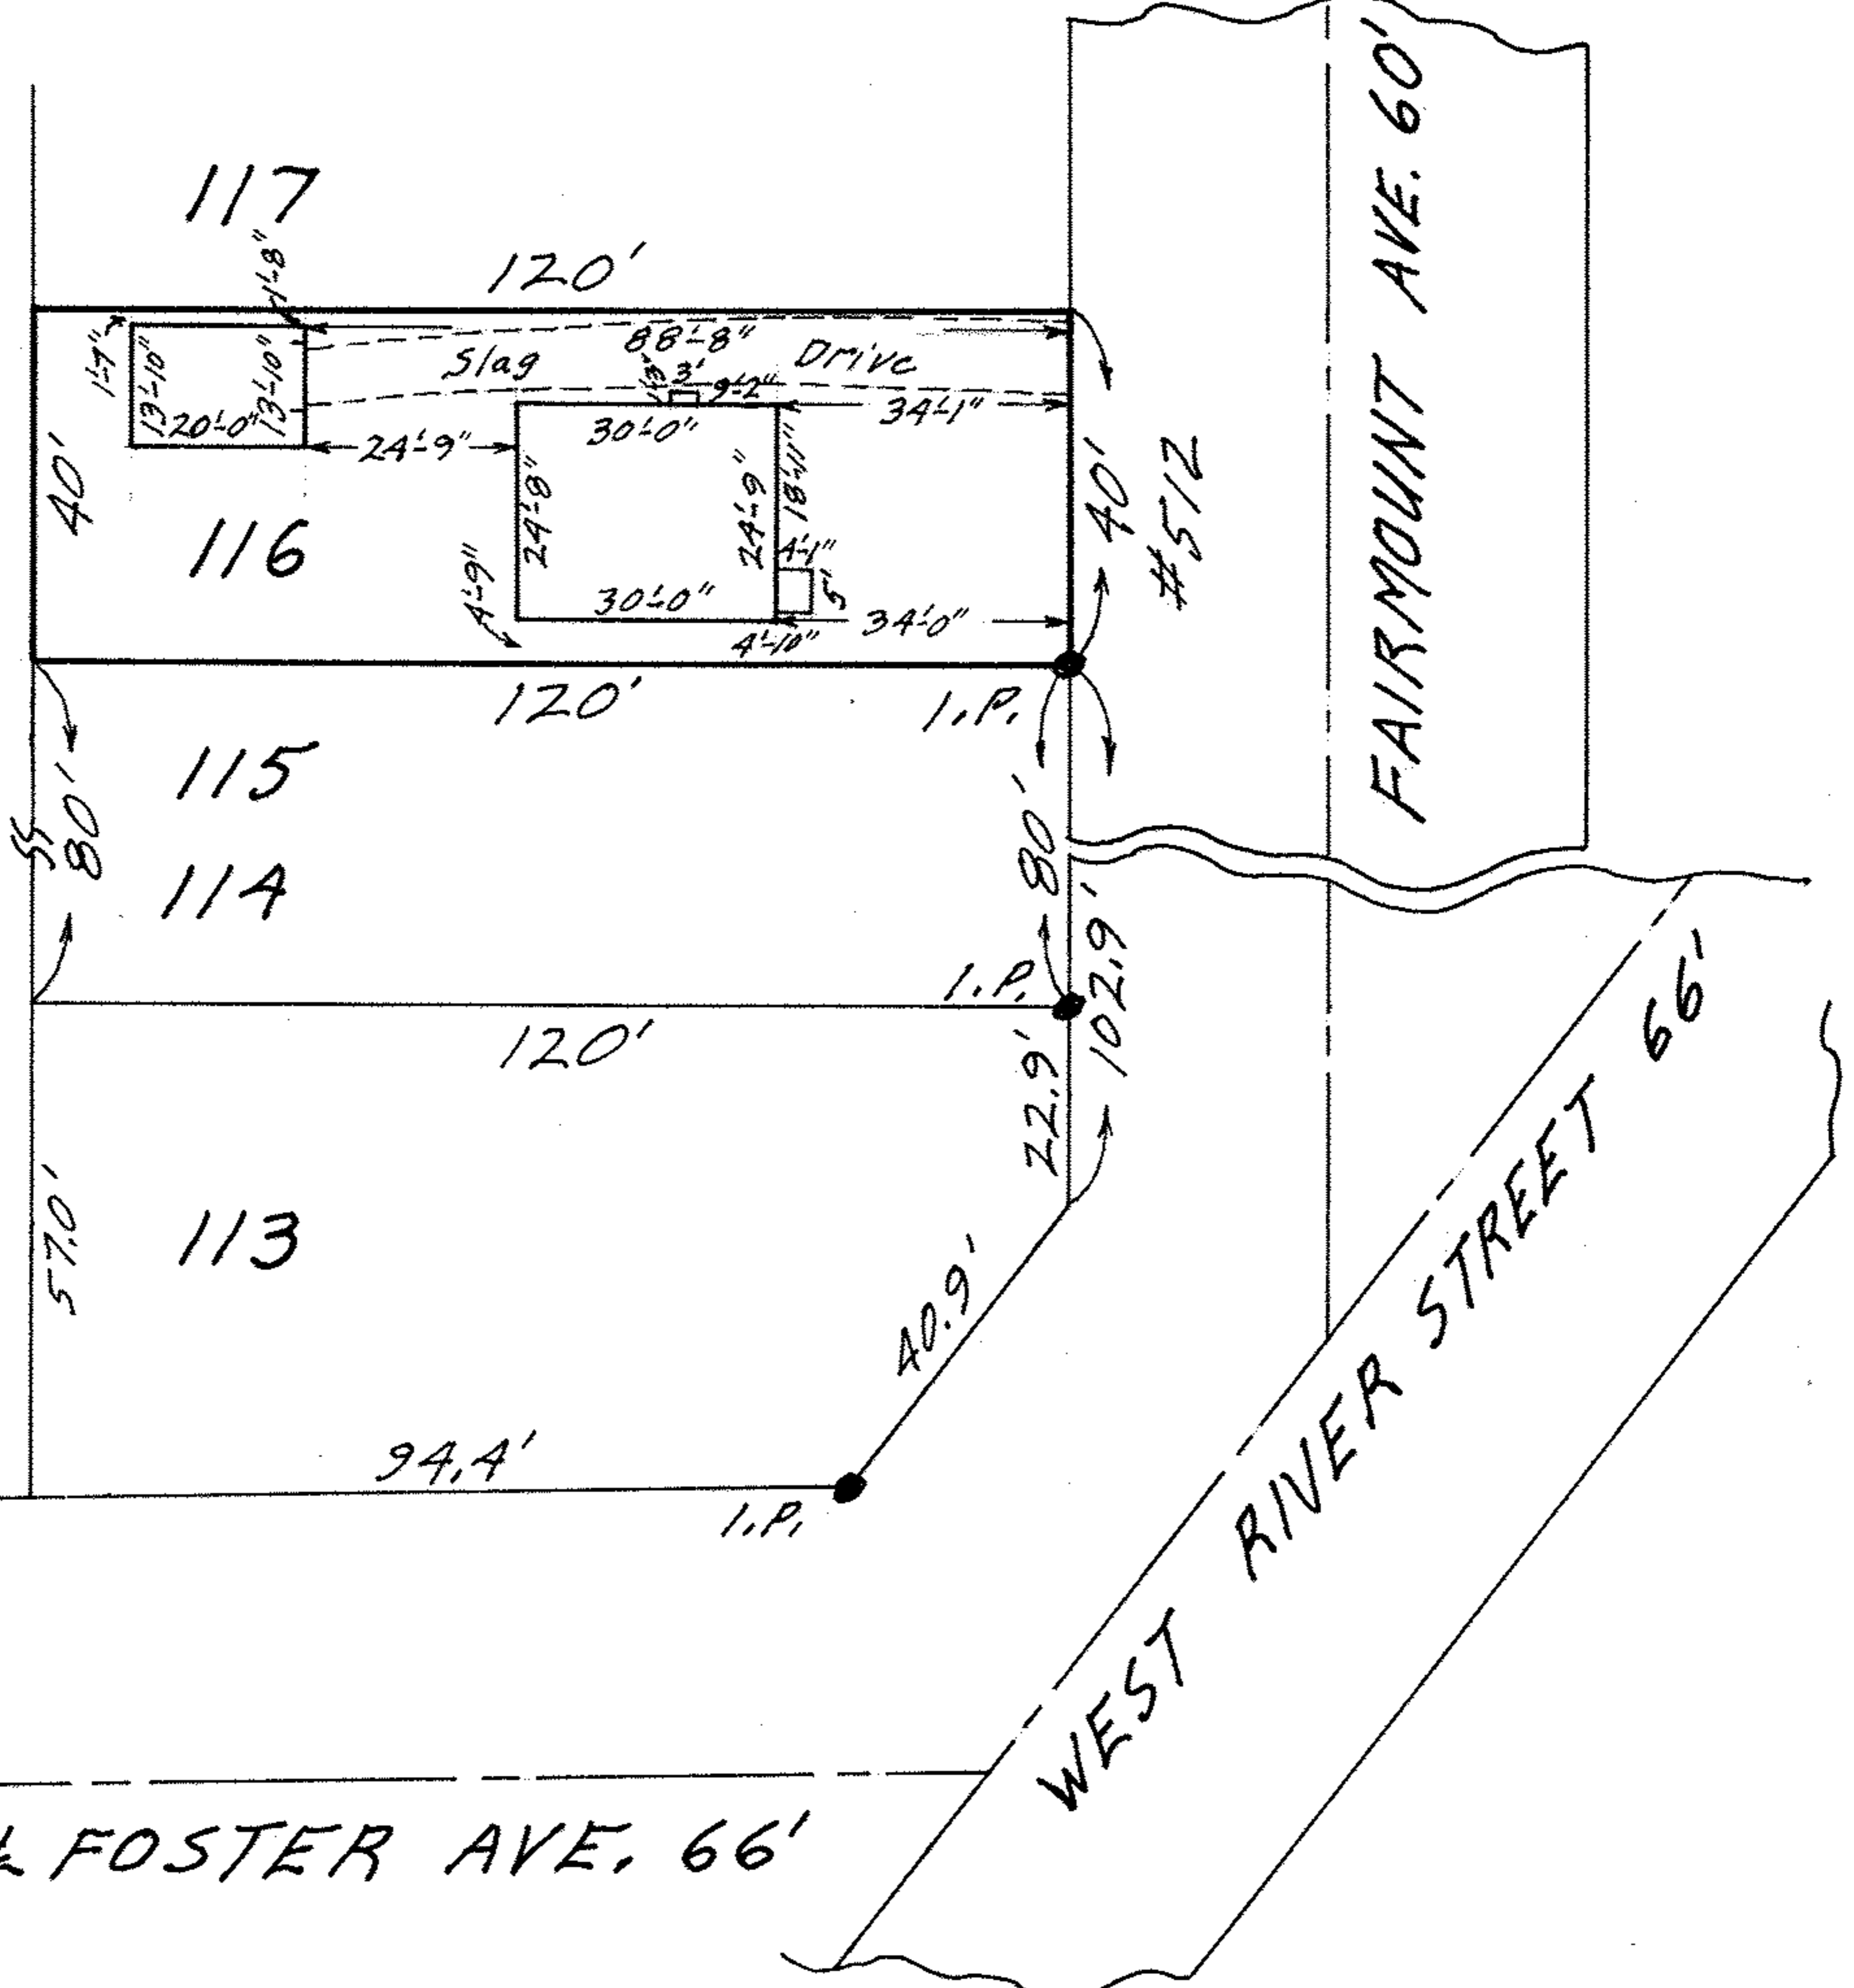


06-24-052-105-007
 6-83
 SCAN # 45764

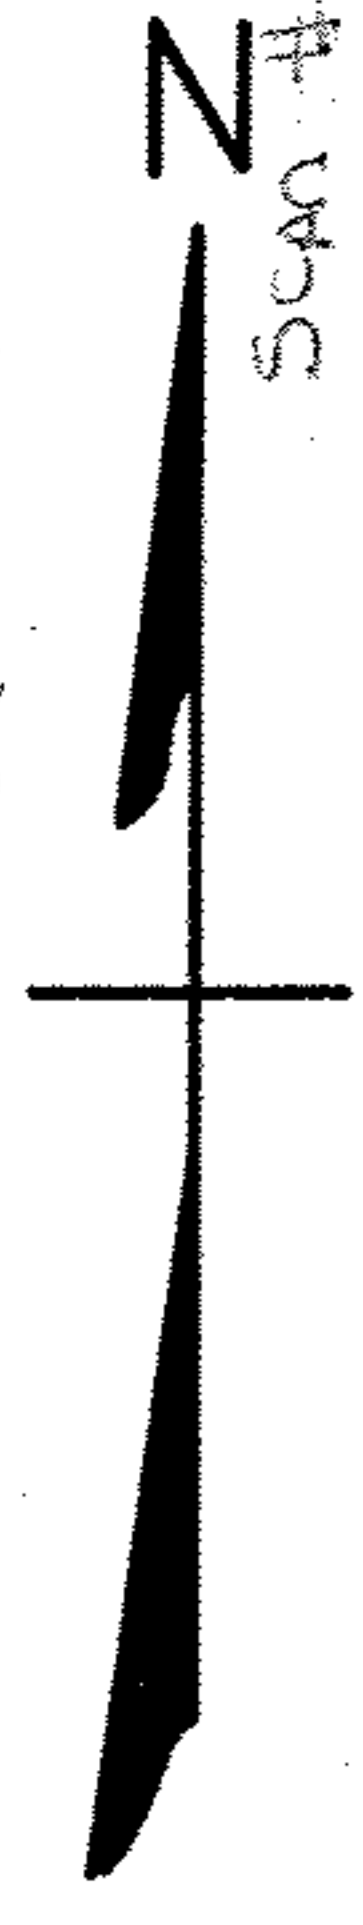

MAP OF SUB-LOT NO. 116

S. MENDELSON'S SUB'N. VOL. 7 PG. 23
 O.L. 52 WEST OF BLACK RIVER - ELYRIA TWP.
 ELYRIA CITY - LORAIN COUNTY - OHIO
 SCALE: 1" = 30' AUG. 24 - 1969 4:45 P.M.

NOTE: There are no encroachments on the above property.
 Gary E. Penfound REG. SURVEYOR NO. 4457

CITY TITLE Co. Order No. E-796-7
 Mattie R. Bates to Thomas J. Profitt