


06.24.055-103.015, 016, 018, 019
020, 036, 037, 038
039
6-82
SCM#45768

T A F T S T. 50'

66'

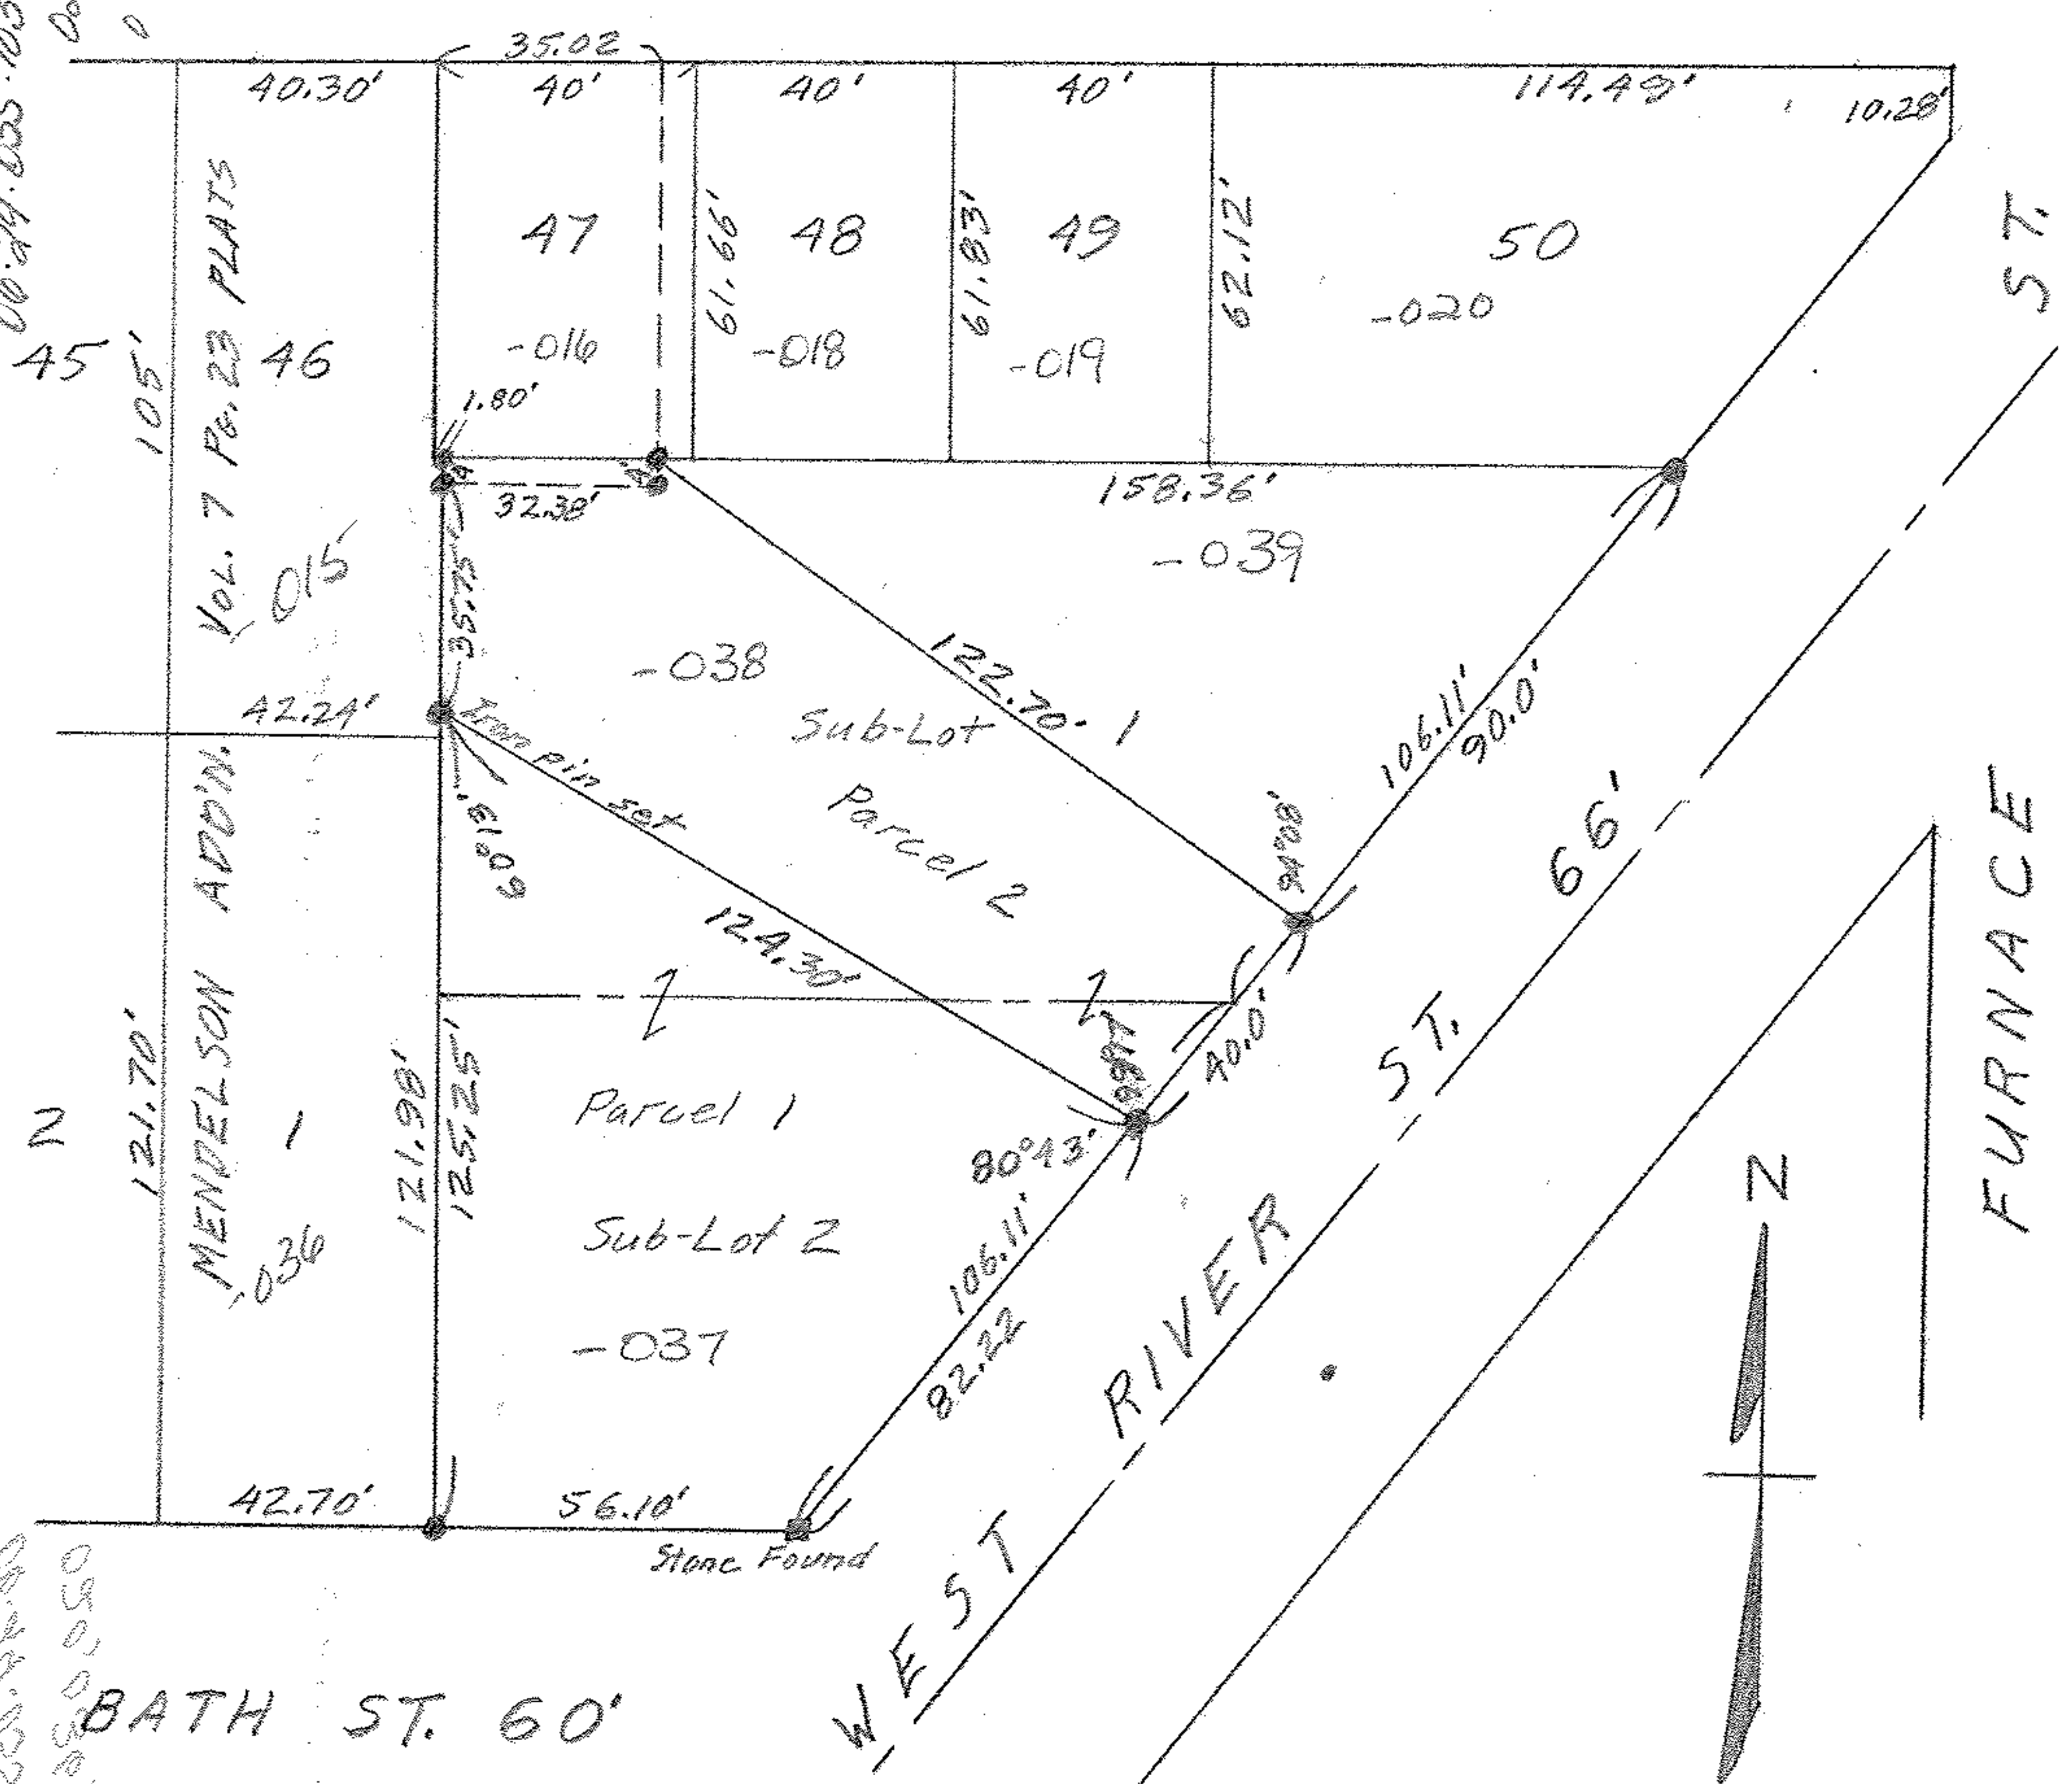

010, 011, 012, 049, 050

BATH ST. 60'

PLAT OF SURVEY FOR
RAYMOND E. & EVELYN J. CAHL
Sub-Lots 1 & 2 Ely & Pember Add'n.
Vol. 3 Pg. 26 Plat Records
Elyria City - Lorain County - Ohio
Scale: 1" = 40' Feb. 28, 1958

GARY E. PENFOUND
REGISTERED SURVEYOR NO. 4457

NOTE: ● indicates iron pin found
unless noted otherwise.