


0624-055-103-021-024
 6-8Z
 SCAN # 45769

HAYES AVE. 60'

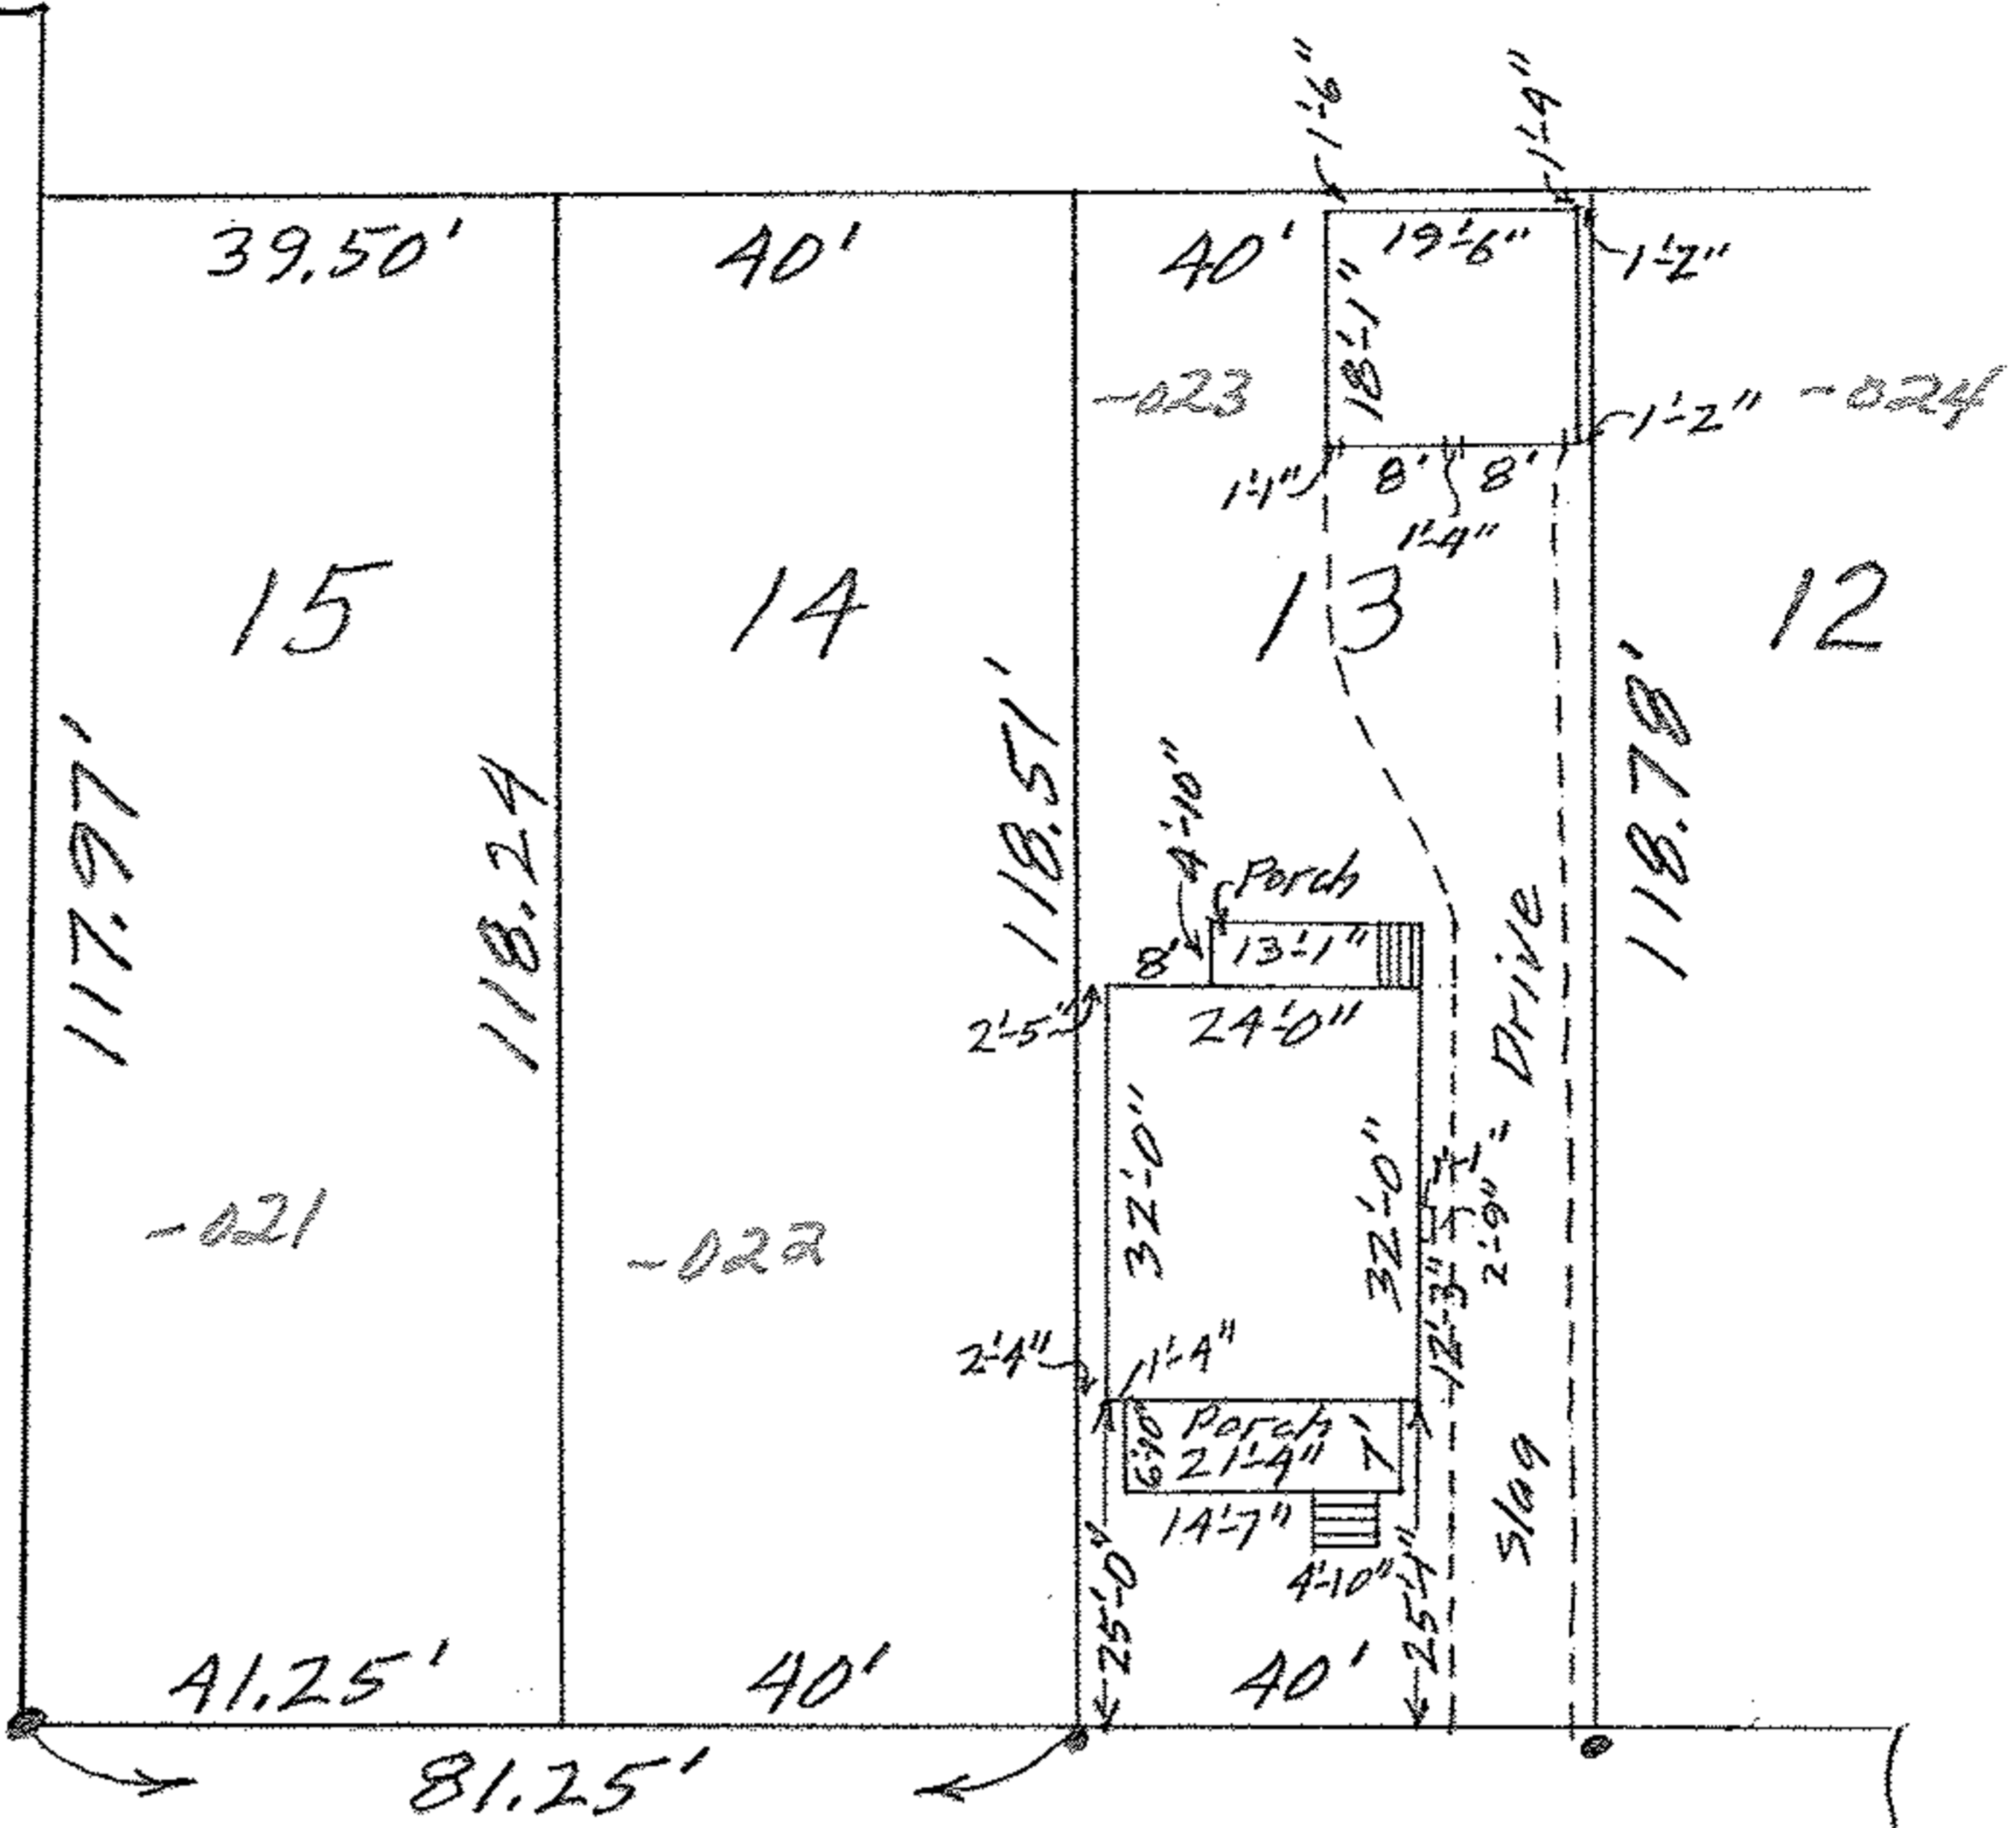

BATH ST. (HEIGHTON AVE.) 60'
 N. 88° 57' 30" E.

#141

0624-055-103-021-024


MAP OF SUB-LOT NO. 13

S. MENDELSON'S SUB'N. VOL. 7 Pgs. 23 & 24

ELYRIA CITY - LORAIN COUNTY - OHIO

SCALE: 1" = 30' MAR. 25 - 1964 12:15 P.M.

Gary E. Penfound REG. SURVEYOR

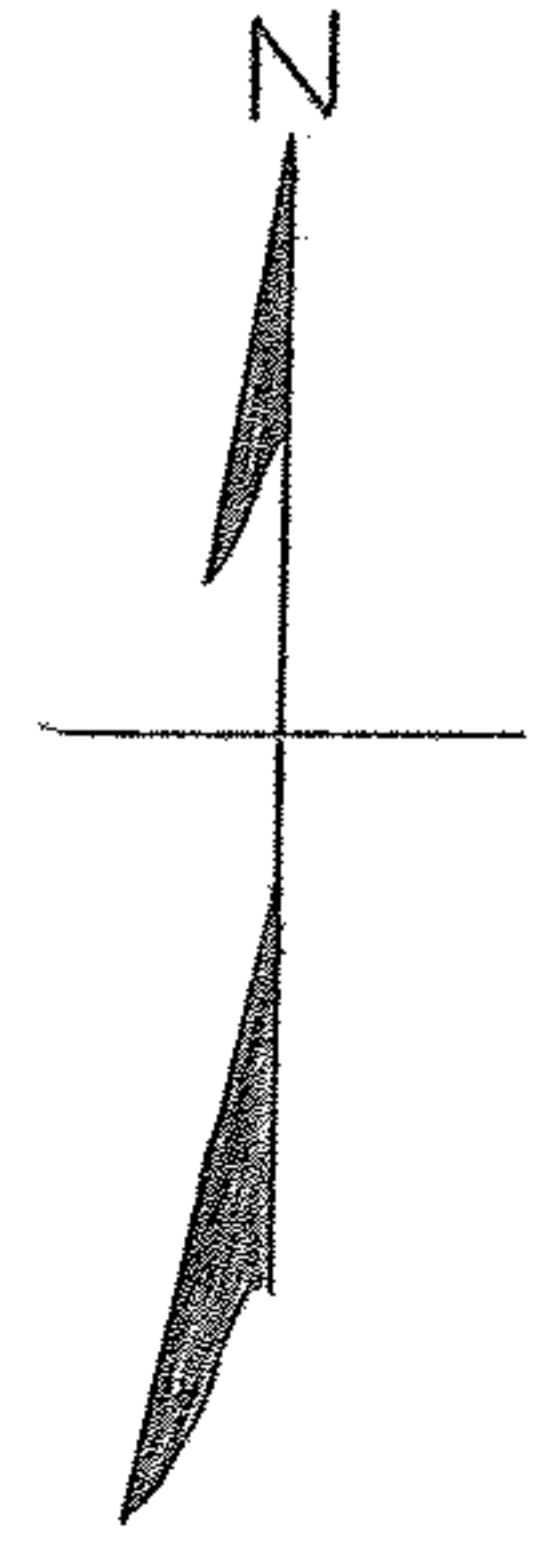

Weaver Burt & Rosetta Burt

WW