
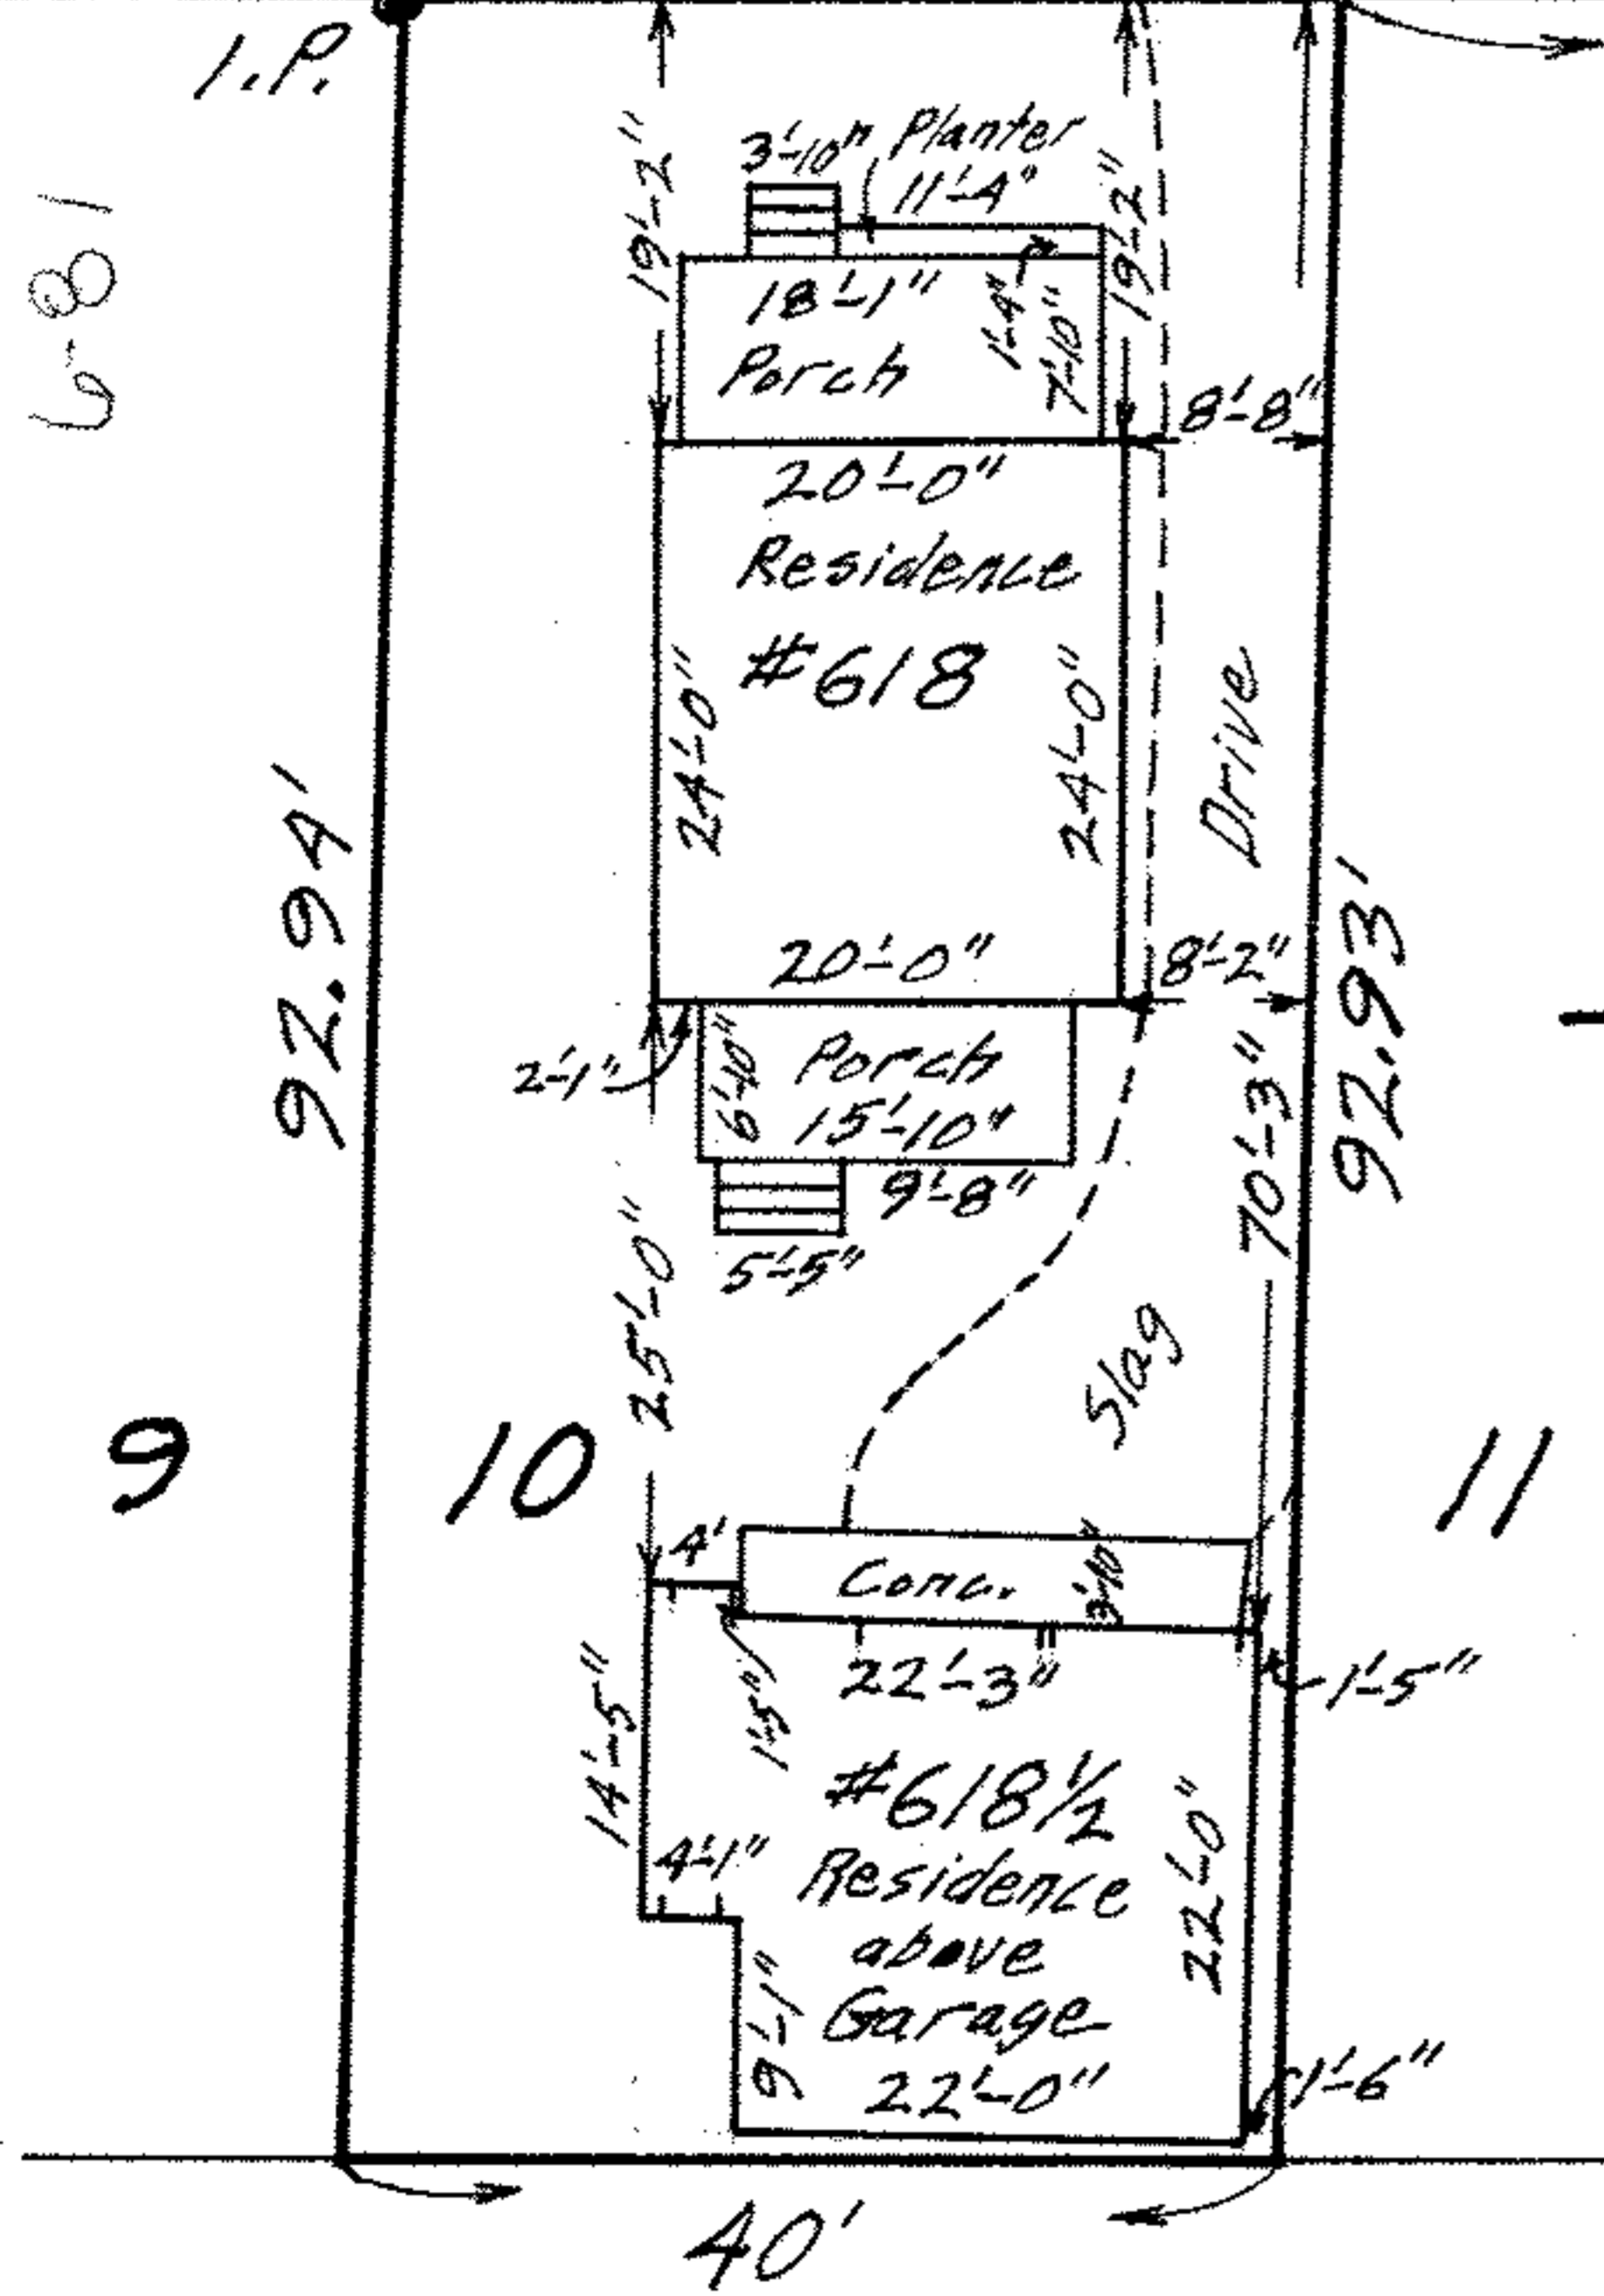


06-24-065-101-007 SCAN # 45773

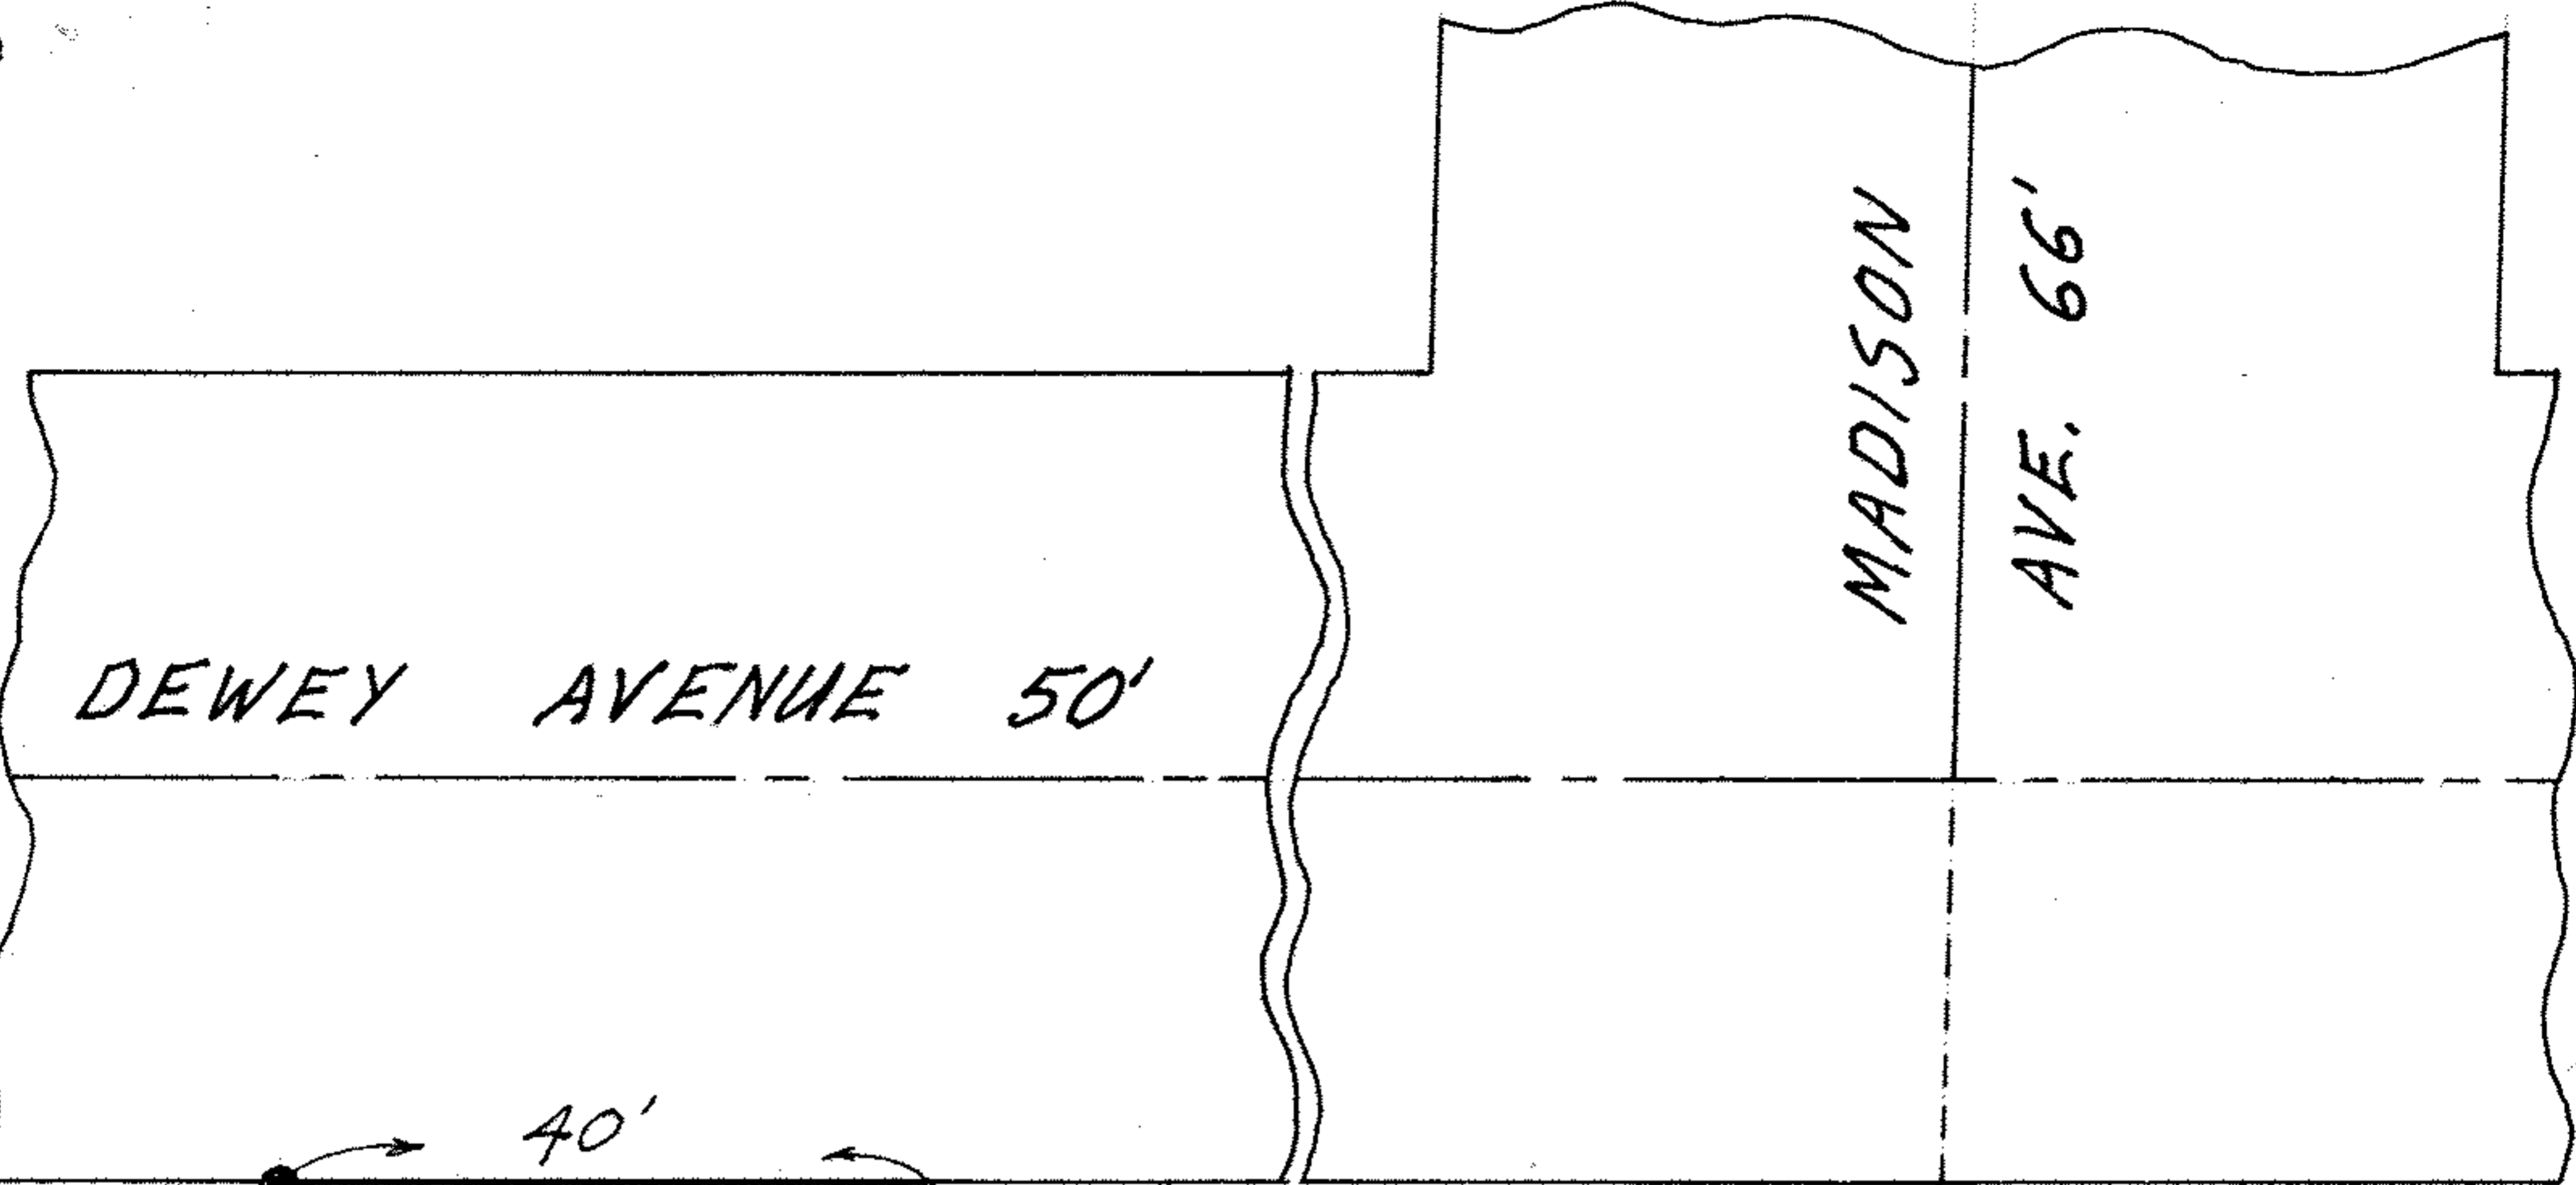

MAP OF SUB-LOT NO. 10  
 FOSTER'S SUB'N. Vol. 5 Pg. 7  
 ORIG. LOT 65 - WEST OF BLACK  
 RIVER - ELYRIA TOWNSHIP  
 ELYRIA CITY  
 LORAIN COUNTY - OHIO  
 SCALE: 1" = 20' OCT. 23-1969 3:30 P.M.  
 NOTE: There are no encroachments  
 on this property.  
 Gary E. Penfound  
 REG. SURVEYOR NO. 4457

CITY TITLE Co. Order No. E-903-A  
 Robert E. & Sue Bernhke to  
 Delmas Paul Hickman & Burlee J. Hickman